



SECTION C-C
(SCALE = 1:20)

RCC DETAIL OF COLUMN
MKD C2,C3,C3A,C4 & C6

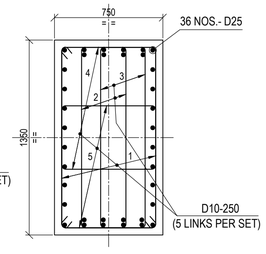


SECTION C-C
(SCALE = 1:20)

RCC DETAIL OF COLUMN MKD C1

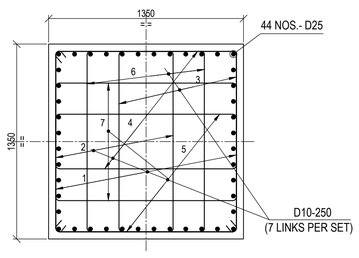


SECTION C-C
(SCALE = 1:20)

RCC DETAIL OF COLUMN MKD C5,C5A,C7 & C7A

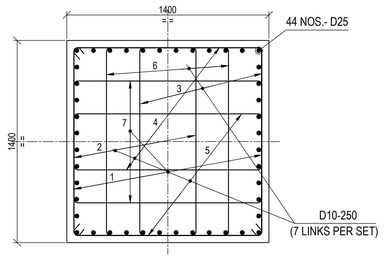


SECTION C-C
(SCALE = 1:20)


RCC DETAIL OF COLUMN MKD C5B

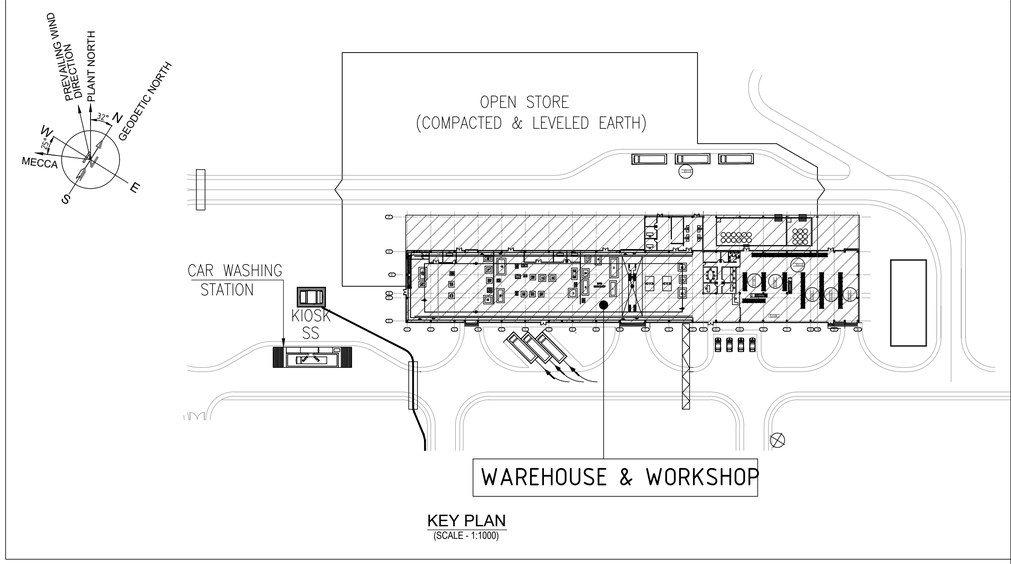

KEY PLAN
(SCALE - 1:1000)

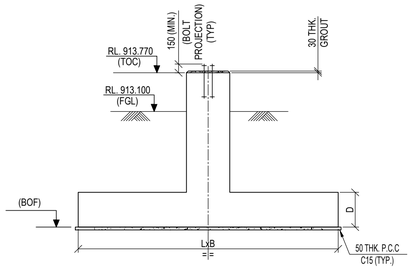


SECTION A-A
(SCALE - 1:50)

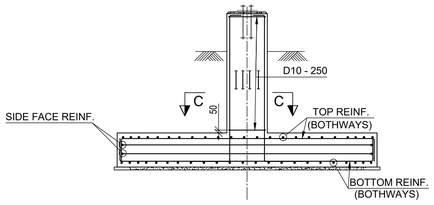


SECTION B-B
(SCALE - 1:50)

SCHEDULE OF FOOTING

TYPE	SIZE (LxB)	DEPTH (D)	BOTTOM REINFORCEMENT	TOP REINFORCEMENT	SIDE FACE REINFORCEMENT	BOTTOM OF FOUNDATION
F1	6000X4500	600	T16@175 BOTHWAYS	T12@200 BOTHWAYS	–	RL 911.100
F2	3000X3000	400	T12@175 BOTHWAYS	T10@250 BOTHWAYS	–	RL 911.100
F3	2500X2500	400	T12@175 BOTHWAYS	T10@250 BOTHWAYS	–	RL 911.100
F4	2200X2200	400	T12@175 BOTHWAYS	T10@250 BOTHWAYS	–	RL 911.100
F5	6000X6000	750	T25@150 BOTHWAYS	T12@150 BOTHWAYS	2–T12	RL 911.100
F6	2000X2000	400	T16@200 BOTHWAYS	T10@250 BOTHWAYS	–	RL 911.100
F7	8000X8000	750	T25@200 BOTHWAYS	T12@150 BOTHWAYS	2–T12	RL 911.100
F3A	2500X2500	400	T12@175 BOTHWAYS	T10@250 BOTHWAYS	–	RL 911.900

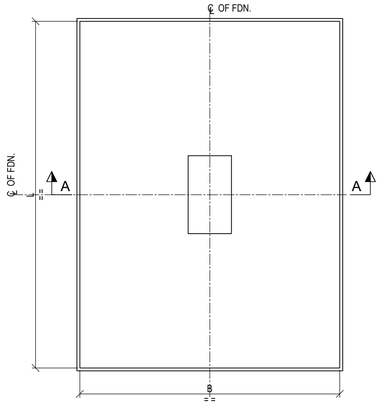

TYP. DETAIL OF FOUNDATION
(SCALE - 1:50)

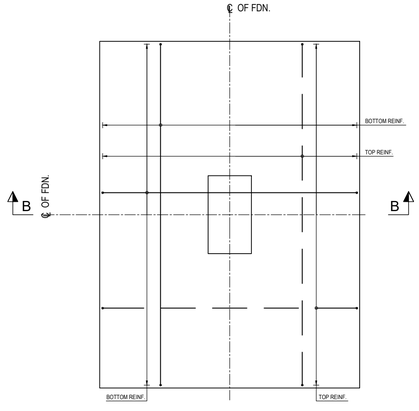

TYP. RCC DETAIL OF FOUNDATION
(SCALE - 1:50)

LEGENDS :

TOC - TOP OF CONCRETE
RL- REDUCED LEVEL
TYP - TYPICAL
PCC - PLAIN CEMENT CONCRETE
MKD - MARKED
COL - COLUMN
FGL - FINISHED GROUND LEVEL
BOF - BOTTOM OF FOUNDATION
℄ - CENTRE LINE
RCC - REINFORCED CEMENT CONCRETE
DRG. - DRAWING
NO. - NUMBER
THK - THICK
REINF. - REINFORCEMENT
FDN. - FOUNDATION
MIN. - MINIMUM
BOTTOM REBAR (B) - ————————
TOP REBAR (T) - — — — — — —

NOTES :-

1. ALL DIMENSIONS ARE IN MILLIMETRES AND LEVELS AND CO-ORDINATES ARE IN METRES UNLESS OTHERWISE STATED.
2. FOR OTHER NOTES REFER DRG. NO. MD-216-4000-EG-CV-1058.
3. THIS DRAWING IS TO BE READ IN CONJUNCTION WITH DRG. NO. MD-216-4000-EG-CV-GAD-1058 & 1059.
4. FOR DETAILS OF ANCHOR BOLTS REFER DRG. NO. MD-P20131-B01-A001 & MD-P20131-B01A002.

DOCUMENT NUMBER	REFERENCE DOCUMENTS	REV	DATE	REVISION DESCRIPTION	DRN	CHK	ENG	APP	EMP
		D01	22/02/2023	AS-BUILT	DSR	SJM	MMJ	AG	
MD-216-4000-EG-AR-GAD-3005	BUILDING ELEVATIONS & SECTIONS	C02	19/08/2020	ISSUED FOR CONSTRUCTION AND REVISED AS MKD. (C02)	DSR	SJM	MMJ	AG	
MD-216-4000-EG-AR-GAD-3004	ROOF & FALSE CEILING PLANS	C01	29/06/2020	ISSUED FOR CONSTRUCTION AND REVISED AS MKD. (C01)	DSR	SJM	MMJ	AG	
MD-216-4000-EG-AR-GAD-3003	BUILDING PLANS & SCHEDULES OF FINISHES	A01	30/05/2020	ISSUED FOR REFERENCE	DSR	SJM	MMJ	AG	

RESERVED FOR VENDOR LOGO AND DRAWING NUMBER

LARSEN & TOUBRO

This drawing is the property of LARSEN & TOUBRO and must not be passed on to any person or body not authorized by us to receive it nor be copied or otherwise made use either in full or in part by such person or body without our prior permission in writing.

Outotec

The content of these documents are the sole property of Outotec Oyj. Any rights not expressly granted herein are reserved. Reproduction, transfer or distribution of part or all of the contents in any form without prior written permission of Outotec is prohibited.

MA'ADEN معادن
Saudi Arabian Mining Company شركة التعدين العربية السعودية

This document and the information contained herein is Ma'aden proprietary know-how. This document or any part thereof should not be reproduced, stored in a retrieval system or transmitted by any means, electronic or otherwise, or divulged without prior written permission of Ma'aden.

LARSEN & TOUBRO DRAWING NUMBER: 019045_501_C_D_24024_003 — REVISION: 3
OUTOTEC DRAWING NUMBER: 900707__GAU01__AN03__CTB17__40011 — DOCUMENT ID: OU100687710 — REVISION: 3

DRAWN	DSR	28/05/2020
CHECKED	SJM	29/05/2020
ENGINEER	MMJ	28/05/2020
APPROVED	AG	30/05/2020
EMPLOYER		
SCALE	1:50,25	A1

MANSOURAH - MASSARAH GOLD PROJECT
DETAIL DRAWING
PROCESS PLANT-WAREHOUSE & WORKSHOP
RC DETAILS

DRAWING NUMBER: MD-216-4000-EG-CV-DED-1060 — REV: D01