


DRAWING NUMBER MD-216-4000-EG-CV-DED-1061 REV D01

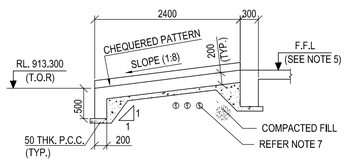


SECTION A-A
SECTION A'-A' (OPPOSITE HAND)
SCALE 1:50

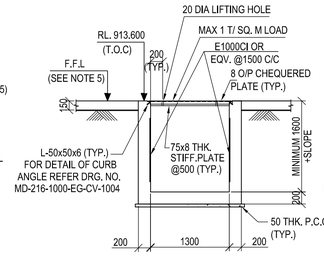

SECTION C-C
SCALE 1:50

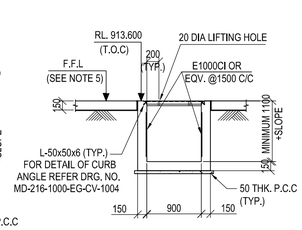

SECTION D-D
SCALE 1:50

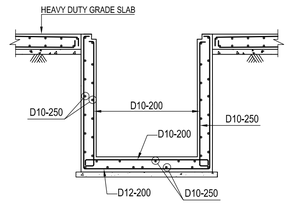

SECTION D-D
(R.C DETAIL)
SCALE 1:30


TABLE-1
(REFER DRAWING MD-216-4000-EG-ME-GAD-1001)

EQPT. TAG NO.	FDN. TYPE	FDN . DIM. (AxB) mm	D mm
1	II	5890X2125	400
2	II	5050X1750	400
3	II	4120X1760	400
4	I	1180x1600	300
5	I	2250x1320	300
6	II	2280X1310	800
7	I	1750X1200	300
8	*	1600X1100	-
9	I	2250X1450	300
10	*	800X1100	-
11	*	1170X990	-
12	II	3900X5600	600
13	II	11100X4600	600
14	I	1900X1550	300
17	*	1950X1300	-
20	I	2600X2500	300
21	I	2100X1700	300
22	I	3000X2750	300
23	*	1400x1400	-


EQPT. TAG NO.	FDN. TYPE	FDN. DIM. (AxB) mm	D mm
27	*	1760X1100	-
28	II	5020X2725	700
29	I	1500X1100	300
30	I	1870X1500	400
31	*	1720X1315	-
33	*	995X865	-
34	II	1925X1900	500
35	I	1350X1000	400
44	*	1800X1200	-
47	*	1070X825	-
48	I	1650X1650	400
49	*	1150X1860	-

* EQUIPMENT DIRECTLY SUPPORTED ON GRADE SLAB
II ISOLATED FROM GRADE SLAB
I MONOLITHIC WITH GRADE SLAB


NOTE- EQPT. TAG NO. 15,16, 18, 19, 24, 26, 32, 36, 37, 38, 39, 40, 41, 42, 43, 45 & 46, ARE LOOSELY MOUNTED ON GRADE SLAB, NO ANCHORING IS REQUIRED. PLEASE REFER MECHANICAL DRAWING NO. MD-216-4000-EG-ME-GAD-1001 FOR LOCATION OF THESE EQUIPMENT.

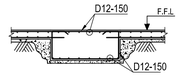


SECTION Y-Y
(R.C DETAIL)
SCALE 1:50

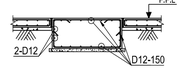


SECTION X-X
(R.C DETAIL)
SCALE 1:50

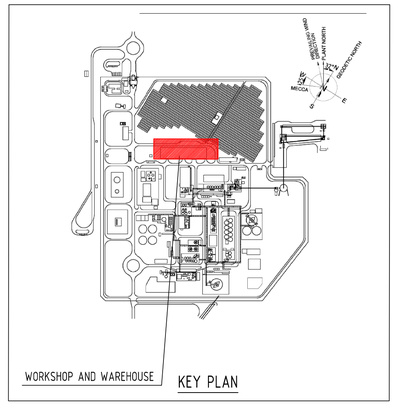


KEY PLAN

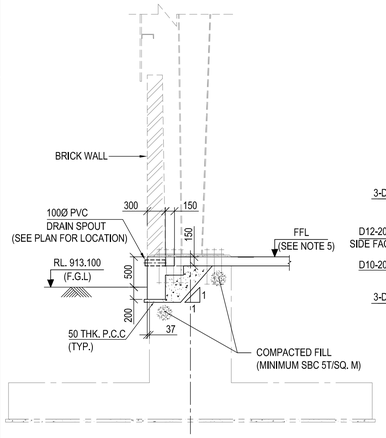


SECTION B-B
SCALE 1:50

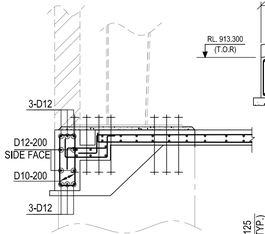


SECTION B-B
(R.C DETAIL)
SCALE 1:30

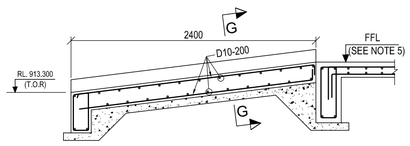


SECTION A-A
SECTION A'-A' (OPPOSITE HAND)
(R.C DETAIL)
SCALE 1:30

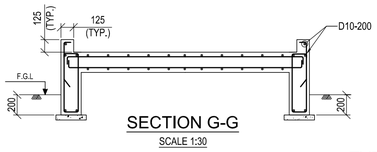


SECTION G-G
SCALE 1:30

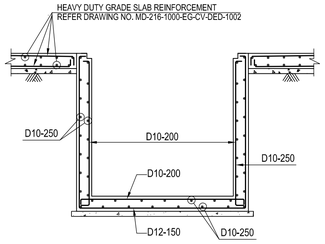

SECTION C-C
(R.C DETAIL)
SCALE 1:30

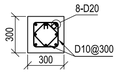


TYP. SECTION OF SC-1
SCALE 1:25
(RC DETAILS)

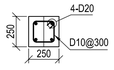

TYP. SECTION OF SC-2
SCALE 1:25
(RC DETAILS)




SECTION Y1-Y1
SCALE 1:50

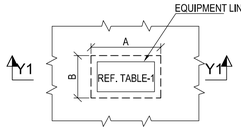


TYP. DETAIL OF EQUIPMENT FOUNDATION
(TYPE-I: MONOLITHIC WITH GRADE SLAB)
SCALE 1:50 (REFER NOTE-8)


SECTION X-X
SCALE 1:50

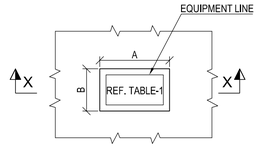


TYP. DETAIL OF EQUIPMENT FOUNDATION
(TYPE-II : ISOLATED FROM GRADE SLAB)
SCALE 1:50 (REFER NOTE-8)

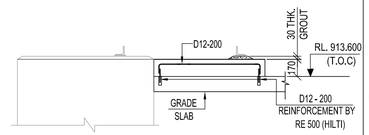


TYP. DETAILS OF PEDESTAL MKD. P1
SCALE 1:30

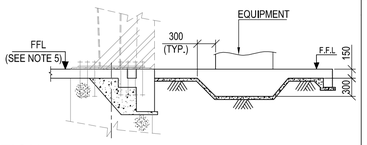


SECTION Y-Y
SCALE 1:50

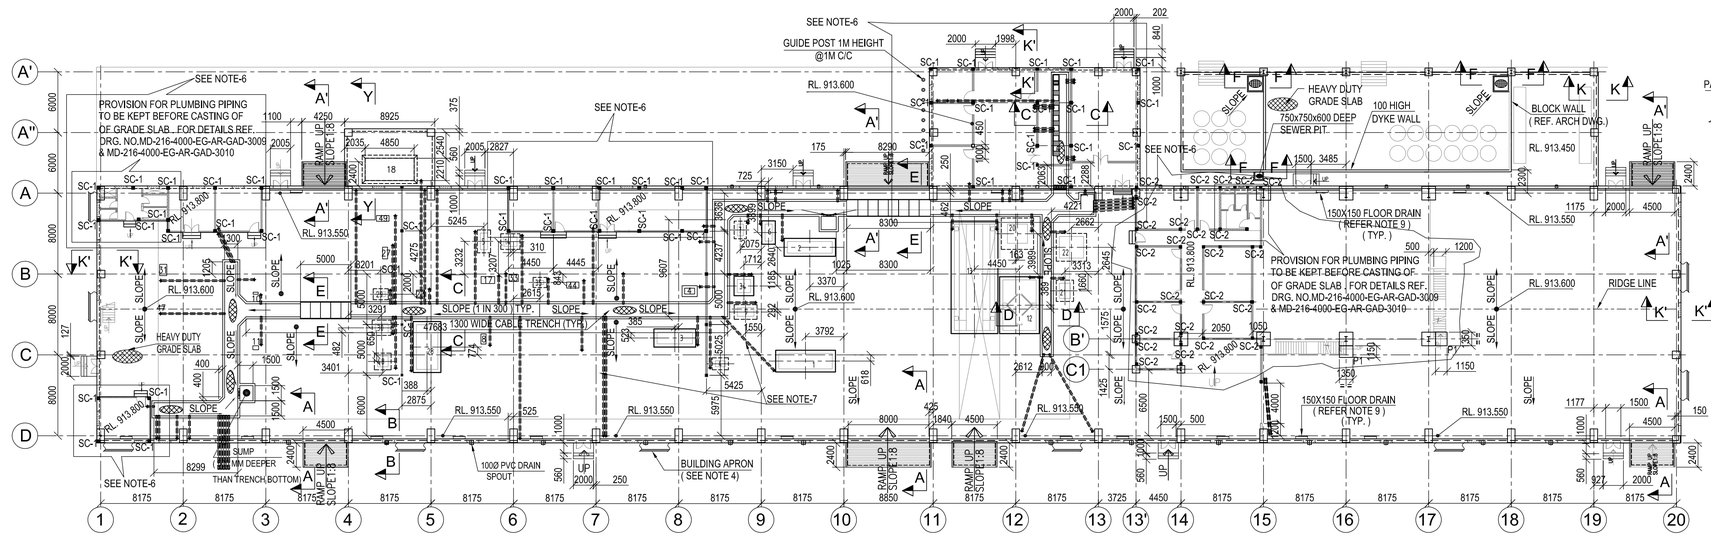


LAYOUT OF GRADE SLAB FOR WAREHOUSE & WORKSHOP
SCALE 1:300

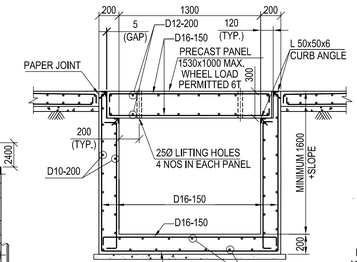

SECTION E-E
(R.C DETAIL)
SCALE 1:30

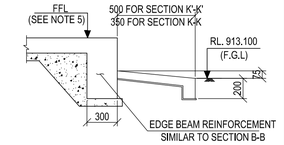

SECTION K-K, K'-K'
SCALE 1:30

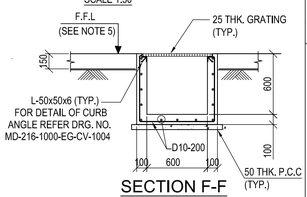

SECTION F-F
(R.C DETAIL)
SCALE 1:30

LEGEND :-
F.G.L - FINISHED GROUND LEVEL
R.L. - REDUCED LEVEL
I.L - INVERT LEVEL
THK. - THICK
T.O.C - TOP OF CONCRETE
P.C.C - PLAIN CEMENT CONCRETE
R.C - REINFORCED CONCRETE
CHQD. - CHEQUERED PLATE
STIFF. - STIFFENER
SC - STUB COLUMN
EQV. - EQUIVALENT
SBC. - SAFE BEARING CAPACITY
FFL - FINISHED FLOOR LEVEL
FDN - FOUNDATION
EQPT. - EQUIPMENT
DIM. - DIMENSION
T.O.R - TOP OF ROAD

NOTES:-
1. ALL DIMENSIONS ARE IN MILLIMETRES AND LEVELS AND CO-ORDINATES ARE IN METRES UNLESS OTHERWISE STATED.
2. FOR DETAILS OF GRADE SLAB REFER DRAWING NO. MD-216-1000-EG-CV-DED-1002. AND FOR STANDARD NOTES REFER DRAWING NO MD-216-1000-EG-CV-DED-1001
3. EQUIPMENT MOUNTING / ANCHORING DETAILS SHALL BE FURNISHED LATER .
4. DETAILS OF BUILDING APRON SHALL BE FURNISHED IN SEPARATE DRAWING .
5. FOR FFL REFER PLAN .
6. FOR DETAILS OF MISCELLANEOUS ROOMS REFER DRAWING. MD-216-4000-EG-CV-GAD-1102 & 1103
7. FOR ELECTRICAL CONDUIT BANK REFER DRAWING NO.MD-216-4000-EG-CV-GAD-1104 & MD-216-4000-EG-EL-LAD-1041
8. FOR LOCATION OF FOUNDATION REFER DRAWING MD-216-4000-EG-ME-GAD-1001
9. 150X150 FLOOR DRAINS SHALL BE BETWEEN TWO ADJACENT BUILDING COLUMNS ALONG ROWS A & D EXCEPT AT MISCELLANEOUS ROOMS AND ROLLING SHUTTER LOCATION.

DOCUMENT NUMBER	REFERENCE DOCUMENTS	REV	DATE	REVISION DESCRIPTION	DRN	CHK	ENG	APP	EMP
MD-216-4000-EG-ME-GAD-1002	WAREHOUSE & MAIN WORKSHOP SECTION								
MD-216-4000-EG-ME-GAD-1001	WAREHOUSE & MAIN WORKSHOP PLAN VIEW	D01	24/05/2023	AS-BUILT	SYA	SJM	AVG	AG	
MD-216-4000-EG-CV-DED-1060	RC DETAILS	C04	07/02/2022	ISSUED FOR CONSTRUCTION AND REVISED AS MARKED C04	SYA	SJM	AVG	AG	
MD-216-4000-EG-CV-GAD-1059	LAYOUT & DETAIL OF ANCHOR BOLT	C03	22/09/2021	ISSUED FOR CONSTRUCTION AND REVISED AS MARKED C03	SYA	SJM	AVG	AG	
MD-216-4000-EG-CV-GAD-1058	LAYOUT & DETAIL	C02	10/03/2021	ISSUED FOR CONSTRUCTION AND REVISED AS MARKED C02	AUD	SJM	BJB	AG	
MD-216-4000-EG-AR-GAD-3005	BUILDING ELEVATIONS & SECTIONS	C01	27/01/2021	ISSUED FOR CONSTRUCTION AND REVISED AS MARKED C01	AUD	SJM	BJB	AG	
MD-216-4000-EG-AR-GAD-3004	ROOF & FALSE CEILING PLANS	A02	15/12/2020	REVISED AS PER EMPLOYER'S COMMENTS AND AS MARKED A02	AUD	SJM	BJB	AG	
MD-216-4000-EG-AR-GAD-3003	BUILDING PLANS & SCHEDULES OF FINISHES	A01	06/07/2020	ISSUED FOR REFERENCE	SYA	SJM	SNM	AG	

RESERVED FOR VENDOR LOGO AND DRAWING NUMBER

LARSEN & TOUBRO DRAWING NUMBER 019045_501_C_D_24024_004 — REVISION 6
OUTOTEC DRAWING NUMBER 900707 _GAU01 _AN03_ CTB17 _40012 — DOCUMENT ID OU100687711 — REVISION 6

LARSEN & TOUBRO
This drawing is the property of LARSEN & TOUBRO and must not be passed on to any person or body not authorized by us to receive it nor be copied or otherwise made use either in full or in part by such person or body without our prior permission in writing.

Outotec
The content of these documents are the sole property of Outotec Oyj. Any rights not expressly granted herein are reserved. Reproduction, transfer or distribution of part or all of the contents in any form without prior written permission of Outotec is prohibited.

MA'ADEN معادن
Saudi Arabian Mining Company شركة التعدين العربية السعودية
This document and the information contained herein is Ma'aden proprietary know-how. This document or any part thereof should not be reproduced, stored in a retrieval system or transmitted by any means, electronic or otherwise, or divulged without prior written permission of Ma'aden.

DRAWN	SYA	06/07/2020	MANSOURAH - MASSARAH GOLD PROJECT
CHECKED	SJM	07/07/2020	DETAIL DRAWING
ENGINEER	SNM	05/07/2020	PROCESS PLANT- WAREHOUSE & WORKSHOP
APPROVED	AG	07/07/2020	GROUND FLOOR PLAN & DETAILS
EMPLOYER			
SCALE	1:300,25	A1	DRAWING NUMBER MD-216-4000-EG-CV-DED-1061 REV D01