

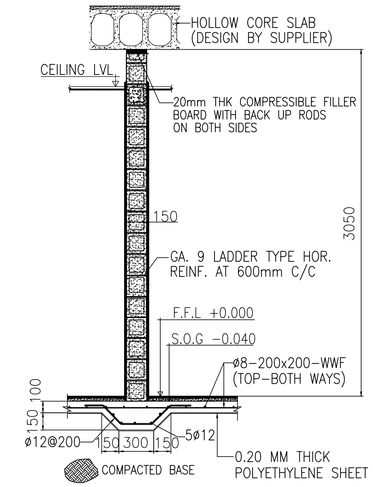


TYP. INTERNAL WALL SECTION
SCALE 1:10

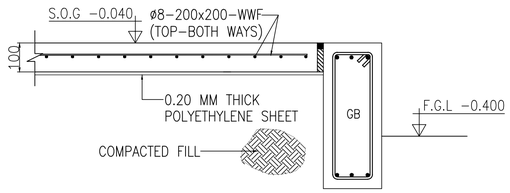


TYP SECTION FOR GRADE SLAB
SCALE 1:10


BEAM MARK	DIMENSIONS		STEEL REINFORCEMENT					STIRRUPS
			BOTTOM		TOP		SIDE FACE	
	WIDTH	DEPTH	STRAIGHT	ADD.	STRAIGHT	ADD.	STRAIGHT	
GB1	300	700	2ø25	–	2ø25	–	1ø12	PROVIDE ø10@125 BOTH IN THE END SPAN & MID SPAN
GB2	300	700	2ø25	–	2ø25	–	1ø12	

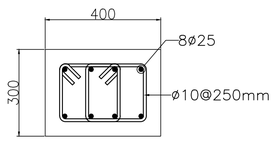


COLUMN DETAIL C1
SCALE 1:10

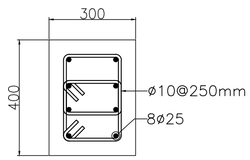


COLUMN DETAIL C2
SCALE 1:10

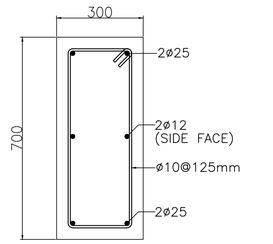


GRADE BEAM AT MIDSPAN GB1
SCALE 1:10

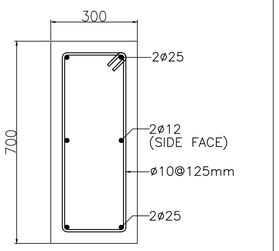


GRADE BEAM AT ENDSPAN GB1
SCALE 1:10

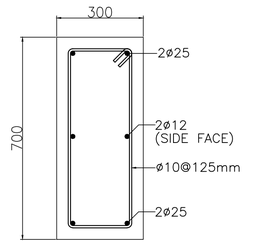

GRADE BEAM AT MIDSPAN GB2
SCALE 1:10

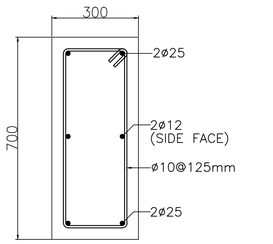

GRADE BEAM AT ENDSPAN GB2
SCALE 1:10

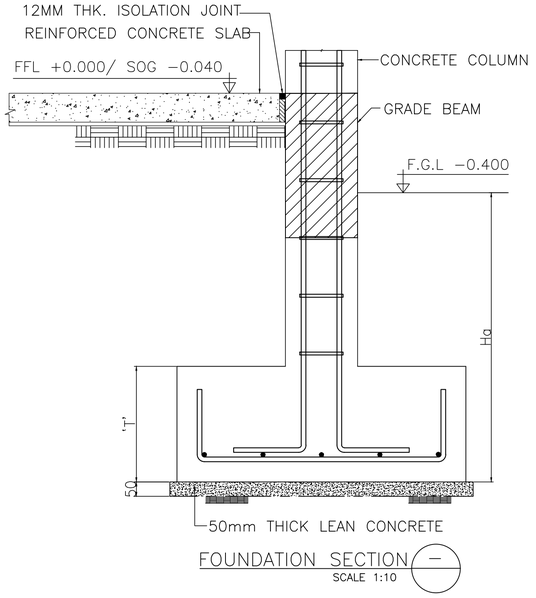

FOUNDATION SECTION
SCALE 1:10

FOOTING MARK	PLAIN CONCRETE			REINFORCED CONCRETE			BOTTOM REINFORCEMENT		TOP REINFORCEMENT		Ha	REMARKS
	L	W	T	L	W	T	SHORT BARS	LONG BARS	SHORT BARS	LONG BARS		
F1	1700	1700	50	1500	1500	400	ø16@200	ø16@200	–	–	1200	
F2	1700	1700	50	1500	1500	400	ø16@200	ø16@200	–	–	1200	

LEGENDS

F/FDN.–FOUNDATION
CR–COLUMN NECK
C/COL.–COLUMN
FFL–FINISH FLOOR LEVEL
FGL–FINISH GROUND LEVEL
THK.–THICK
WWF–WELDED WIRE FABRIC
HCS–HOLLOW CORE SLAB
GB–GRADE BEAM
IJ–ISOLATION JOINT
CJ–CONTROL JOINT
BW's–BOTH WAYS
S.O.G–SLAB ON GRADE
TYP.–TYPICAL
HOR.–HORIZONTAL
REINF.–REINFORCEMENT
LVL.–LEVEL
RL.–REDUCED LEVEL
P.–PEDESTAL
℄ –CENTRE LINE
ø–DIAMETER
C/C –CENTER TO CENTER
ADMIN–ADMINISTRATIVE
DOC. –DOCUMENT

NOTES

1. ALL DIMENSIONS ARE GIVEN IN MILLIMETRES AND ELEVATIONS ARE IN METRES UNLESS OTHERWISE NOTED.
2. MINIMUM REINFORCED CONCRETE GRADE TO BE USED FOR SUPERSTRUCTURE & SUBSTRUCTURES IS C35(5000 PSI).
3. MINIMUM LEAN CONCRETE GRADE TO BE USED FOR THE SUB-STRUCTURES IS C15(2175 PSI).
4. ALL REINFORCING STEEL SHALL BE DEFORMED BILLET STEEL BARS CONFORMING TO ASTM-A615, WITH MINIMUM YIELD STRENGTH OF FY420 MPA .
5. THE NET SOIL BEARING CAPACITY CONSIDERED IN FOUNDATION DESIGN IS 570 KPA(REFER DOCUMENT 216-3000-EG-CV-RPT-1008)
6. WATER PROOFING INSULATION SHALL BE AS PER PROJECT SPECIFICATIONS & ITS MATERIAL TO BE APPROVED BY SITE ENGINEER.
7. MINIMUM CONCRETE COVER AS PER SBC-304-2018(TABLE 20.6.1.3.1) MEASURED FROM REBAR SHALL BE
   a. CONCRETE CAST AGAINST & PERMANENTLY EXPOSED TO EARTH (INCLUDING FOUNDATIONS OVER SUB-SLAB) FORMED CONCRETE EXPOSED TO EARTH OR WEATHER.....50MM
   b. CONCRETE NOT EXPOSED TO WEATHER NOR IN CONTACT WITH GROUND
      BEAMS, COLUMNS.....40MM
      SLABS, WALLS, JOISTS.....20MM
   c. CONCRETE SLAB OVER 50MM SUB-SLAB.....20MM
8. ALL DRAWINGS MUST BE READ IN CONJUNCTION WITH RELEVANT ARCHITECTURAL AND ENGINEERING DRAWINGS RELATED TO THE SAME SHEET AND ANY ITEM ON IT.
9. F.F.L +0.00 MENTIONED IS EQUIVALENT TO RL 915.900

DOCUMENT NUMBER	REFERENCE DOCUMENTS			REVISION DESCRIPTION	DRN	CHK	ENG	APP	EMP
		D01	22/02/2023	AS-BUILT	TEC	BJB	TEC	SJM	
		C01	06/01/2021	ISSUED FOR CONSTRUCTION	TEC	BJB	TEC	SJM	
MD-216-3660-EG-CV-GAD-2002	LAYOUT & DETAIL OF FOUNDATION	A01	24/11/2020	ISSUED FOR REFERENCE	TEC	BJB	TEC	SJM	

RESERVED FOR VENDOR LOGO AND DRAWING NUMBER

LARSEN & TOUBRO

This drawing is the property of LARSEN & TOUBRO and must not be passed on to any person or body not authorized by us to receive it nor be copied or otherwise made use either in full or in part by such person or body without our prior permission in writing.

Outotec

The content of these documents are the sole property of Outotec Oy). Any rights not expressly granted herein are reserved. Reproduction, transfer or distribution of part or all of the contents in any form without prior written permission of Outotec is prohibited.

MA'ADEN معادن
Saudi Arabian Mining Company شركة معادن العربية السعودية

This document and the information contained herein is Ma'aden proprietary know-how. This document or any part thereof should not be reproduced, stored in a retrieval system or transmitted by any means, electronic or otherwise, or divulged without prior written permission of Ma'aden.

LARSEN & TOUBRO DRAWING NUMBER: 019045_501_C_D_24576_001 — REVISION: 2
OUTOTEC DRAWING NUMBER: 900707__GAU01__AN03__CTB17__40021 — DOCUMENT ID: OU100707197 — REVISION: 2

DRAWN	TEC	23/11/2020
CHECKED	AVG	24/11/2020
ENGINEER	TEC	23/11/2020
APPROVED	SJM	24/11/2020
EMPLOYER		
SCALE 1:40		A1

MANSOURAH - MASSARAH GOLD PROJECT
DETAIL DRAWING
PROCESS AREA - ADMIN BUILDING
DETAIL OF FDN., COL. & GRADE BEAM

DRAWING NUMBER: MD-216-4000-EG-CV-DED-1062 — REV: D01