


DRAWING NUMBER MD-216-4000-EG-CV-DED-1072 REV D01

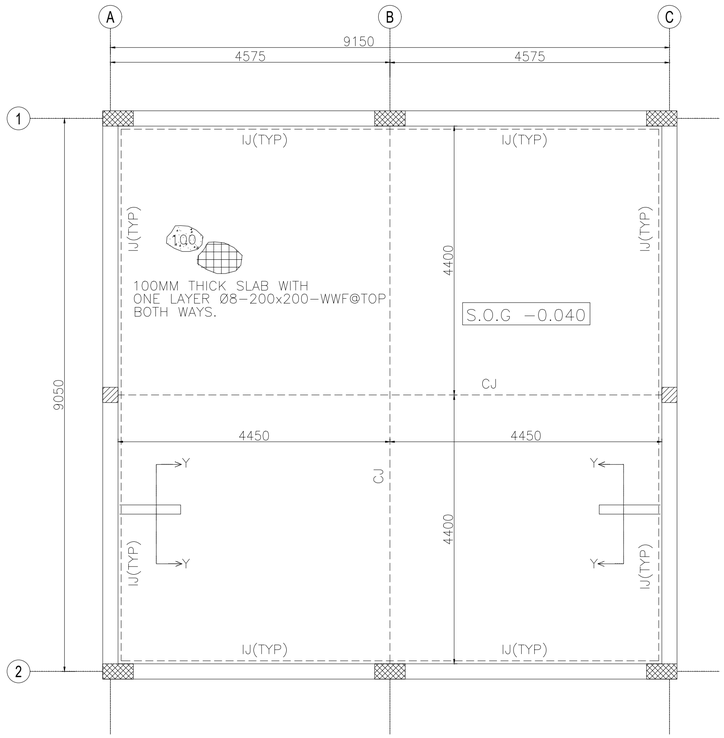

CONCRETE JOINTS LAYOUT
SCALE 1:50

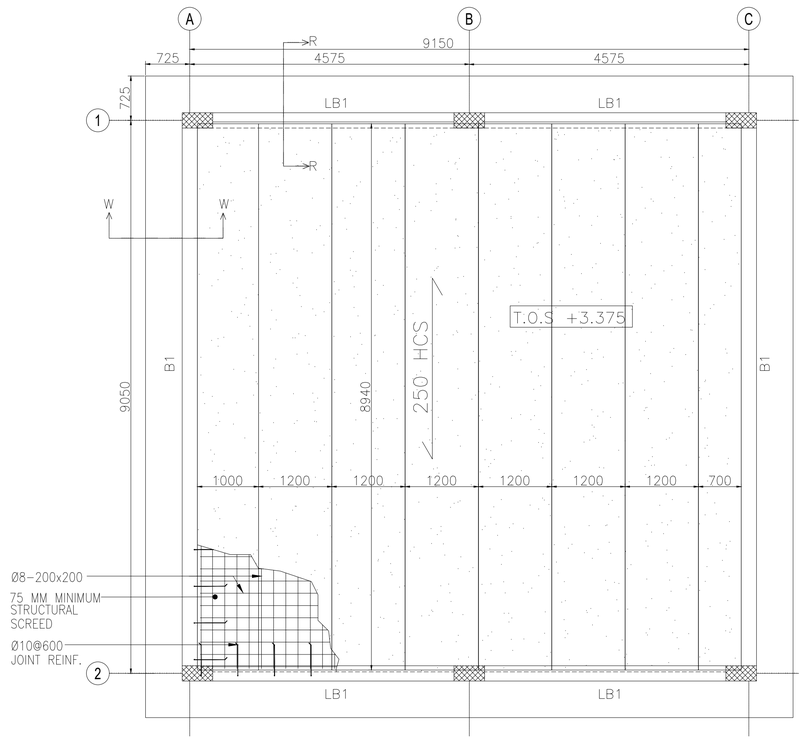


ROOF HOLLOW CORE SLAB LAYOUT
SCALE 1:50

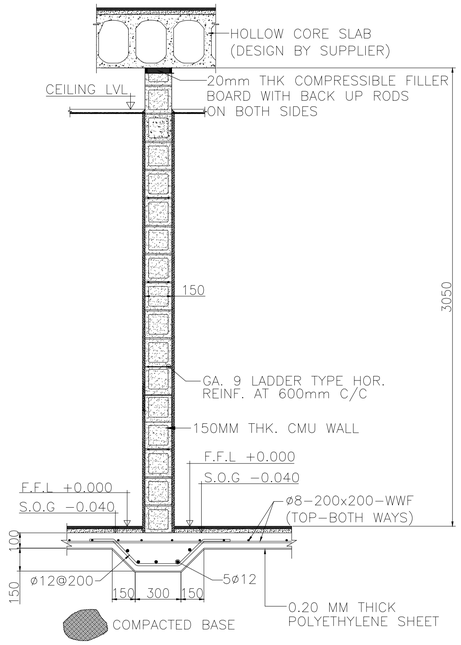


TYPICAL INTERNAL WALL DETAIL-Y
SCALE 1:10

MASTER KEY PLAN

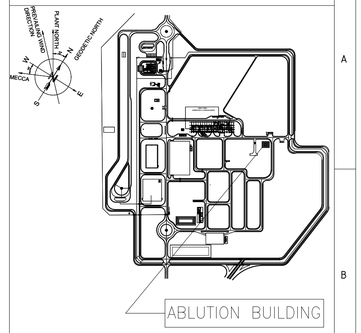


NOTES


1. ALL DIMENSIONS ARE GIVEN IN MILLIMETRES AND ELEVATIONS ARE IN METRES UNLESS OTHERWISE NOTED.
2. MINIMUM REINFORCED CONCRETE GRADE TO BE USED FOR SUPERSTRUCTURE & SUBSTRUCTURES IS M35(5000 PSI).
3. MINIMUM LEAN CONCRETE GRADE TO BE USED FOR THE SUB-STRUCTURES IS M15(2175 PSI).
4. ALL REINFORCING STEEL SHALL BE DEFORMED BILLET STEEL BARS CONFORMING TO ASTM-A615, WITH MINIMUM YIELD STRENGTHOF FY420 MPA .
5. THE NET SOIL BEARING CAPACITY CONSIDERED IN FOUNDATION DESIGN IS 570 KPA(REFER DOC MD-216-3000-EG-CV-CAL-1008-A02)
6. WATER PROOFING INSULATION SHALL BE AS PER PROJECT SPECIFICATIONS & ITS MATERIAL TO BE APPROVED BY SITE ENGINEER.
7. MINIMUM CONCRETE COVER AS PER SBC-304-2018(TABLE 20.6.1.3.1) MEASURED FROM REBAR SHALL BE
   a. CONCRETE CAST AGAINST & PERMANENTLY EXPOSED TO EARTH (INCLUDING FOUNDATIONS OVER SUB-SLAB) FORMED CONCRETE EXPOSED TO EARTH OR WEATHER.....50MM
   b. CONCRETE NOT EXPOSED TO WEATHER NOR IN CONTACT WITH GROUND
      BEAMS, COLUMNS.....40MM
      SLABS, WALLS, JOISTS.....20MM
   c. CONCRETE SLAB OVER 50MM SUB-SLAB.....20MM
8. ALL DRAWINGS MUST BE READ IN CONJUNCTION WITH RELEVANT ARCHITECTURAL AND ENGINEERING DRAWINGS RELATED TO THE SAME SHEET AND ANY ITEM ON IT.
9. F.F.L +0.000 MENTIONED IS EQUIVALENT TO RL 913.400

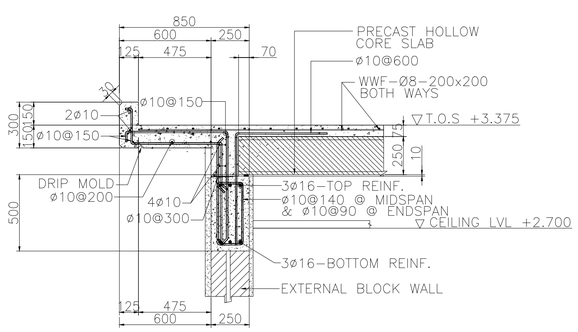

TYPICAL SECTION-R FOR LEDGER BEAM(LB1)
SCALE 1:20

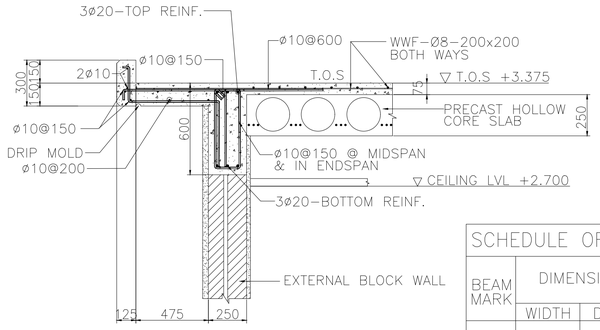

TYPICAL SECTION-W FOR DROP BEAM(B1)
SCALE 1:20

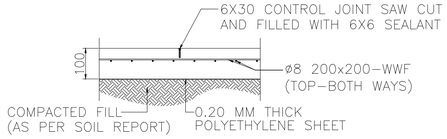

TYPICAL CONTROL JOINT DETAIL
SCALE 1:10

SCHEDULE OF ROOF BEAMS

BEAM MARK	DIMENSIONS		STEEL REINFORCEMENT				STIRRUPS	REMARKS
			TOP		BOTTOM			
	WIDTH	DEPTH	STRAIGHT	ADD.	STRAIGHT	ADD.		
LB1	250	500	3Ø16	–	3Ø16	–	PROVIDE Ø10@90 IN THE END SPAN & Ø10@140 IN THE MIDSPAN	REFER DETAIL-R
B1	250	600	3Ø20	–	3Ø20	–	PROVIDE Ø10@150 BOTH IN THE ENDSPAN & MIDSPAN	REFER DETAIL-W

LEGENDS
F-FOUNDATION
CR-COLUMN NECK
C-COLUMN
FFL-FINISH FLOOR LVL
FGL-FINISH GRADE LVL
TOS-TOP OF SCREED
WWF-WELDED WIRE FABRIC
HCS-HOLLOW CORE SLAB
GB-GRADE BEAM
IJ-ISOLATION JOINT
CJ-CONTROL JOINT
GA-GALVANIZED
S.O.G-SLAB ON GRADE
ARCH-ARCHITECTURAL
HOR.-HORIZONTAL
REINF.-REINFORCEMENT
LVL.-LEVEL
RL.-REDUCED LEVEL

DOCUMENT NUMBER	REFERENCE DOCUMENTS	REV	DATE	REVISION DESCRIPTION	DRN	CHK	ENG	APP	EMP
MD-216-4000-EG-AR-GAD-3026	BUILDING SECTIONS, DOORS & FINISH SCHEDULES								
MD-216-6000-EG-CV-STD-1002	HOLLOW CORE SLAB STANDARD	D01	24/05/2023	AS-BUILT	--	AVG	--	SJM	
MD-216-6000-EG-CV-STD-1001	REINFORCEMENT STANDARD	C01	15/06/2020	ISSUED FOR CONSTRUCTION	--	AVG	--	SJM	
MD-216-4000-EG-AR-GAD-3025	BUILDING PLANS & ELEVATIONS	A01	11/05/2020	ISSUED FOR APPROVAL	--	AVG	--	SJM	

DESIGNER: مكتب الخليج للاستشارات الهندسية
الخبر، المملكة العربية السعودية
GULF CONSULT
ARCHITECTS AND ENGINEERS

DRAWING NUMBER					REVISION
NON-ABL-ST-002					0
DATE	07/05/2020	DATE	08/05/2020	DATE	09/05/2020
DRAWN	MAH	CHECKED	MF	APPROVED	FK

LARSEN & TOUBRO DRAWING NUMBER	REVISION
019045_900_C_D_24033_001	2
OUTOTEC DRAWING NUMBER: 900707__GAU01__AN03__MTL01__60044	DOCUMENT ID: OU100665637 / REVISION: 2

LARSEN & TOUBRO
This drawing is the property of LARSEN & TOUBRO and must not be passed on to any person or body not authorized by us to receive it nor be copied or otherwise made use either in full or in part by such person or body without our prior permission in writing.

Outotec
The content of these documents are the sole property of Outotec Oyj. Any rights not expressly granted herein are reserved. Reproduction, transfer or distribution of part or all of the contents in any form without prior written permission of Outotec is prohibited.

MA'ADEN معادن
Saudi Arabian Mining Company شركة معادن العربية السعودية
This document and the information contained herein is Ma'aden proprietary know-how. This document or any part thereof should not be reproduced, stored in a retrieval system or transmitted by any means, electronic or otherwise, or divulged without prior written permission of Ma'aden.

DRAWN	--	--	MANSOURAH - MASSARAH GOLD PROJECT
CHECKED	AVG	10/05/2020	DETAIL DRAWING
ENGINEER	--	--	PROCESS PLANT-ABLUTION BUILDING
APPROVED	SJM	11/05/2020	LAYOUT & DETAILS OF ROOF & GRADE SLAB
EMPLOYER			
SCALE	1:50	A1	DRAWING NUMBER: MD-216-4000-EG-CV-DED-1072 / REV: D01