



SECTION : A-A

SCALE 1:40

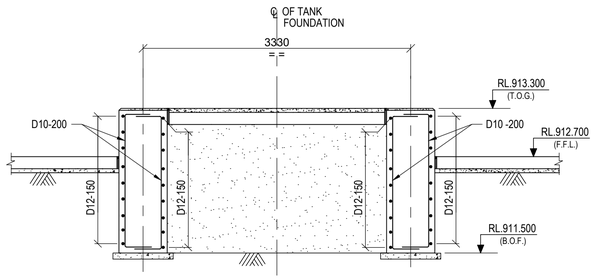


SECTION : B-B

SCALE 1:40

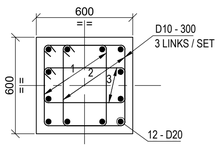


RCC. DET. OF C1

SCALE 1:20

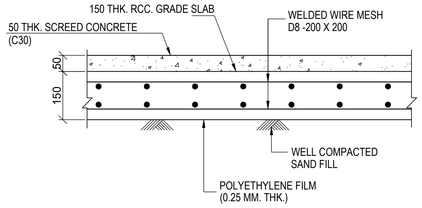

TYP. DET. OF 150 THK. GRADE SLAB


SCALE 1:10

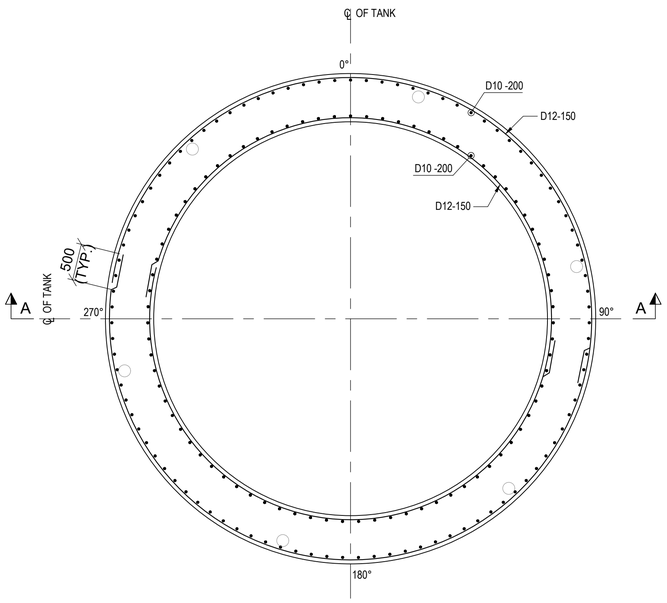

RCC. DETAIL OF TANK FOUNDATION MKD. F1

(FOR 3650-TNK-006)


SCALE 1:40

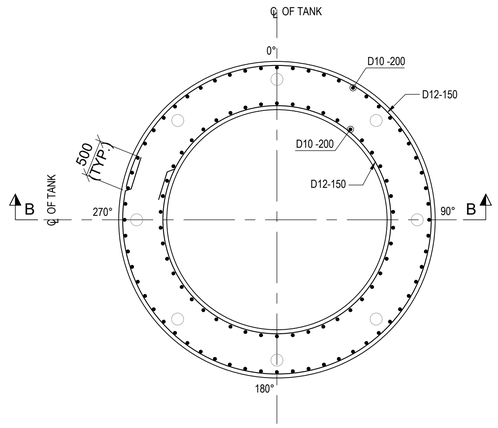

RCC. DETAIL OF TANK FOUNDATION MKD. F2


(FOR 3820-TNK-001)

SCALE 1:40

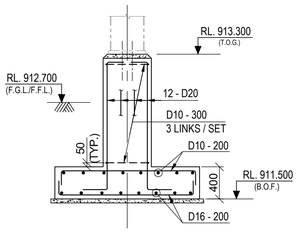

SECTION : C-C

SCALE 1:40

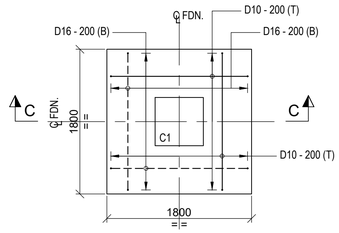

RCC. DETAIL OF FOUNDATION MKD. F3

(FOR 3610-TNK-001)

SCALE 1:40

LEGEND :-

R.L. - REDUCED LEVEL
℄ - CENTRE LINE
T.O.C. - TOP OF CONCRETE
F.G.L. - FINISHED GROUND LEVEL
F.F.L. - FINISHED FLOOR LEVEL
B.O.F. - BOTTOM OF FOUNDATION
TYP. - TYPICAL
R.C.C - REINFORCED CEMENT CONCRETE
P.C.C - PLAIN CEMENT CONCRETE
MKD. - MARKED
THK. - THICK
T.O.G. - TOP OF GROUT
EQV. - EQUIVALENT
BOTTOM REINFORCEMENT (B) - - - - - -
TOP REINFORCEMENT (T) - ———
DET. - DETAIL
FDN. - FOUNDATION

NOTES:-

1. ALL DIMENSIONS ARE IN MILLIMETRES AND LEVELS AND CO-ORDINATES ARE IN METRES UNLESS OTHERWISE STATED.
2. GRADE OF CONCRETE SHALL BE C35 (35MPa) FOR FOUNDATION, C30 (30MPa) FOR GRADE SLAB & C15 (15MPa) FOR BLINDING CONCRETE.
3. GRADE OF REINFORCEMENT SHALL BE DEFORMED BAR 420 MPa (GRADE 60) - ASTM A615/A615M.
4. GRADE OF WELDED WIRE MESH SHALL BE GRADE 60 (fy = 420 MPa) ACCORDING TO A1064.
5. NET SAFE BEARING CAPACITY OF SOIL AT BOTTOM OF FOUNDATION IS CONSIDERED AS 350KN/ SQ. M.
6. CLEAR COVER TO REINFORCEMENT SHALL BE AS FOLLOWS
   a) FOUNDATION = 50 mm
   b) COLUMN = 50mm
   c) WALLS = 50mm
   d) SLAB = 20mm
7. FOR STANDARD REINFORCEMENT DETAIL & GENERAL NOTES FOR CIVIL WORKS REFER DRAWING NO. MD-216-1000-EG-CV-DED-1005 & 1001.

DOCUMENT NUMBER	REFERENCE DOCUMENTS	REV	DATE	REVISION DESCRIPTION	DRN	CHK	ENG	APP	EMP
		D01	22/02/2023	AS-BUILT	SYA	SJM	SOR	AG	
MD-216-3650-EG-GV-GAD-1327	FDN. DET. FOR 3650-TNK-006,3610-TNK-001,3820-TNK-001	C03	17/11/2020	ISSUED FOR CONSTRUCTION & REVISED AS MARKED C03	SYA	SJM	SOR	AG	
MD-216-1000-EG-ST-CRT-1001	CIVIL, STRUCTURAL & ARCHITECTURAL - DESIGN CRITERIA	C02	16/10/2020	ISSUED FOR CONSTRUCTION & REVISED AS MARKED C02	SYA	SJM	SOR	AG	
MD-216-3650-EG-ME-GAD-1015	POX ACID WASH/ELUTION/CARBON REGENERATION, PLAN AT EL. +912.700	C01	26/05/2020	ISSUED FOR CONSTRUCTION	ABS	SJM	SOR	AG	
MD-216-3650-EG-CV-GAD-1001	POX ACID WASH-ELUTION AND CARBON REGENERATION, PLAN AT EL. +912.700	A01	30/05/2020	ISSUED FOR REFERENCE	ABS	SJM	SOR	AG	

RESERVED FOR VENDOR LOGO AND DRAWING NUMBER

LARSEN & TOUBRO DRAWING NUMBER: O19045_450_C_D_24140_001 — REVISION: 4

OUTOTEC DRAWING NUMBER: 900707 __GAU01 __EE12 __CTB17 __36501 — DOCUMENT ID: OU100685994 — REVISION: 4

LARSEN & TOUBRO

This drawing is the property of LARSEN & TOUBRO and must not be passed on to any person or body not authorized by us to receive it nor be copied or otherwise made use either in full or in part by such person or body without our prior permission in writing.

Outotec

The content of these documents are the sole property of Outotec Oyj. Any rights not expressly granted herein are reserved. Reproduction, transfer or distribution of part or all of the contents in any form without prior written permission of Outotec is prohibited.

MA'ADEN معادن
Saudi Arabian Mining Company شركة معادن العربية السعودية

This document and the information contained herein is Ma'aden proprietary know-how. This document or any part thereof should not be reproduced, stored in a retrieval system or transmitted by any means, electronic or otherwise, or divulged without prior written permission of Ma'aden.

DRAWN	ABS	15/05/2020	MANSOURAH - MASSARAH GOLD PROJECT
CHECKED	SJM	16/05/2020	DETAIL DRAWING
ENGINEER	SOR	15/05/2020	POX ACID WASH,ELUTION AND CARBON REGENERATION
APPROVED	AG	30/05/2020	RCC. DET. OF 3650-TNK-006,3610-TNK-001,3820-TNK-001
EMPLOYER			DRAWING NUMBER: MD-216-3650-EG-CV-DED-1334 — REV: D01
SCALE	1:10, 1:20, 1:40	A1	