


DRAWING NUMBER: MD-216-3650-EG-CV-DED-1342 | REV: D01

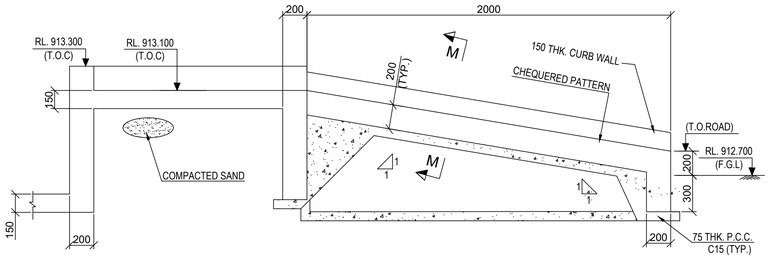


SECTION L-L
SCALE 1:25

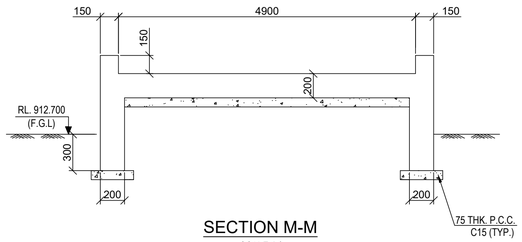


SECTION M-M
SCALE 1:25

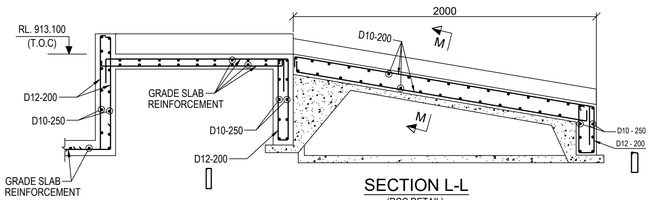


SECTION L-L
(RCC DETAIL)
SCALE 1:30

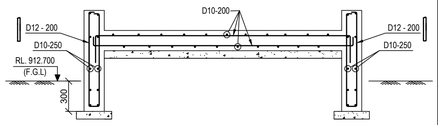


SECTION M-M
(RCC DETAIL)
SCALE 1:25

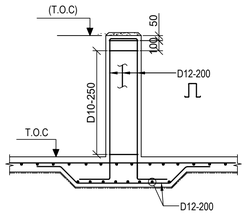


TYP. RCC DETAIL OF PEDESTAL
SCALE 1:30

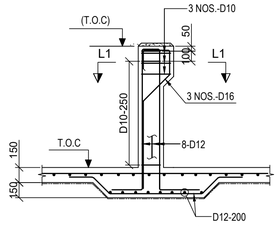


DETAIL - P2h & P2k
(R.C DETAIL)
SCALE 1:30

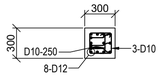


SECTION L1-L1
SCALE 1:30

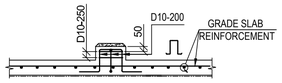


DETAIL - P1, P1a & P1z
SCALE 1:30

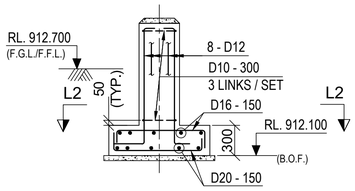


DETAIL - P3a & P3b
SCALE 1:40

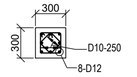


SECTION L2-L2
SCALE 1:30

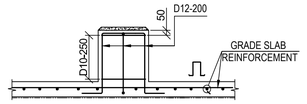


DETAIL - P4
SCALE 1:30

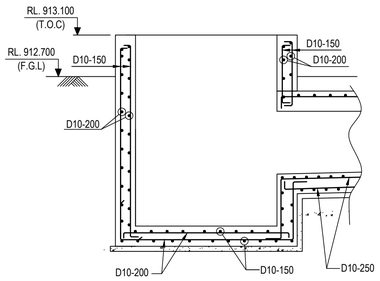


SECTION F-F
(R.C DETAIL)
SCALE 1:30

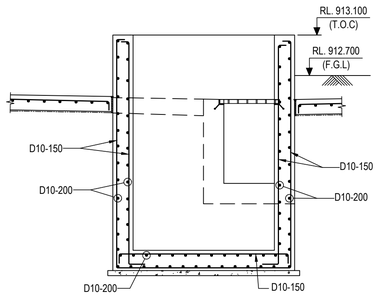


SECTION G-G
(R.C DETAIL)
SCALE 1:30

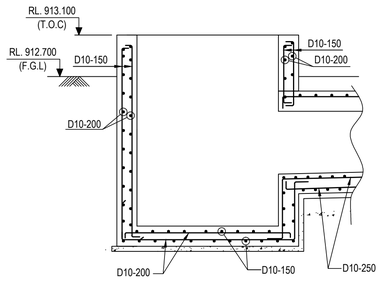


SECTION H-H
(R.C DETAIL)
SCALE 1:30

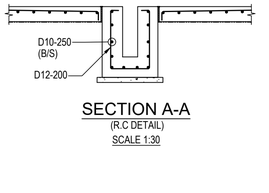


SECTION A-A
(R.C DETAIL)
SCALE 1:30

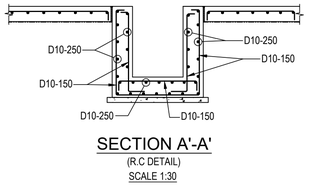


SECTION A'-A'
(R.C DETAIL)
SCALE 1:30

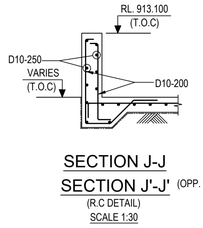


SECTION J-J
SECTION J'-J' (OPP. HAND)
(R.C DETAIL)
SCALE 1:30

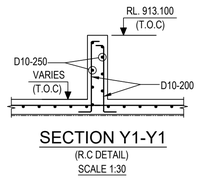


SECTION Y1-Y1
(R.C DETAIL)
SCALE 1:30

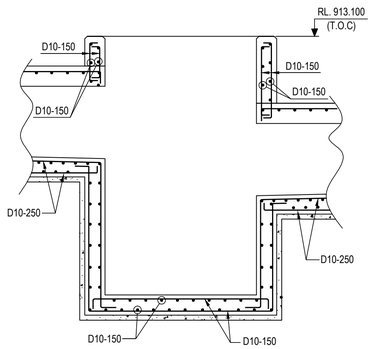


SECTION D-D
(R.C DETAIL)
SCALE 1:30

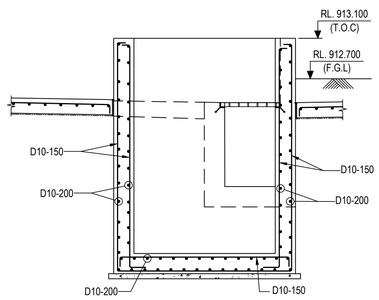


SECTION E-E
(R.C DETAIL)
SCALE 1:30

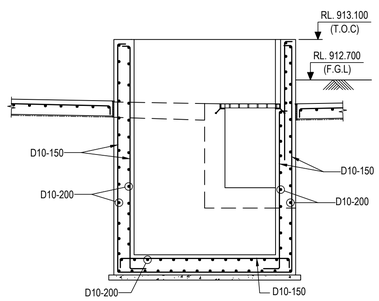


SECTION C-C
(R.C DETAIL)
SCALE 1:30

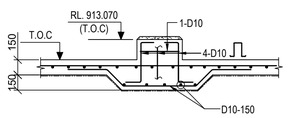


DETAIL - P1
(R.C DETAIL)
SCALE 1:30

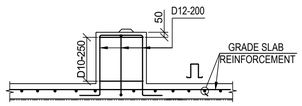

SECTION : U - U
(R.C DETAIL FOR P11, P12 & P13)
SCALE 1:30

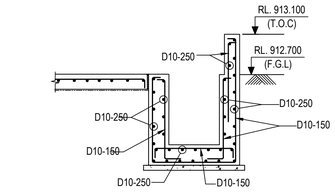

SECTION K-K
SECTION K'-K' (OPP. HAND)
(R.C DETAIL)
SCALE 1:30

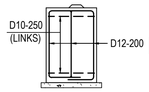

SECTION : U - U
(R.C DETAIL FOR P7, P8, P9 & P10)
SCALE 1:30

C04

LEGEND :-

CJ - CONSTRUCTION JOINT
F.G.L - FINISHED GROUND LEVEL
F.F.L - FINISHED FLOOR LEVEL
R.L. - REDUCED LEVEL
I.L - INVERT LEVEL
THK. - THICK
T.O.C - TOP OF CONCRETE
DRG. - DRAWING
R.C - REINFORCED CONCRETE
RCC - REINFORCED CEMENT CONCRETE
OPP - OPPOSITE

NOTES:-

1. ALL DIMENSIONS ARE IN MILLIMETRES AND LEVELS AND CO-ORDINATES ARE IN METRES UNLESS OTHERWISE STATED.
2. FOR DETAILS OF GRADE SLAB REFER DRG. NO. MD-216-1000-EG-CV-DED-1002.
3. THIS DRAWING IS TO BE READ IN CONJUNCTION WITH DRAWING NO. MD-216-3650-EG-CV-GAD-1335 & MD-216-3820-EG-CV-GAD-1404.

DOCUMENT NUMBER	REFERENCE DOCUMENTS	REV	DATE	REVISION DESCRIPTION	DRN	CHK	ENG	APP	EMP
		D01	22/02/2023	AS-BUILT	NAEW	SJM	SOR	AG	
		C04	27/03/2021	ISSUED FOR CONSTRUCTION & REVISED AS MARKED/C04	SYA	SJM	SOR	AG	
		C03	25/02/2021	ISSUED FOR CONSTRUCTION & REVISED AS MARKED/C03	SYA	SJM	SOR	AG	
MD-216-1000-EG-ST-CRT-1001	CIVIL, STRUCTURAL & ARCHITECTURAL - DESIGN CRITERIA	C02	13/02/2021	ISSUED FOR CONSTRUCTION & REVISED AS MARKED/C02	SYA	SJM	SOR	AG	
MD-216-3650-EG-ME-GAD-1015	POX ACID WASH/ELUTION/CARBON REGENERATION, PLAN AT EL. +912.700	C01	22/12/2020	ISSUED FOR CONSTRUCTION & REVISED AS MARKED/C01	SYA	SJM	SOR	AG	
MD-216-3650-EG-CV-GAD-1001	POX ACID WASH-ELUTION AND CARBON REGENERATION, PLAN AT EL. +912.700	A01	19/10/2020	ISSUED FOR REFERENCE	SYA	SJM	SOR	AG	

RESERVED FOR VENDOR LOGO AND DRAWING NUMBER

LARSEN & TOUBRO

This drawing is the property of LARSEN & TOUBRO and must not be passed on to any person or body not authorized by us to receive it nor be copied or otherwise made use either in full or in part by such person or body without our prior permission in writing.

Outotec

The content of these documents are the sole property of Outotec Oyj. Any rights not expressly granted herein are reserved. Reproduction, transfer or distribution of part or all of the contents in any form without prior written permission of Outotec is prohibited.

MA'ADEN معادن
Saudi Arabian Mining Company شركة التعدين العربية السعودية

This document and the information contained herein is Ma'aden proprietary know-how. This document or any part thereof should not be reproduced, stored in a retrieval system or transmitted by any means, electronic or otherwise, or divulged without prior written permission of Ma'aden.

LARSEN & TOUBRO DRAWING NUMBER	O19045_450_C_D_24560_002	REVISION 5
OUTOTEC DRAWING NUMBER	900707 _GAU01 _EE12 _CTB17 _36505	DOCUMENT ID OU100704157 / REVISION 5
DRAWN	SYA	15/10/2020
CHECKED	SJM	17/10/2020
ENGINEER	SOR	15/10/2020
APPROVED	AG	19/10/2020
EMPLOYER		
SCALE	1:50, 1:25, 1:20	A1

MANSOURAH - MASSARAH GOLD PROJECT
DETAIL DRAWING
POX ACID WASH,ELUTION AND CARBON REGENERATION
RCC DETAILS OF GRADE SLAB

DRAWING NUMBER: MD - 216 - 3650 - EG - CV - DED - 1342 | REV: D01