


DRAWING NUMBER: MD-216-3650-EG-CV-DED-1343 | REV: D01

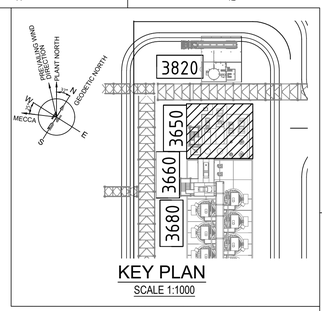

KEY PLAN
SCALE 1:1000

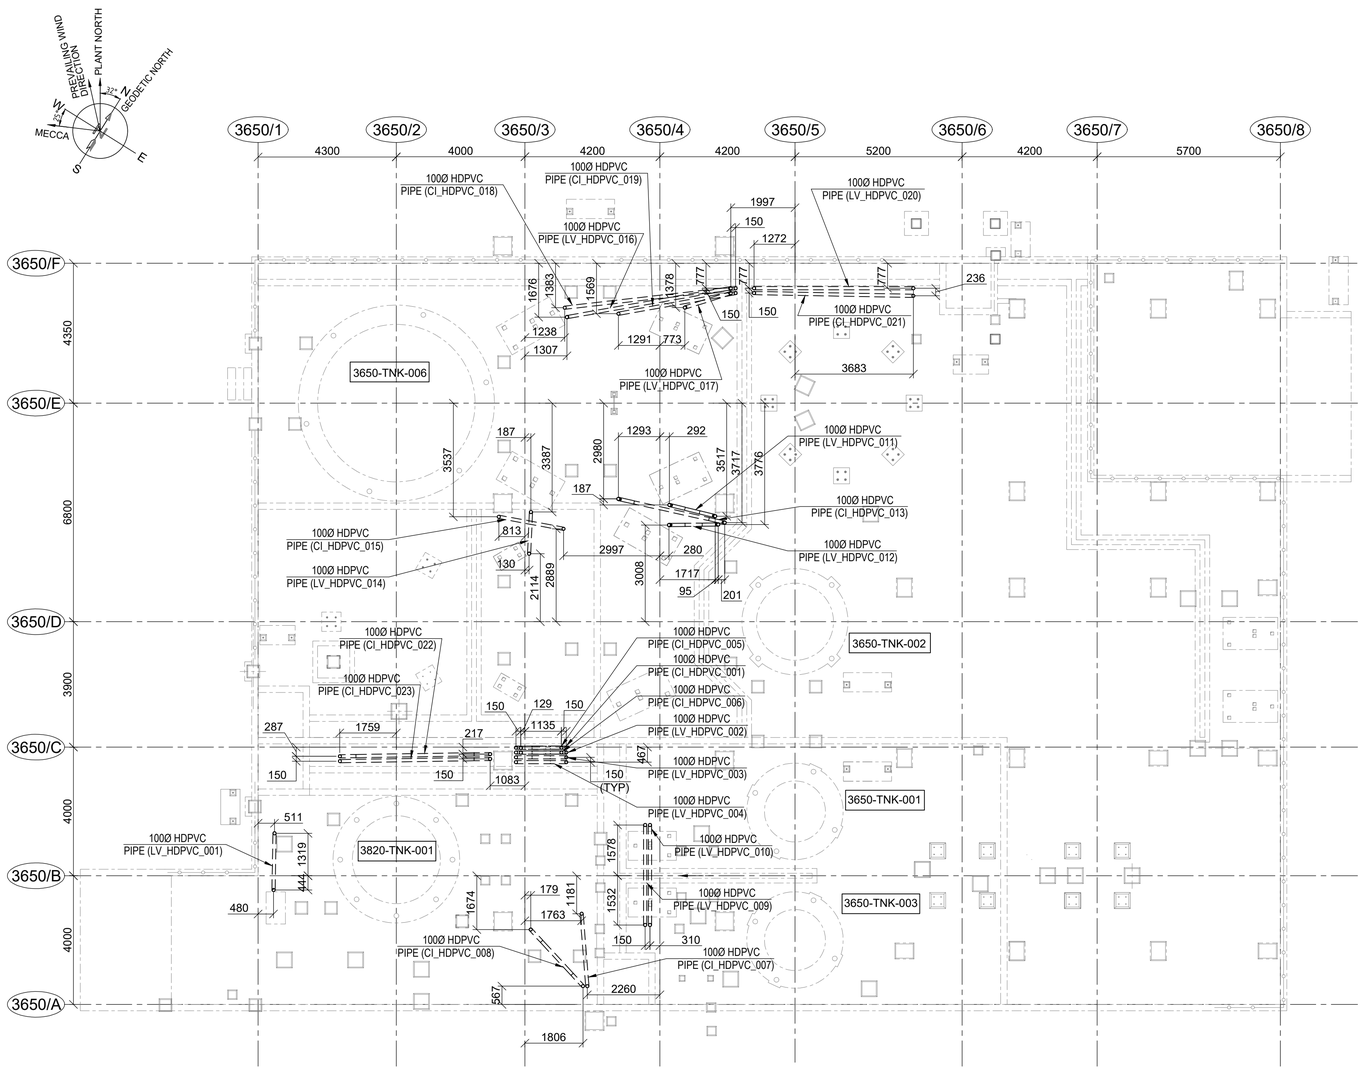

TYPICAL DETAIL OF CONDUIT
SCALE 1:50

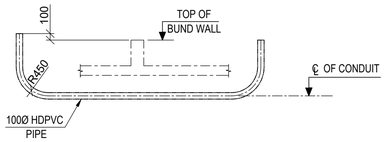

SCHEDULE OF CONDUIT

CONDUIT MKD.	ELEVATION AT ℄ OF CONDUIT
LV_HDPVC_001	RL 912.170
CI_HDPVC_001	RL 911.700
LV_HDPVC_002	RL 911.700
LV_HDPVC_003	RL 911.700
LV_HDPVC_004	RL 911.700
CI_HDPVC_005	RL 911.850
CI_HDPVC_006	RL 911.850
CI_HDPVC_007	RL 912.050
CI_HDPVC_008	RL 912.050
LV_HDPVC_009	RL 911.700
LV_HDPVC_010	RL 911.700
LV_HDPVC_011	RL 912.070
LV_HDPVC_012	RL 912.070
CI_HDPVC_013	RL 912.070
LV_HDPVC_014	RL 912.200
CI_HDPVC_015	RL 912.070
LV_HDPVC_016	RL 911.850
LV_HDPVC_017	RL 911.850
CI_HDPVC_018	RL 911.700
CI_HDPVC_019	RL 911.700
LV_HDPVC_020	RL 911.700
CI_HDPVC_021	RL 911.700
CI_HDPVC_022	RL 911.700
CI_HDPVC_023	RL 911.700

LEGEND :-

R.L. - REDUCED LEVEL
I.L - INVERT LEVEL
℄ - CENTRE LINE
Ø - DIAMETER
R - RADIUS
MKD. - MARKED

NOTES:-

1. ALL DIMENSIONS ARE IN MILLIMETRES AND LEVELS AND CO-ORDINATES ARE IN METRES UNLESS OTHERWISE STATED.
2. THIS DRAWING IS TO BE READ IN CONJUNCTION WITH DRAWING NO- MD-216-3650-EG-CV-GAD-1327,1328, 1329, 1335, 1336, 1337 & MD-216-3820-EG-CV-GAD-1404.

DOCUMENT NUMBER	REFERENCE DOCUMENTS	REV	DATE	REVISION DESCRIPTION	DRN	CHK	ENG	APP	EMP
MD-216-3650-EG-EL-LAD-1008	POX ACID WASH,ELUTION AND CARBON REGENERATION	D01	22/02/2023	AS-BUILT	SYA	SJM	SOR	AG	
	CABLE ROUTE LAYOUT - EMBEDDED PART	C01	09/04/2021	REVISED AS PER EMPLOYERS COMMENT DATED 08/04/2021	SYA	SJM	SOR	AG	
MD-216-3650-EG-ME-GAD-1015	POX ACID WASH/ELUTION/CARBON REGENERATION, PLAN AT EL. +912.700			& AS MARKED					
MD-216-3650-EG-CV-GAD-1001	POX ACID WASH-ELUTION AND CARBON REGENERATION, PLAN AT EL. +912.700	A01	15/03/2021	ISSUED FOR REVIEW	SYA	SJM	SOR	AG	

RESERVED FOR VENDOR LOGO AND DRAWING NUMBER

LARSEN & TOUBRO

This drawing is the property of LARSEN & TOUBRO and must not be passed on to any person or body not authorized by us to receive it nor be copied or otherwise made use either in full or in part by such person or body without our prior permission in writing.

Outotec

The content of these documents are the sole property of Outotec Oyj. Any rights not expressly granted herein are reserved. Reproduction, transfer or distribution of part or all of the contents in any form without prior written permission of Outotec is prohibited.

MA'ADEN معادن
Saudi Arabian Mining Company شركة التعدين العربية السعودية

This document and the information contained herein is Ma'aden proprietary know-how. This document or any part thereof should not be reproduced, stored in a retrieval system or transmitted by any means, electronic or otherwise, or divulged without prior written permission of Ma'aden.

DRAWN	SYA	12/03/2021
CHECKED	SJM	13/03/2021
ENGINEER	SOR	12/03/2021
APPROVED	AG	15/03/2021
EMPLOYER		
SCALE	1:100, 1:50	A1

LARSEN & TOUBRO DRAWING NUMBER: 019045_450_C_D_24560_003 | REVISION: 2
OUTOTEC DRAWING NUMBER: 900707__GAU01__EE12__CTB17__36506 | DOCUMENT ID: OU100704158 | REVISION: 2

MANSOURAH - MASSARAH GOLD PROJECT
DETAIL DRAWING
POX ACID WASH,ELUTION AND CARBON REGENERATION
LAYOUT & DETAIL OF EMBEDDED CONDUITS

DRAWING NUMBER: MD-216-3650-EG-CV-DED-1343 | REV: D01