


DRAWING NUMBER MD-216-3110-EG-CV-DED-1004 REV D01

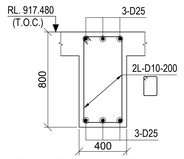


TYP. CROSS SECTION OF BEAM MKD. FB1
(SCALE- 1:25)

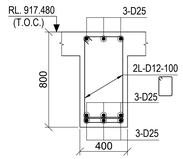


TYP. CROSS SECTION OF BEAM MKD. FB1A
(SCALE- 1:25)

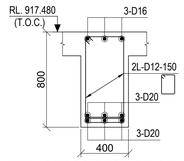


TYP. CROSS SECTION OF BEAM MKD. FB2
(SCALE- 1:25)

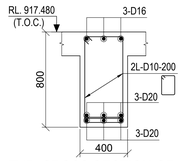


TYP. CROSS SECTION OF BEAM MKD. FB3
(SCALE- 1:25)

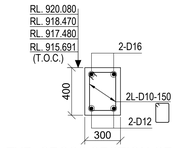


TYP. CROSS SECTION OF BEAM MKD. FB4
(SCALE- 1:25)

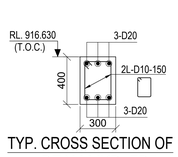


TYP. CROSS SECTION OF BEAM MKD. FB5
(SCALE- 1:25)

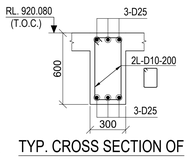


TYP. CROSS SECTION OF BEAM MKD. FB6
(SCALE- 1:25)

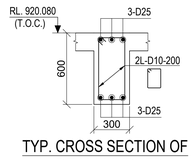


TYP. CROSS SECTION OF BEAM MKD. FB7
(SCALE- 1:25)

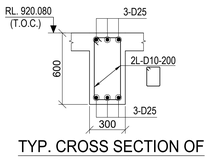


TYP. CROSS SECTION OF BEAM MKD. FB8
(SCALE- 1:25)

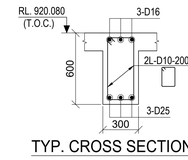


TYP. CROSS SECTION OF BEAM MKD. FB9
(SCALE- 1:25)

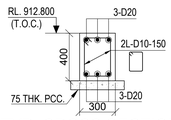


TYP. CROSS SECTION OF BEAM MKD. TB1,TB2 & TB3
(SCALE- 1:25)

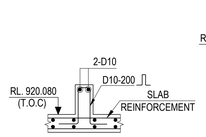


R.C DETAIL OF SECTION 2-2
(FOR THIS SECTION MARK REFER DRAWING NO.: MD-216-3110-EG-CV-GAD-1004)
(SCALE-1:25)

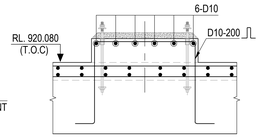


R.C DETAIL OF SECTION 3-3
(FOR THIS SECTION MARK REFER DRAWING NO.: MD-216-3110-EG-CV-GAD-1004)
(SCALE-1:25)

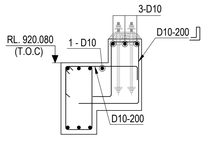


R.C DETAIL OF SECTION 4-4
(FOR THIS SECTION MARK REFER DRAWING NO.: MD-216-3110-EG-CV-GAD-1004)
(SCALE-1:25)

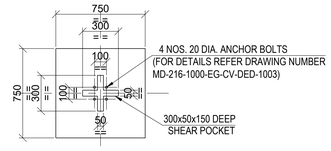


DETAIL OF COLUMN BASE FOR COLUMN MKD. - C3
(SCALE-1:25)

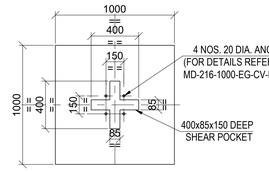


DETAIL OF COLUMN BASE FOR COLUMN MKD. - C4
(SCALE-1:25)

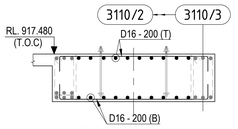


SECTION A-A
(FOR THIS SECTION MARK REFER DRAWING NO.: MD-216-3110-EG-CV-GAD-1004)
(SCALE-1:50)

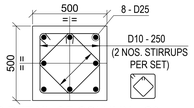


R.C DETAIL OF COLUMN - C2
(SCALE 1:20)

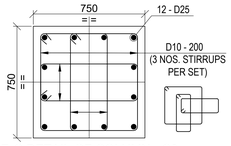


R.C DETAIL OF COLUMN - C3
(SCALE 1:20)

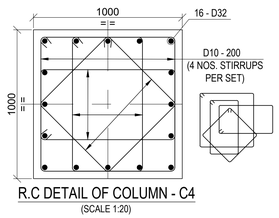


R.C DETAIL OF COLUMN - C4
(SCALE 1:20)

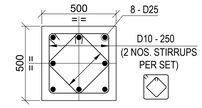


R.C DETAIL OF COLUMN - C1
(SCALE 1:20)

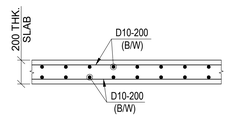


TYPICAL R.C DETAIL OF 200 THK. SLAB
(SCALE- 1:25)

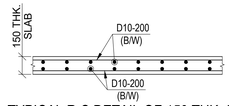


TYPICAL R.C DETAIL OF 150 THK. SLAB
(SCALE- 1:25)

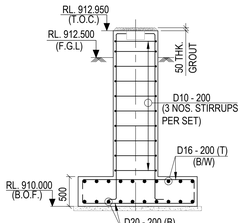


SECTION 6-6
(SCALE-1:50)

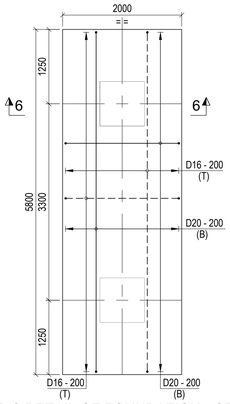


R.C DETAIL OF FOUNDATION - CF6
(SCALE 1:50)

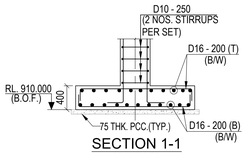


SECTION 1-1
(SCALE-1:50)

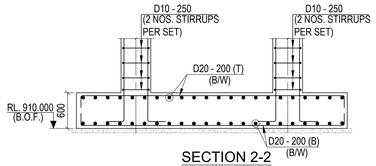


SECTION 2-2
(SCALE-1:50)

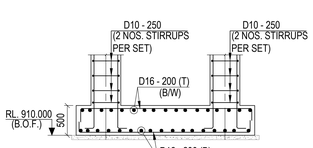


SECTION 3-3
(SCALE-1:50)

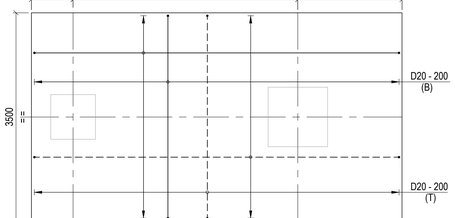


R.C DETAIL OF FOUNDATION - CF5
(SCALE 1:50)

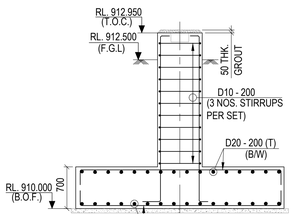


SECTION 5-5
(SCALE-1:50)

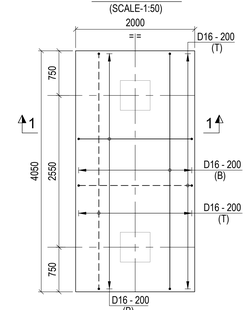


R.C DETAIL OF FOUNDATION - CF1
(SCALE 1:50)

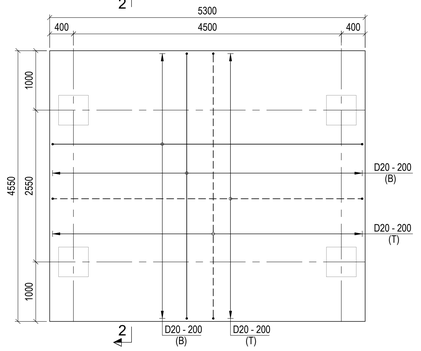


R.C DETAIL OF FOUNDATION - CF2
(SCALE 1:50)

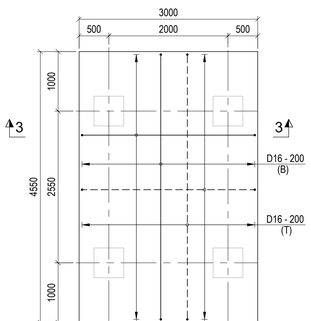

R.C DETAIL OF FOUNDATION - CF3
(SCALE 1:50)

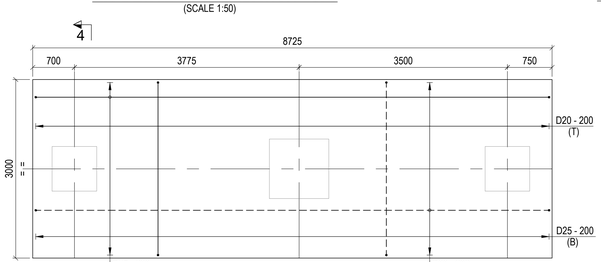

R.C DETAIL OF FOUNDATION - CF4
(SCALE 1:50)

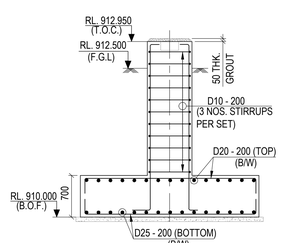

SECTION 4-4
(SCALE-1:50)

LEGEND :-

R.L. - REDUCED LEVEL
T.O.C. - TOP OF CONCRETE.
F.G.L. - FINISHED GROUND LEVEL.
F.F.L. - FINISHED FLOOR LEVEL.
B.O.F. - BOTTOM OF FOUNDATION
TYP. - TYPICAL.
R.C. - REINFORCED CONCRETE
P.C.C - PLAIN CEMENT CONCRETE
MKD. - MARKED.
THK. - THICK
DIA. - DIAMETER
B/W - BOTH WAYS
BOTTOM REINFORCEMENT (B) - ————
TOP REINFORCEMENT (T) - — — —

NOTES :-

1. ALL DIMENSIONS ARE IN MILLIMETRES AND LEVELS AND CO-ORDINATES ARE IN METRES. UNLESS OTHERWISE STATED.
2. GRADE OF CONCRETE SHALL BE C35 FOR FOUNDATION.
3. GRADE OF REINFORCEMENT SHALL BE DEFORMED BAR ASTM A615 - GRADE 60 (fy = 420 MPa).
4. NET SAFE BEARING CAPACITY OF SOIL AT BOTTOM OF FOUNDATION CONSIDERED 600KN/SQ. M.
5. CLEAR COVER TO MAIN REINFORCEMENT SHALL BE AS
   a) FOUNDATION = 75 mm (BOTTOM & SIDE) 50 mm. (TOP)
   b) COLUMN & PEDESTAL = 50mm
   c) BEAM = 50mm
   d) SLAB = 40mm
6. MINIMUM LAP LENGTH OF REINFORCEMENT SHALL BE 40 x DIA. OF BAR.
7. READ THIS DRAWING IN CONJUNCTION WITH DRG: MD-216-3110-EG-CV-GAD-1004 & MD-216-3110-EG-CV-GAD-1005.

DOCUMENT NUMBER	REFERENCE DOCUMENTS	REV	DATE	REVISION DESCRIPTION	DRN	CHK	ENG	APP	EMP
		D01	10/03/2023	AS-BUILT	APM	BDA	STY	AG	
		C02	19/10/2020	ISSUED FOR CONSTRUCTION AND REVISED AS MKD. C02	APM	BDA	STY	AG	
		C01	27/03/2020	ISSUED FOR CONSTRUCTION	APM	BDA	STY	AG	
		A01	17/02/2020	ISSUED FOR REFERENCE	APM	BDA	STY	AG	

RESERVED FOR VENDOR LOGO AND DRAWING NUMBER

LARSEN & TOUBRO

This drawing is the property of LARSEN & TOUBRO and must not be passed on to any person or body not authorized by us to receive it nor be copied or otherwise made use either in full or in part by such person or body without our prior permission in writing.

Outotec

The content of these documents are the sole property of Outotec Oyj. Any rights not expressly granted herein are reserved. Reproduction, transfer or distribution of part or all of the contents in any form without prior written permission of Outotec is prohibited.

MA'ADEN معادن Saudi Arabian Mining Company شركة معادن العربية السعودية

This document and the information contained herein is Ma'aden proprietary know-how. This document or any part thereof should not be reproduced, stored in a retrieval system or transmitted by any means, electronic or otherwise, or divulged without prior written permission of Ma'aden.

LARSEN & TOUBRO DRAWING NUMBER		REVISION
019045_100_C_D_24060_002		3
OUTOTEC DRAWING NUMBER	DOCUMENT ID	REVISION
900707__GAU01__ZC01__CTB17__31101	OU100666800	3

DRAWN	APM	11/02/2020
CHECKED	BDA	13/02/2020
ENGINEER	STY	15/02/2020
APPROVED	AG	17/02/2020
EMPLOYER		
SCALE	1:100, 1:50	A1

MANSOURAH - MASSARAH GOLD PROJECT
DETAIL DRAWING
PRIMARY CRUSHING
RC DETAILS

DRAWING NUMBER: MD-216-3110-EG-CV-DED-1004 REV: D01