


DRAWING NUMBER MD-216-3110-EG-CV-DED-1005 REV D01

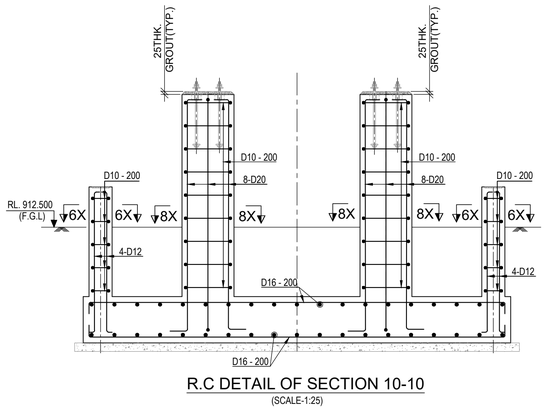


R.C DETAIL OF SECTION 10-10
(SCALE-1:25)

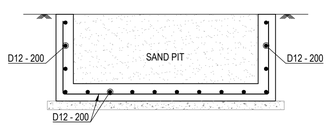


R.C DETAIL OF SECTION 13-13
(SCALE-1:25)

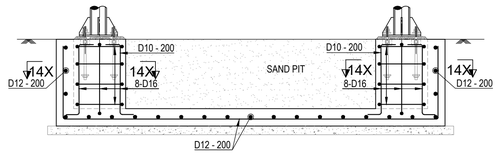


R.C DETAIL OF SECTION 14-14
(SCALE-1:25)

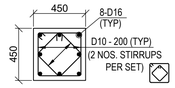


SECTION 14X-14x
(SCALE-1:25)

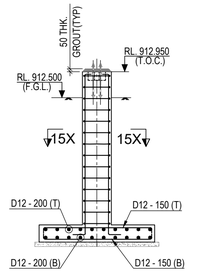


R.C DETAIL OF SECTION 15-15
(SCALE 1:50)

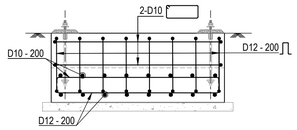


R.C DETAIL OF SECTION 11-11
(SCALE-1:25)

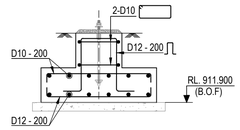


R.C DETAIL OF SECTION 12-12
(SCALE-1:25)

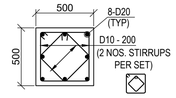


SECTION 15X-15x
R.C DETAIL OF COLUMN - C1
(SCALE-1:25)

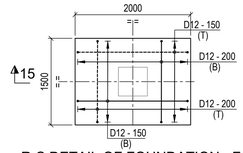


R.C DETAIL OF FOUNDATION - F1
(SCALE 1:50)

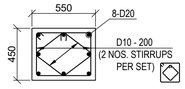

SECTION 4X-4X
(SCALE-1:25)

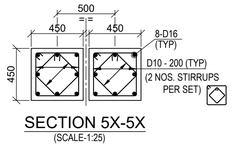


SECTION 5X-5X
(SCALE-1:25)

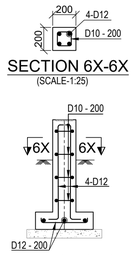


SECTION 6X-6X
(SCALE-1:25)


R.C DETAIL OF SECTION 6-6
(SCALE-1:25)

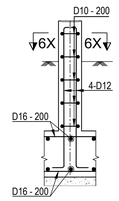


R.C DETAIL OF SECTION 7-7
(SCALE-1:25)

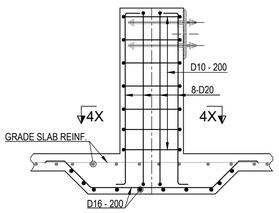


R.C DETAIL OF SECTION 4-4
(SCALE-1:25)

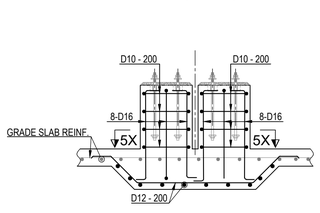


R.C DETAIL OF SECTION 5-5
(SCALE-1:25)

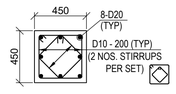


SECTION 8X-8x
(SCALE-1:25)

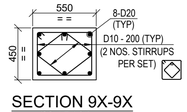


SECTION 9X-9X
(SCALE-1:25)

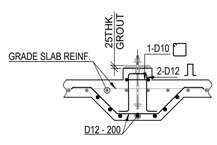


R.C DETAIL OF SECTION 1-1
(SCALE-1:25)

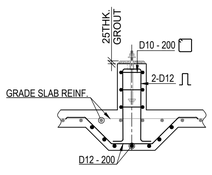


R.C DETAIL OF SECTION 2-2
(SCALE-1:25)

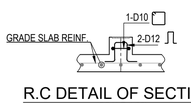

R.C DETAIL OF SECTION 3-3
(SCALE-1:25)

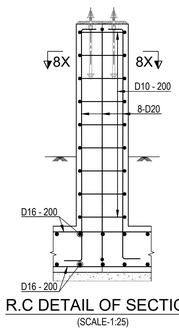

R.C DETAIL OF SECTION 8-8
(SCALE-1:25)

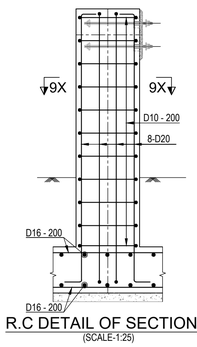

R.C DETAIL OF SECTION 9-9
(SCALE-1:25)

LEGEND :-

R.L. - REDUCED LEVEL
T.O.C. - TOP OF CONCRETE.
F.G.L. - FINISHED GROUND LEVEL.
F.F.L. - FINISHED FLOOR LEVEL.
B.O.F. - BOTTOM OF FOUNDATION
TYP. - TYPICAL.
R.C. - REINFORCED CONCRETE
P.C.C - PLAIN CEMENT CONCRETE
MKD. - MARKED.
THK. - THICK
B/W - BOTH WAYS
BOTTOM REINFORCEMENT (B) - ————
TOP REINFORCEMENT (T) - – – – – –

NOTES :-

1. ALL DIMENSIONS ARE IN MILLIMETRES AND LEVELS AND CO-ORDINATES ARE IN METRES. UNLESS OTHERWISE STATED.
2. GRADE OF CONCRETE SHALL BE C35 FOR FOUNDATION.
3. GRADE OF REINFORCEMENT SHALL BE DEFORMED BAR ASTM A615 - GRADE 60 (fy = 420 MPa).
4. NET SAFE BEARING CAPACITY OF SOIL AT BOTTOM OF FOUNDATION SHALL BE CONSIDERED AS 600KN/ SQ. M.
5. CLEAR COVER TO MAIN REINFORCEMENT SHALL BE AS FOLLOWS:
   a) FOUNDATION = 75 mm (BOTTOM & SIDE) 50 mm. (TOP)
   b) COLUMN & PEDESTAL = 50mm
6. FOR LAP LENGTHS REFER DWG. NO. MD-216-1000-EG-CV-DED-1001.
7. READ THIS DRAWING IN CONJUNCTION WITH DRG: MD-216-3110-EG-CV-GAD-1007 & MD-216-3110-EG-CV-GAD-1008-A01.
8. FOR STANDARD REINFORCEMENT DETAILS REFER DWG. NO. MD-216-1000-EG-CV-DED-1005.

DOCUMENT NUMBER	REFERENCE DOCUMENTS	REV	DATE	REVISION DESCRIPTION	DRN	CHK	ENG	APP	EMP
		D01	10/03/2023	AS-BUILT	APM	BDA	STY	AG	
		C01	16/05/2020	ISSUED FOR CONSTRUCTION AND REVISED AS MARKED C01	APM	BDA	STY	AG	
		A01	18/04/2020	ISSUED FOR REFERENCE	APM	BDA	STY	AG	

RESERVED FOR VENDOR LOGO AND DRAWING NUMBER

LARSEN & TOUBRO

This drawing is the property of LARSEN & TOUBRO and must not be passed on to any person or body not authorized by us to receive it nor be copied or otherwise made use either in full or in part by such person or body without our prior permission in writing.

Outotec

The content of these documents are the sole property of Outotec Oyj. Any rights not expressly granted herein are reserved. Reproduction, transfer or distribution of part or all of the contents in any form without prior written permission of Outotec is prohibited.

MA'ADEN معادن
Saudi Arabian Mining Company شركة معادن العربية السعودية

This document and the information contained herein is Ma'aden proprietary know-how. This document or any part thereof should not be reproduced, stored in a retrieval system or transmitted by any means, electronic or otherwise, or divulged without prior written permission of Ma'aden.

LARSEN & TOUBRO DRAWING NUMBER: 019045_100_C_D_24060_003 — REVISION: 2
OUTOTEC DRAWING NUMBER: 900707__GAU01__ZC01__CTB17__31106 — DOCUMENT ID: OU100680994 — REVISION: 2

DRAWN	APM	10/04/2020
CHECKED	BDA	16/04/2020
ENGINEER	STY	12/04/2020
APPROVED	AG	18/04/2020
EMPLOYER		
SCALE	1:100, 1:50	A1

MANSOURAH - MASSARAH GOLD PROJECT
DETAIL DRAWING
PRIMARY CRUSHING
GRADE SLAB

DRAWING NUMBER: MD-216-3110-EG-CV-DED-1005 — REV: D01