


DRAWING NUMBER MD-216-3110-EG-CV-DED-1007 REV D01

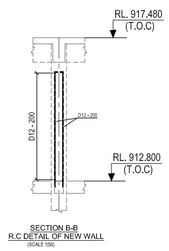

SECTION B-B
R.C DETAIL OF NEW WALL
(SCALE 1:50)

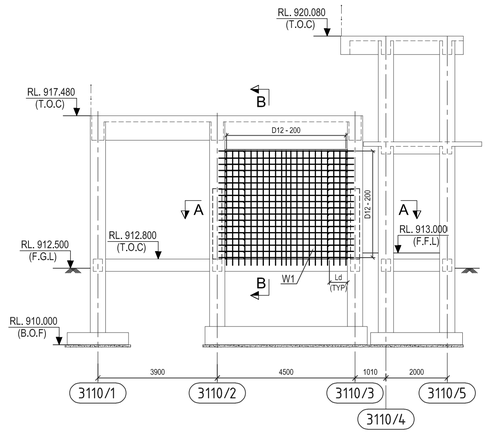


R.C DETAIL OF NEW WALL
ELEVATION AT GRID - 3110/C
(SCALE 1:100)

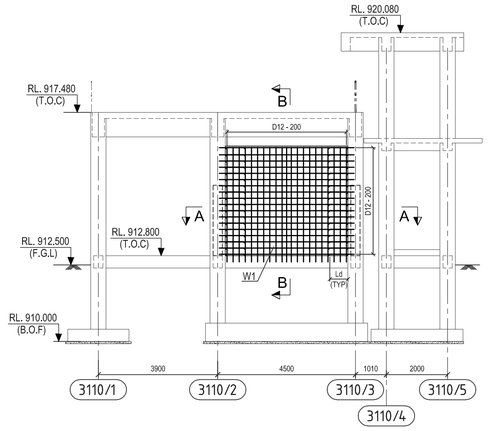


R.C DETAIL OF NEW WALL
ELEVATION AT GRID - 3110/D
(SCALE 1:100)


- 200 MM. LONG 15 MM. DIA DRILLED HOLE.
- 12 MM. DIA REBAR INSERTED IN HOLE. MINIMUM (Ld) PROJECTION FOR REBAR LAPPING.
- HOLE GROUTED WITH EPOXY MORTAR/ADHESIVE (AS PER MANUFACTURER'S SPECIFICATION). (TYP)

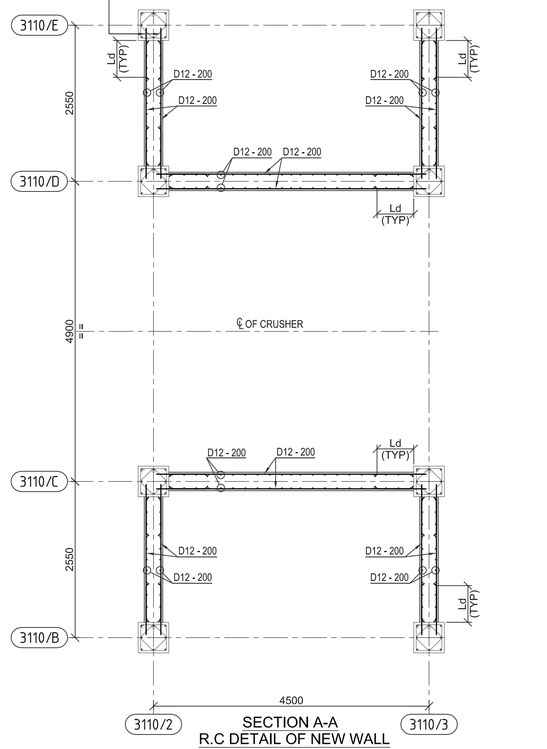


SECTION A-A
R.C DETAIL OF NEW WALL
(SCALE 1:50)

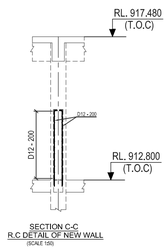

SECTION C-C
R.C DETAIL OF NEW WALL
(SCALE 1:50)

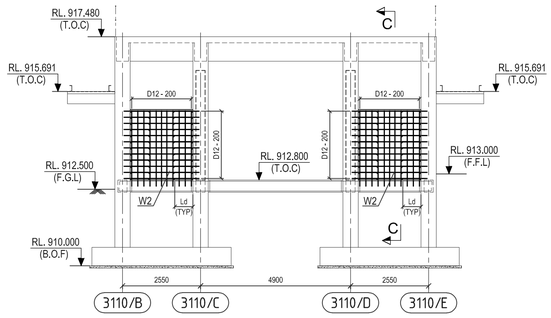

R.C DETAIL OF NEW WALL
ELEVATION AT GRID - 3110/2
(SCALE 1:100)

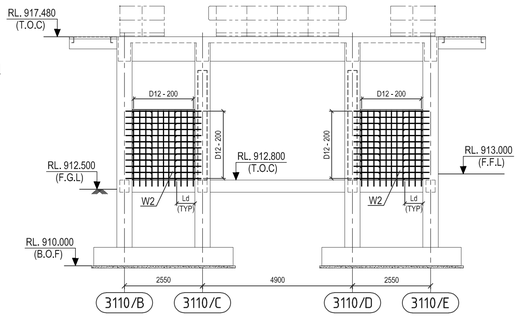

R.C DETAIL OF NEW WALL
ELEVATION AT GRID - 3110/3
(SCALE 1:100)

LEGEND :-

R.L. - REDUCED LEVEL
T.O.C. - TOP OF CONCRETE.
F.G.L. - FINISHED GROUND LEVEL.
F.F.L. - FINISHED FLOOR LEVEL.
B.O.F. - BOTTOM OF FOUNDATION
TYP. - TYPICAL.
R.C. - REINFORCED CONCRETE
P.C.C - PLAIN CEMENT CONCRETE
MKD. - MARKED.
THK. - THICK
B/W - BOTH WAYS
BOTTOM REINFORCEMENT (B) - ———
TOP REINFORCEMENT (T) - – – – – –

NOTES :-

1. ALL DIMENSIONS ARE IN MILLIMETRES AND LEVELS AND CO-ORDINATES ARE IN METRES. UNLESS OTHERWISE STATED.
2. GRADE OF CONCRETE SHALL BE C35 FOR FOUNDATION.
3. GRADE OF REINFORCEMENT SHALL BE DEFORMED BAR ASTM A615 - GRADE 60 (fy = 420 MPa).
4. CLEAR COVER TO MAIN REINFORCEMENT SHALL BE AS a) WALL = 40mm
5. MINIMUM LAP LENGTH OF REINFORCEMENT SHALL BE 40 X DIA. OF BAR.
6. QUICK SETTING ADMIXTURE SHALL BE USED FOR REDUCING THE SETTING TIME OF THE CONCRETE.
7. DO NOT SCALE. PLEASE ASK.
8. READ THIS DRAWING IN CONJUNCTION WITH DRG: MD-216-3110-EG-CV-GAD-1012
9. FOR STANDARD REINFORCEMENT DETAILS REFER DWG. NO. MD-216-1000-EG-CV-DED-1005.

DOCUMENT NUMBER	REFERENCE DOCUMENTS	REV	DATE	REVISION DESCRIPTION	DRN	CHK	ENG	APP	EMP
		D01	22/01/2024	AS BUILT	SBH	BDA	STY	AG	
		C01	26/10/2022	ISSUED FOR CONSTRUCTION	SBH	BDA	STY	AG	
		A02	16/09/2022	REVISED AS PER EMPLOYER'S COMMENTS	SBH	BDA	STY	AG	
				ON 05/09/2022 AND REVISED AS MARKED A02					
		A01	28/07/2022	ISSUED FOR APPROVAL	SBH	BDA	STY	AG	

RESERVED FOR VENDOR LOGO AND DRAWING NUMBER

LARSEN & TOUBRO

This drawing is the property of LARSEN & TOUBRO and must not be passed on to any person or body not authorized by us to receive it nor be copied or otherwise made use either in full or in part by such person or body without our prior permission in writing.

Outotec

The content of these documents are the sole property of Outotec Oyj. Any rights not expressly granted herein are reserved. Reproduction, transfer or distribution of part or all of the contents in any form without prior written permission of Outotec is prohibited.

MA'ADEN معادن
Saudi Arabian Mining Company شركة التعدين العربية السعودية

This document and the information contained herein is Ma'aden proprietary know-how. This document or any part thereof should not be reproduced, stored in a retrieval system or transmitted by any means, electronic or otherwise, or divulged without prior written permission of Ma'aden.

LARSEN & TOUBRO DRAWING NUMBER: O19045_100_C_D_24060_004 — REVISION: 3
OUTOTEC DRAWING NUMBER: 900707__GAU01__ZC01__CTB17__31308 — DOCUMENT ID: OU100760090 — REVISION: 3

DRAWN	SBH	25/07/2022
CHECKED	BDA	26/07/2022
ENGINEER	STY	27/07/2022
APPROVED	AG	28/07/2022
EMPLOYER		
SCALE	1:100, 1:50	A1

MANSOURAH - MASSARAH GOLD PROJECT
DETAIL DRAWING
PRIMARY CRUSHING
MODIFICATION OF CRUSHER SUPPORTING STRUCTURE

DRAWING NUMBER: MD-216-3110-EG-CV-DED-1007 — REV: D01