


DRAWING NUMBER: MD-216-3110-EG-CV-GAD-1001 | REV: D01

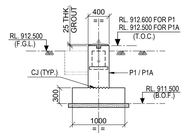


SECTION 1-1
(SCALE-1:40)

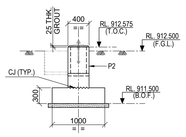


SECTION 2-2
(SCALE-1:40)

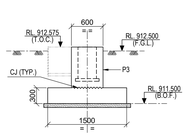


SECTION 3-3
(SCALE-1:40)

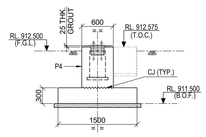


SECTION 4-4
(SCALE-1:40)

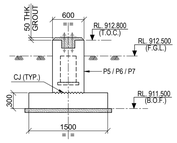


SECTION 5-5
(SCALE-1:40)

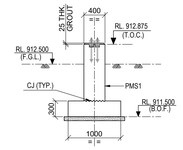


SECTION 1A-1A
(SCALE-1:40)

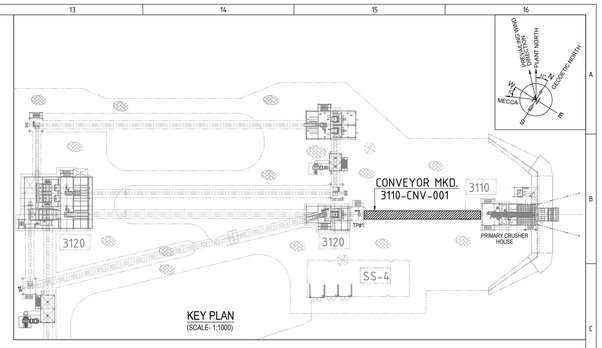


KEY PLAN
(SCALE- 1:1000)

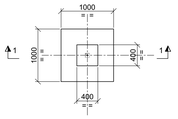


DETAIL OF FOUNDATION MKD. F1
(SCALE-1:40)

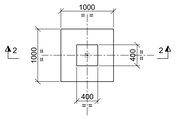


DETAIL OF FOUNDATION MKD. F2
(SCALE-1:40)

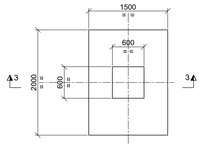


DETAIL OF FOUNDATION MKD. F3
(SCALE-1:40)

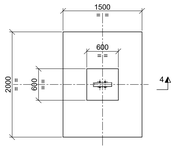

DETAIL OF FOUNDATION MKD. F4
(SCALE-1:40)

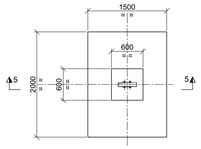


DETAIL OF FOUNDATION MKD. F5
(SCALE-1:40)

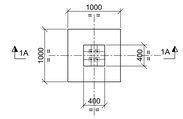

DETAIL OF FOUNDATION MKD. F1A
(SCALE-1:40)

SCHEDULE OF BEAM


BEAM MKD.	SIZE		LEVEL
	WIDTH (mm.)	DEPTH (mm.)	
TB1	250	300	RL. 912.500 (T.O.B.)
TB1A	300	400	RL. 912.500 (T.O.B.)
TB2	350	500	RL. 912.575 (T.O.B.)
TB2A	300	400	RL. 912.500 (T.O.B.)
TB3	350	600	RL. 912.575 (T.O.B.)
TB3A	300	500	RL. 912.575 (T.O.B.)
TB4	300	500	RL. 912.500 (T.O.B.)

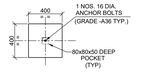

DETAIL OF PEDESTAL MKD. P1
(SCALE-1:20)




DETAIL OF PEDESTAL MKD. P1A
(SCALE-1:20)

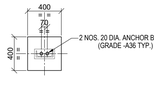


DETAIL OF PEDESTAL MKD. P2
(SCALE-1:25)




DETAIL OF PEDESTAL MKD. P3
(SCALE-1:25)

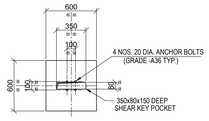


DETAIL OF PEDESTAL MKD. P4 & P5
(SCALE-1:25)

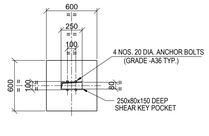

DETAIL OF PEDESTAL MKD. P6
(SCALE-1:25)

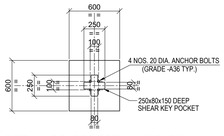


DETAIL OF PEDESTAL MKD. P7
(SCALE-1:25)

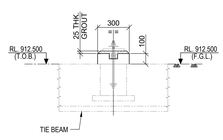


SECTION Z-Z
(SCALE-1:20)


LAYOUT OF FOUNDATION AND TIE BEAM
(SCALE-1:75)

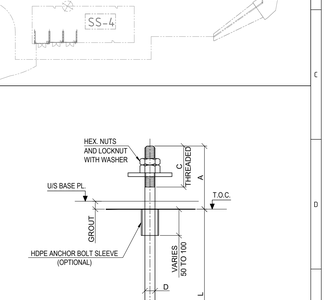


TYP. DETAIL OF BOLT

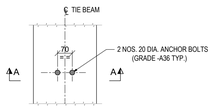


DETAIL - 'X'
(SCALE 1:10)

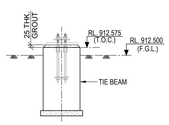


SECTION A-A
(SCALE-1:20)

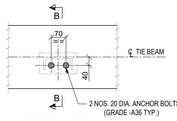


DETAIL - 'W1'
(SCALE 1:10)

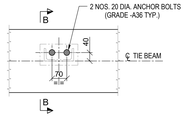


DETAIL - 'W2'
(SCALE 1:10)

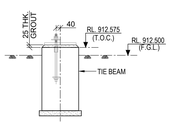

SECTION B-B
(SCALE-1:20)

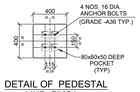

DETAIL OF PEDESTAL MKD. PMS1
(SCALE-1:20)

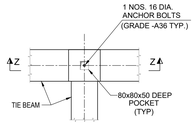

DETAIL - 'Y'
(TYP. DETAIL OF PEDESTAL MKD. SP1)
(SCALE 1:20)

SCHEDULE OF BOLTS

D BOLT DIA. MM	BxB BOTTOM PLATE (SQUARE) SQ MM	DIMENSIONS (MM)				
		L	A	C	T	H
16	50x50	350	120	90	10	30
20	60x60	450	160	130	10	30

LEGEND :-

R.L - REDUCED LEVEL
℄ - CENTRE LINE
CJ - CONSTRUCTION JOINT
FDN. - FOUNDATION.
T.O.C. - TOP OF CONCRETE.
F.G.L. - FINISHED GROUND LEVEL.
F.F.L. - FINISHED FLOOR LEVEL
B.O.F. - BOTTOM OF FOUNDATION
TYP. - TYPICAL.
B.O.B. - BOTTOM OF BEAM.
B.O.M. - BOTTOM OF MONORAIL.
R.C.C. - REINFORCED CEMENT CONCRETE
P.C.C. - PLAIN CEMENT CONCRETE
IP. - INSERT PLATE
MKD. - MARKED.
THK. - THICK

NOTES :-

1. ALL DIMENSIONS ARE IN MILLIMETRES AND LEVELS AND CO-ORDINATES ARE IN METRES. UNLESS OTHERWISE STATED.
2. GRADE OF CONCRETE SHALL BE C25 FOR FOUNDATION.
3. GRADE OF REINFORCEMENT SHALL BE DEFORMED BAR ASTM A615 - GRADE 60 (fy = 420 MPa).
4. NET SAFE BEARING CAPACITY OF SOIL AT BOTTOM OF FOUNDATION CONSIDERED 500KN/ SQ. M.
5. CLEAR COVER TO MAIN REINFORCEMENT SHALL BE AS
   a) FOUNDATION = 75 mm (BOTTOM & SIDE) 50 mm. (TOP)
   b) COLUMN & PEDESTAL = 50mm
   c) BEAM = 50mm
   d) SLAB = 40mm
6. FOR MINIMUM LAP LENGTH OF REINFORCEMENT AND OTHER GENERAL NOTES FOR CIVIL WORKS REFER STANDARD DRG : MD-216-1000-EG-CV-DED-1001
7. THIS DRAWING IS TO BE READ IN CONJUNCTION WITH DRAWING MD - 216 - 3110 -EG -ST - GAD - 1001 TO MD - 216 - 3110 -EG -ST - GAD - 1002
8. ALL STRUCTURAL WORK SHALL CONFORM TO CIVIL STRUCTURAL DESIGN CRITERIA NO. MD - 216 - 1000 -EG -ST - CRT - 1001
9. FOR OTHER STANDARD REINFORCEMENT DETAILS REFER DRG : MD-216-1000-EG-CV-DED-1005

REV	DATE	REVISION DESCRIPTION	DRN	CHK	ENG	APP	EMP
D01	10/03/2023	AS-BUILT	APM	BDA	STY	AG	
C03	12/12/2020	ISSUED FOR CONSTRUCTION, HOLD RELEASED	HSK	SBY	APL	PRI	
C02	31/10/2020	ISSUED FOR CONSTRUCTION, HOLD RELEASED & REVISED AS MKD. C03	HSK	SBY	APL	PRI	
C01	27/04/2020	ISSUED FOR CONSTRUCTION, REVISED AS PER EMPLOYER COMMENTS DATED 23/04/2020 & INTERNALLY REVISED AS MKD. C01	AMJ	SBY	APL	PRI	
A01	31/03/2020	ISSUED FOR REFERENCE	AMJ	SBY	APL	PRI	

DOCUMENT NUMBER	REFERENCE DOCUMENTS
MD-216-3110-EG-ME-ELV-1002	PRIMARY CRUSHING CONV. 3110-CNV-001 - ELEVATION
MD-216-3110-EG-ME-ELV-1001	PRIMARY CRUSHING CONV. 3110-CNV-001 - ELEVATION
MD-216-3110-EG-ME-LPX-1003	PRIMARY CRUSHING CONV. 3110-CNV-001 - PLAN VIEW

DOCUMENT NUMBER	REFERENCE DOCUMENTS	REV	DATE	REVISION DESCRIPTION	DRN	CHK	ENG	APP	EMP

RESERVED FOR VENDOR LOGO AND DRAWING NUMBER

LARSEN & TOUBRO
This drawing is the property of LARSEN & TOUBRO and must not be passed on to any person or body not authorized by us to receive it nor be copied or otherwise made use either in full or in part by such person or body without our prior permission in writing.

Outotec
The content of these documents are the sole property of Outotec Oyj. Any rights not expressly granted herein are reserved. Reproduction, transfer or distribution of part or all of the contents in any form without prior written permission of Outotec is prohibited.

MA'ADEN معادن Saudi Arabian Mining Company شركة المعادن العربية السعودية
This document and the information contained herein is Ma'aden proprietary know-how. This document or any part thereof should not be reproduced, stored in a retrieval system or transmitted by any means, electronic or otherwise, or divulged without prior written permission of Ma'aden.

LARSEN & TOUBRO DRAWING NUMBER: 019045_100_C_G_24056_001 | REVISION: 4
OUTOTEC DRAWING NUMBER: 900707__GAU01__ZC01__MTL01__31126 | DOCUMENT ID: OU100668752 | REVISION: 4

DRAWN	AMJ	29/03/2020
CHECKED	SBY	30/03/2020
ENGINEER	APL	28/03/2020
APPROVED	PRI	31/03/2020
EMPLOYER		

MANSOURAH - MASSARAH GOLD PROJECT
GENERAL ARRANGEMENT DRAWING
GA OF CONVEYOR 3110-CNV-001
LAYOUT & DETAIL

SCALE: 1:100,50,20,10 | A0
DRAWING NUMBER: MD - 216 - 3110 - EG - CV - GAD - 1001 | REV: D01