

DRAWING NUMBER: MD-216-3110-EG-CV-GAD-1002 | REV: D01

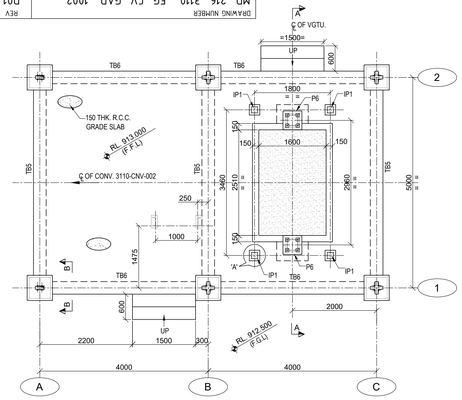

PLAN OF GRADE SLAB AT RL. 913.000 AND TIE BEAM AT RL. 912.850 (T.O.B) (FOR VGTU TOWER)


(SCALE-1:50)

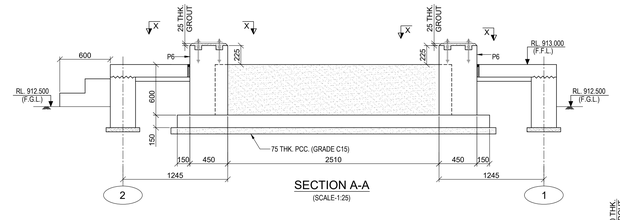


SECTION A-A

(SCALE-1:25)

SCHEDULE OF BOLTS						
D BOLT DIA. MM	BxB BOTTOM PLATE (SQUARE) SQ MM	DIMENSIONS (MM)				
		L	A	C	T	H
16	50x50	350	120	90	10	30
20	60x60	450	160	130	10	30
24	75x75	600	175	125	12	30

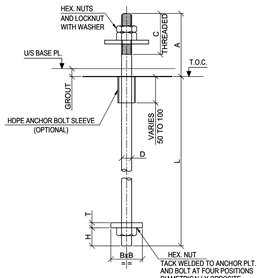


TYP. DETAIL OF BOLT

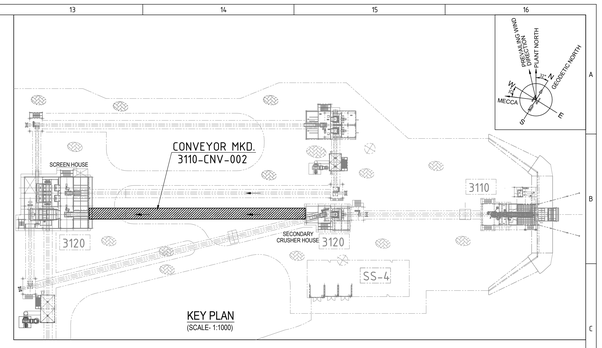


KEY PLAN

(SCALE- 1:1000)

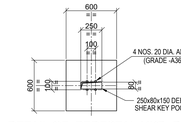


DETAIL OF PEDESTAL MKD. P1

(SCALE-1:25)

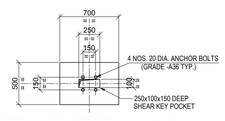


DETAIL OF PEDESTAL MKD. P2

(SCALE-1:25)

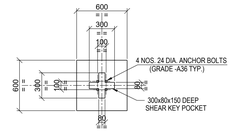


DETAIL OF PEDESTAL MKD. P3

(SCALE-1:25)

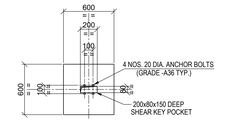


DETAIL OF PEDESTAL MKD. P4

(SCALE-1:25)

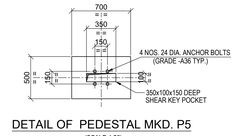

DETAIL OF PEDESTAL MKD. P5


(SCALE-1:25)

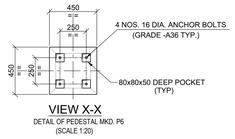

VIEW X-X


DETAIL OF PEDESTAL MKD. P6

(SCALE 1:20)

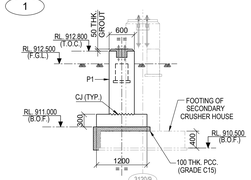


SECTION 1-1

(SCALE-1:50)

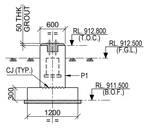


SECTION 2-2

(SCALE-1:50)

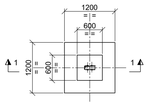


DETAIL OF FOUNDATION MKD. F1

(SCALE-1:50)

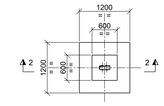


DETAIL OF FOUNDATION MKD. F2

(SCALE-1:50)

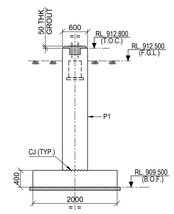


SECTION 3-3

(SCALE-1:50)

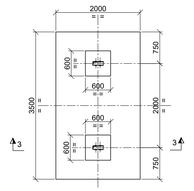


DETAIL OF FOUNDATION MKD. F3

(SCALE-1:50)

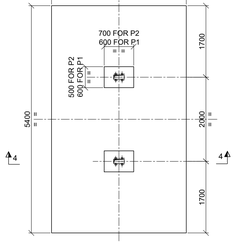


DETAIL OF FOUNDATION MKD. F4

(SCALE-1:50)

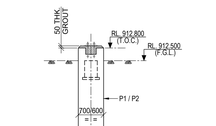


SECTION 4-4

(SCALE-1:50)

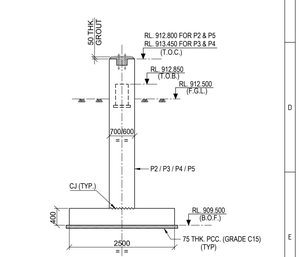


SECTION 5-5

(SCALE-1:50)

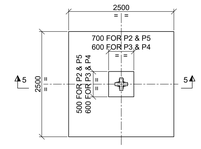

DETAIL OF FOUNDATION MKD. F5

(SCALE-1:50)

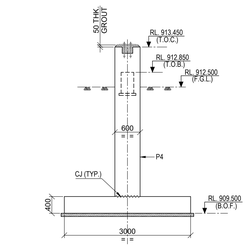


SECTION 6-6

(SCALE-1:50)


DETAIL OF FOUNDATION MKD. F6

(SCALE-1:50)

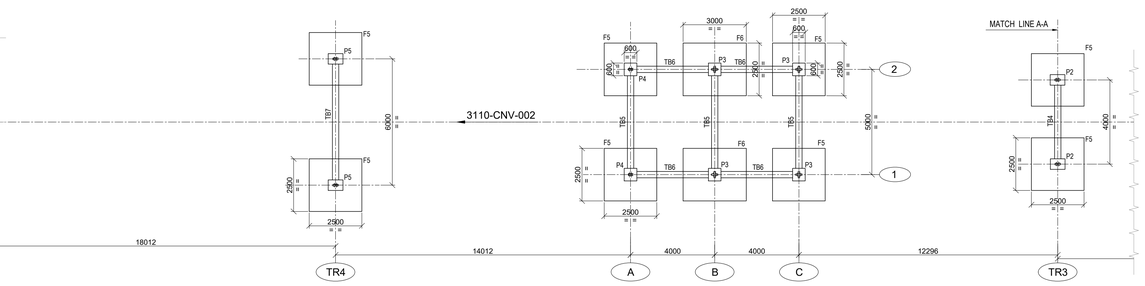


LAYOUT OF FOUNDATION

(SCALE-1:100)

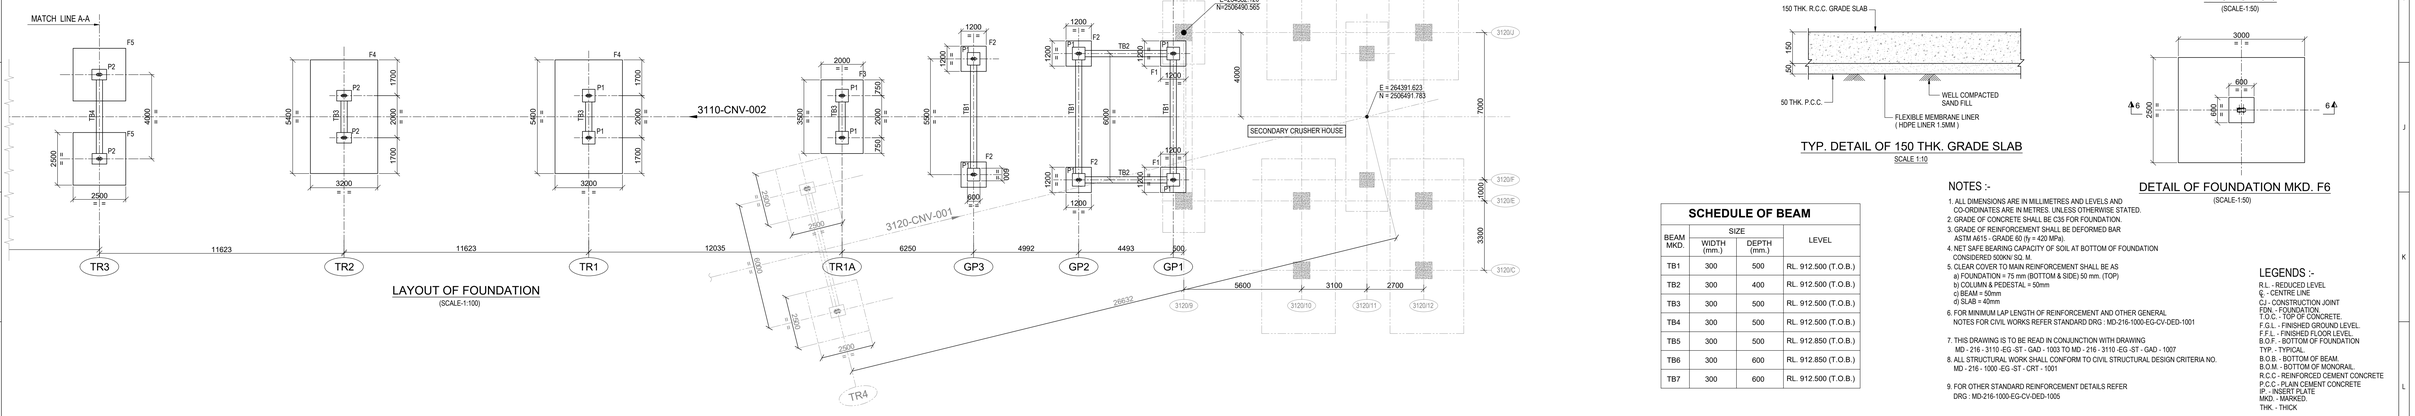

LAYOUT OF FOUNDATION

(SCALE-1:100)

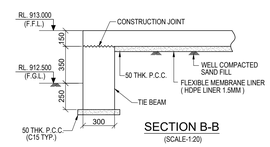

SECTION B-B

(SCALE-1:20)

TYP. DETAIL OF 150 THK. GRADE SLAB

SCALE 1:10

SCHEDULE OF BEAM			
BEAM MKD.	SIZE		LEVEL
	WIDTH (mm.)	DEPTH (mm.)	
TB1	300	500	RL. 912.500 (T.O.B.)
TB2	300	400	RL. 912.500 (T.O.B.)
TB3	300	500	RL. 912.500 (T.O.B.)
TB4	300	500	RL. 912.500 (T.O.B.)
TB5	300	500	RL. 912.850 (T.O.B.)
TB6	300	600	RL. 912.850 (T.O.B.)
TB7	300	600	RL. 912.500 (T.O.B.)

NOTES :-

1. ALL DIMENSIONS ARE IN MILLIMETRES AND LEVELS AND CO-ORDINATES ARE IN METRES. UNLESS OTHERWISE STATED.
3. GRADE OF REINFORCEMENT SHALL BE DEFORMED BAR ASTM A615 - GRADE 60 (fy = 420 MPa).
4. NET SAFE BEARING CAPACITY OF SOIL AT BOTTOM OF FOUNDATION CONSIDERED 500KN/ SQ. M.
5. CLEAR COVER TO MAIN REINFORCEMENT SHALL BE AS
   a) FOUNDATION = 75 mm (BOTTOM & SIDE) 50 mm. (TOP)
   b) COLUMN & PEDESTAL = 50mm
   c) BEAM = 50mm
   d) SLAB = 40mm
6. FOR MINIMUM LAP LENGTH OF REINFORCEMENT AND OTHER GENERAL NOTES FOR CIVIL WORKS REFER STANDARD DRG : MD-216-1000-EG-CV-DED-1001
7. THIS DRAWING IS TO BE READ IN CONJUNCTION WITH DRAWING MD - 216 - 3110 -EG -ST - GAD - 1003 TO MD - 216 - 3110 -EG -ST - GAD - 1007
8. ALL STRUCTURAL WORK SHALL CONFORM TO CIVIL STRUCTURAL DESIGN CRITERIA NO. MD - 216 - 1000 -EG -ST - CRT - 1001
9. FOR OTHER STANDARD REINFORCEMENT DETAILS REFER DRG : MD-216-1000-EG-CV-DED-1005

LEGENDS :-

R.L. - REDUCED LEVEL
℄ - CENTRE LINE
CJ - CONSTRUCTION JOINT
FDN. - FOUNDATION.
T.O.C. - TOP OF CONCRETE.
F.G.L. - FINISHED GROUND LEVEL.
F.F.L. - FINISHED FLOOR LEVEL
B.O.F. - BOTTOM OF FOUNDATION
TYP. - TYPICAL
B.O.B. - BOTTOM OF BEAM.
B.O.M. - BOTTOM OF MONORAIL.
R.C.C. - REINFORCED CEMENT CONCRETE
P.C.C. - PLAIN CEMENT CONCRETE
IP - INSERT PLATE
MKD. - MARKED.
THK. - THICK

REV	DATE	REVISION DESCRIPTION	DRN	CHK	ENG	APP	EMP	DOCUMENT NUMBER	REFERENCE DOCUMENTS
D01	10/03/2023	AS-BUILT	AMJ	SBY	APL	PRI			
C03	06/01/2021	ISSUED FOR CONSTRUCTION, REVISED AS MKD. (C03)	AMJ	SBY	APL	PRI			
C02	12/12/2020	ISSUED FOR CONSTRUCTION, REVISED AS MKD. (C02)	AMJ	SBY	APL	PRI		MD-216-3110-EG-ME-ELV-1006	PRIMARY CRUSHING CONV. 3110-CNV-002 - ELEVATION
C01	18/05/2020	ISSUED FOR CONSTRUCTION, REVISED AS PER EMPLOYER	AMJ	SBY	APL	PRI		MD-216-3110-EG-ME-ELV-1005	PRIMARY CRUSHING CONV. 3110-CNV-002 - ELEVATION
		COMMENTS DATED 14/05/2020 & REVISED AS MKD. (C01)						MD-216-3110-EG-ME-ELV-1004	PRIMARY CRUSHING CONV. 3110-CNV-002 - ELEVATION
A01	07/04/2020	ISSUED FOR REFERENCE	AMJ	SBY	APL	PRI		MD-216-3110-EG-ME-LPX-1004	PRIMARY CRUSHING CONV. 3110-CNV-002 - PLAN VIEW

RESERVED FOR VENDOR LOGO AND DRAWING NUMBER

LARSEN & TOUBRO

This drawing is the property of LARSEN & TOUBRO and must not be passed on to any person or body not authorized by us to receive it nor be copied or otherwise made use either in full or in part by such person or body without our prior permission in writing.

Outotec

The content of these documents are the sole property of Outotec Oyj. Any rights not expressly granted herein are reserved. Reproduction, transfer or distribution of part or all of the contents in any form without prior written permission of Outotec is prohibited.

MA'ADEN معادن Saudi Arabian Mining Company شركة المعادن العربية السعودية

This document and the information contained herein is Ma'aden proprietary know-how. This document or any part thereof should not be reproduced, stored in a retrieval system or transmitted by any means, electronic or otherwise, or divulged without prior written permission of Ma'aden.

LARSEN & TOUBRO DRAWING NUMBER	019045_100_C_G_24056_002	REVISION 4
OUTOTEC DRAWING NUMBER	900707__GAU01__ZC01__MTL01__31127	DOCUMENT ID OU100668753 / REVISION 4
DRAWN	AMJ	05/04/2020
CHECKED	SBY	06/04/2020
ENGINEER	APL	04/04/2020
APPROVED	PRI	07/04/2020
EMPLOYER		
SCALE	1:100,50,20,10	A0

MANSOURAH - MASSARAH GOLD PROJECT
GENERAL ARRANGEMENT DRAWING
GA OF CONVEYOR 3110-CNV-002
LAYOUT & DETAIL

DRAWING NUMBER: MD - 216 - 3110 - EG - CV - GAD - 1002 | REV: D01