


DRAWING NUMBER MD-216-3110-EG-CV-GAD-1005 REV D01

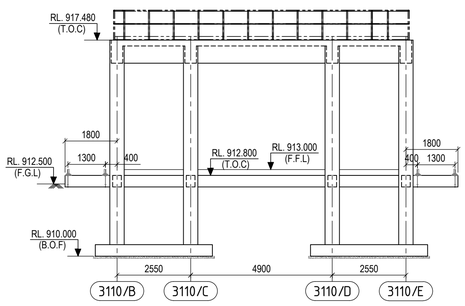


ELEVATION AT GRID - 3110/1
(SCALE 1:100)

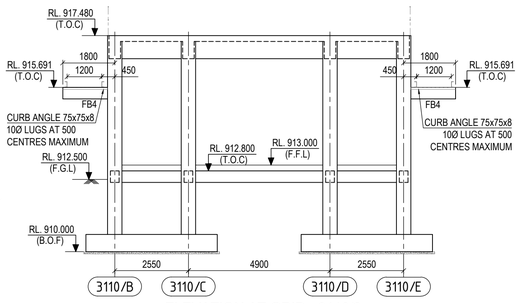


ELEVATION AT GRID - 3110/2
(SCALE 1:100)

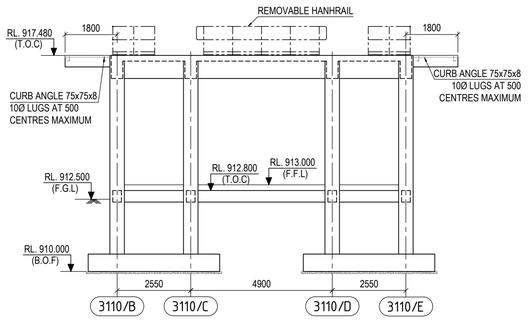


ELEVATION AT GRID - 3110/3
(SCALE 1:100)

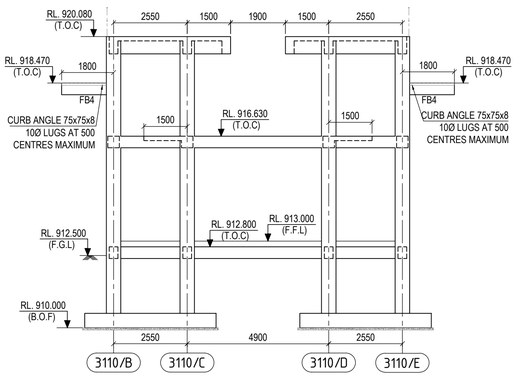


ELEVATION AT GRID - 3110/4
(SCALE 1:100)

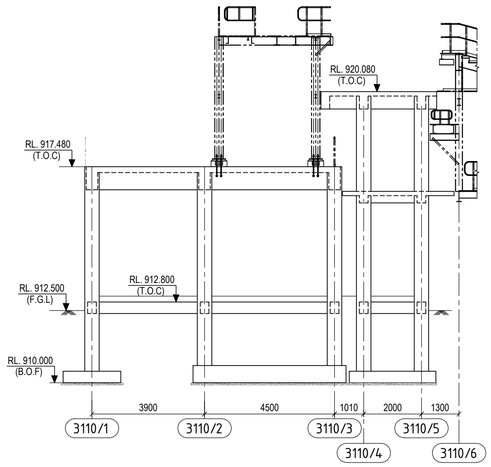


ELEVATION AT GRID - 3110/D
(SCALE 1:100)

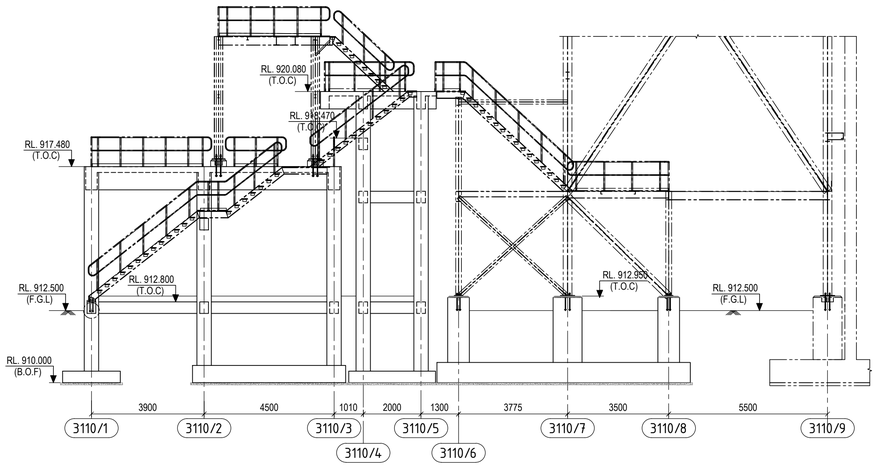


ELEVATION AT GRID - 3110/E
(SCALE 1:100)

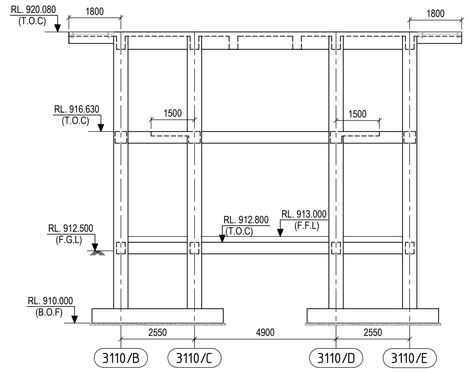


ELEVATION AT GRID - 3110/5
(SCALE 1:100)

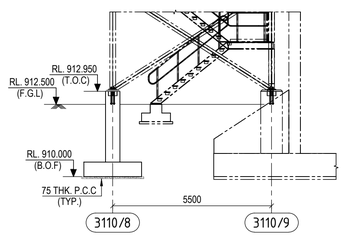

ELEVATION AT GRID - 3110/A
(SCALE 1:100)

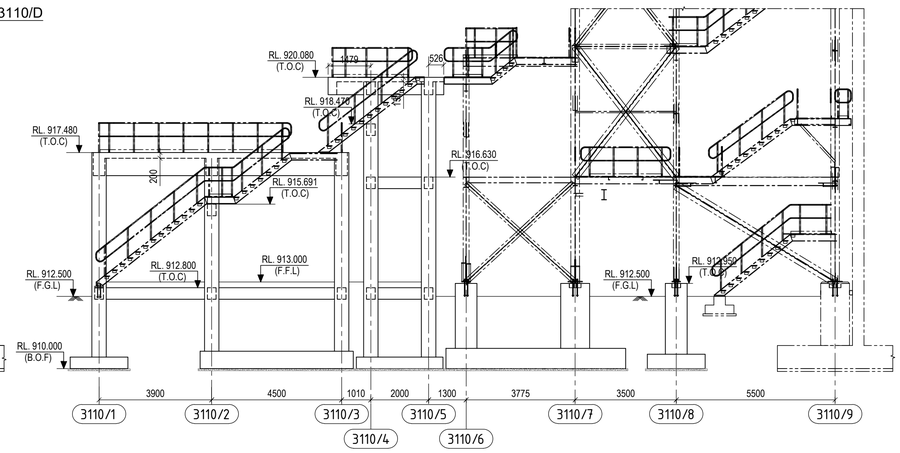

ELEVATION AT GRID - 3110/B
(SCALE 1:100)

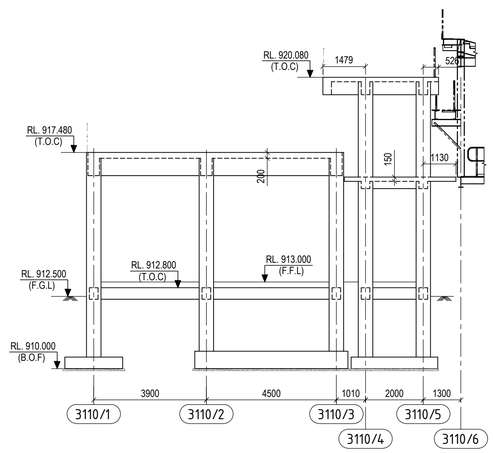

ELEVATION AT GRID - 3110/C
(SCALE 1:100)

LEGEND :-

RL. - REDUCED LEVEL
F.G.L - FINISHED GROUND LEVEL
F.F.L - FINISHED FLOOR LEVEL
P.C.C - PLAIN CEMENT CONCRETE
T.O.C - TOP OF CONCRETE
B.O.F - BOTTOM OF FOUNDATION
℄ - CENTRE LINE
THK. - THICK
TYP. - TYPICAL
MKD. - MARKED
PL. - PLATE
Ø - DIAMETER

NOTES:-

1. ALL DIMENSIONS ARE IN MILLIMETRES AND LEVELS ARE IN METRES UNLESS OTHERWISE STATED.
2. GRADE OF CONCRETE SHALL BE C35 .
3. GRADE OF REINFORCEMENT SHALL BE DEFORMED BAR 420 MPa (GRADE 60)
4. NET SAFE BEARING CAPACITY CONSIDERED AT THE FOUNDING LEVEL IS570 KN/SQ. M
5. IF ANY PART OF FOUNDATION COMES ON BACKFILL ZONE OF ADJACENT FOUNDATION OR ANY LOOSE PACKETS ARE ENCOUNTERED BELOW FOUNDATION LEVEL THE SAME SHALL BE REMOVED AND FILLED WITH PCC.
6. FOR DETAIL OF HANDRAIL FIXING REFER STANDARD DRAWING.
7. READ THIS DRAWING IN CONJUNCTION WITH DRAWING NO. MD - 216 - 3110 - EG - CV - GAD - 1004 & 1006.

DOCUMENT NUMBER	REFERENCE DOCUMENTS	REV	DATE	REVISION DESCRIPTION	DRN	CHK	ENG	APP	EMP
MD-216-3110-EG-ME-ELV-1009	PRIMARY CRUSHER HOUSE-SECTION								
MD-216-3110-EG-ME-ELV-1008	PRIMARY CRUSHER HOUSE-SECTION	D01	10/03/2023	AS-BUILT	APM	BDA	STY	AG	
MD-216-3110-EG-ME-ELV-1007	PRIMARY CRUSHER HOUSE-ELEVATION	C02	19/10/2020	ISSUED FOR CONSTRUCTION AND REVISED AS MKD. C02	APM	BDA	STY	AG	
MD-216-3110-EG-ME-LPX-1002	PRIMARY CRUSHER HOUSE-PLAN VIEW	C01	27/03/2020	ISSUED FOR CONSTRUCTION	APM	BDA	STY	AG	
MD-216-3110-EG-ME-LPX-1001	PRIMARY CRUSHER HOUSE-PLAN VIEW	A01	17/02/2020	ISSUED FOR REFERENCE	APM	BDA	STY	AG	

RESERVED FOR VENDOR LOGO AND DRAWING NUMBER

LARSEN & TOUBRO

This drawing is the property of LARSEN & TOUBRO and must not be passed on to any person or body not authorized by us to receive it nor be copied or otherwise made use either in full or in part by such person or body without our prior permission in writing.

Outotec

The content of these documents are the sole property of Outotec Oyj. Any rights not expressly granted herein are reserved. Reproduction, transfer or distribution of part or all of the contents in any form without prior written permission of Outotec is prohibited.

MA'ADEN معادن
Saudi Arabian Mining Company شركة المعادن العربية السعودية

This document and the information contained herein is Ma'aden proprietary know-how. This document or any part thereof should not be reproduced, stored in a retrieval system or transmitted by any means, electronic or otherwise, or divulged without prior written permission of Ma'aden.

LARSEN & TOUBRO DRAWING NUMBER: 019045_100_C_G_24059_003 — REVISION: 3
OUTOTEC DRAWING NUMBER: 900707__GAU01__ZC01__MTL01__31149 — DOCUMENT ID: OU100671499 — REVISION: 3

DRAWN	APM	11/02/2020
CHECKED	BDA	13/02/2020
ENGINEER	STY	15/02/2020
APPROVED	AG	17/02/2020
EMPLOYER		
SCALE	1:100, 1:50	A1

MANSOURAH - MASSARAH GOLD PROJECT
GENERAL ARRANGEMENT DRAWING
PRIMARY CRUSHING
ELEVATIONS & SECTIONS

DRAWING NUMBER: MD-216-3110-EG-CV-GAD-1005 — REV: D01