


DRAWING NUMBER MD-216-3110-EG-CV-GAD-1008 REV D01

 


PLAN OF SANDPIT
(SCALE-1:25)

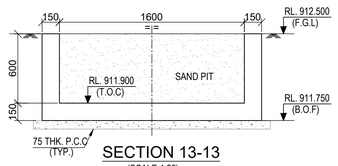


SECTION 13-13
(SCALE-1:25)

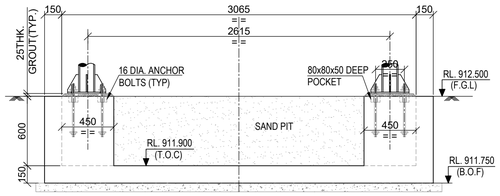

SECTION 14-14
(SCALE-1:25)

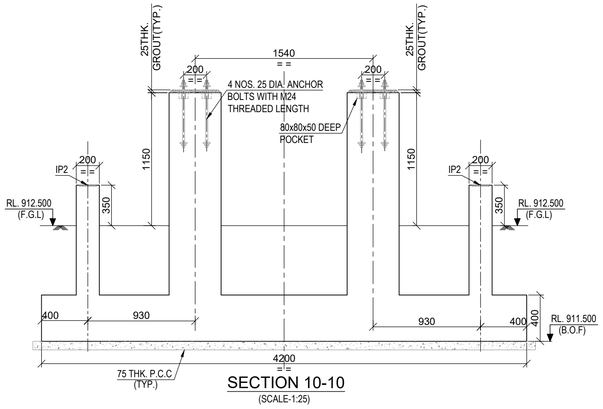


SECTION 10-10
(SCALE-1:25)

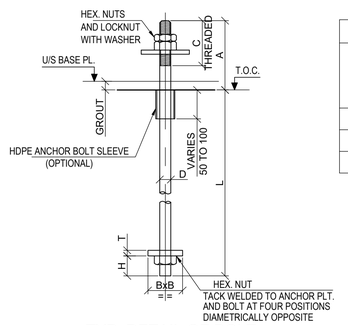


TYP. DETAIL OF BOLT
(SCALE-1:25)

SCHEDULE OF BOLTS (GRADE - A36)


D BOLT DIA. MM	BxB BOTTOM PLATE (SQUARE) SQ MM	DIMENSIONS (MM)				
		L	A	C	T	H
16	50x50	350	150	125	10	30
20	60x60	450	150	125	10	30
25	75x75	475	175	150	12	30

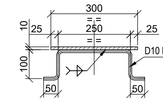


SECTION 20-20
(SCALE 1:10)

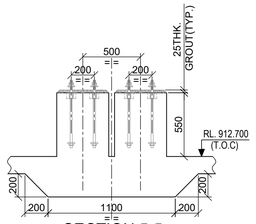


SECTION 5-5
(SCALE-1:25)

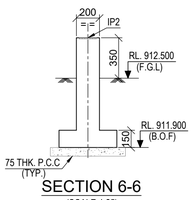


SECTION 6-6
(SCALE-1:25)

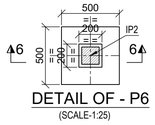


DETAIL OF - P6
(SCALE-1:25)

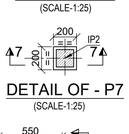


DETAIL OF - P7
(SCALE-1:25)

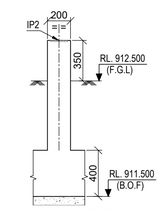


SECTION 7-7
(SCALE-1:25)

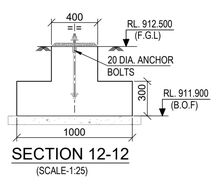


SECTION 12-12
(SCALE-1:25)

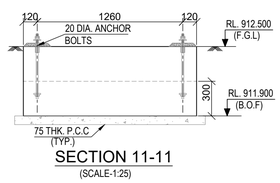


SECTION 11-11
(SCALE-1:25)

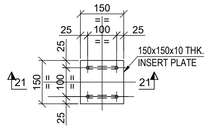


DETAIL OF INSERT PLATE - IP2
(SCALE 1:10)

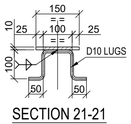


SECTION 21-21
(SCALE 1:10)

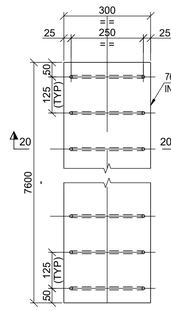


DETAIL OF INSERT PLATE - IP1
(SCALE 1:10)

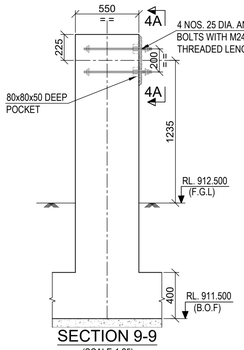


SECTION 9-9
(SCALE-1:25)

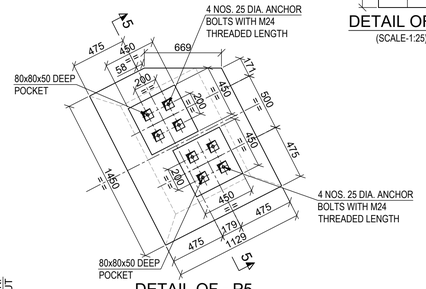


DETAIL OF - P5
(SCALE-1:25)

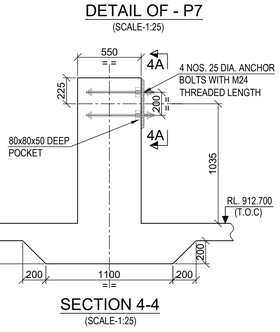

SECTION 4-4
(SCALE-1:25)

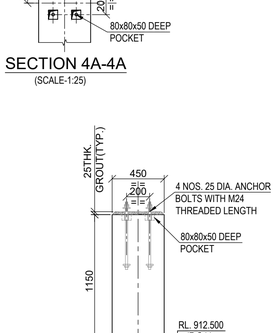


SECTION 8-8
(SCALE-1:25)

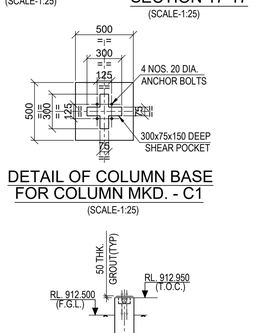


DETAIL OF COLUMN BASE FOR COLUMN MKD. - C1
(SCALE-1:25)

R.C DTAIL OF SECTION 15-15
(SCALE 1:75)


DETAIL OF FOUNDATION - F1
(SCALE 1:75)

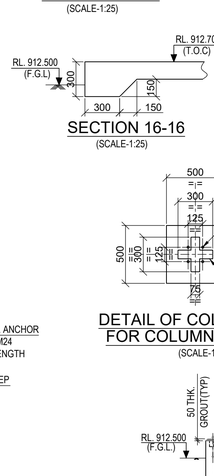

SECTION 16-16
(SCALE-1:25)

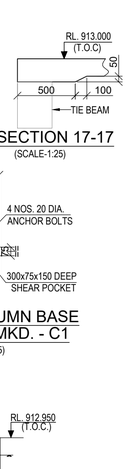


SECTION 17-17
(SCALE-1:25)

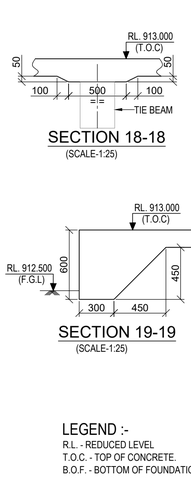


SECTION 18-18
(SCALE-1:25)


SECTION 19-19
(SCALE-1:25)

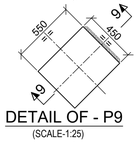


DETAIL OF - P9
(SCALE-1:25)

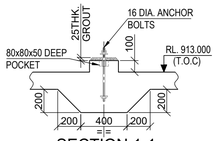


SECTION 1-1
(SCALE-1:25)

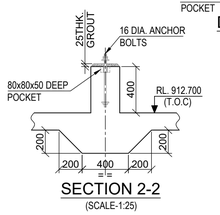


SECTION 2-2
(SCALE-1:25)

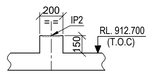


SECTION 3-3
(SCALE-1:25)

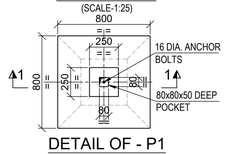


DETAIL OF - P1
(SCALE-1:25)

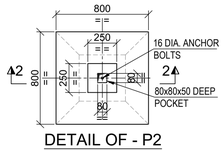


DETAIL OF - P2
(SCALE-1:25)

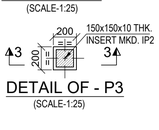

DETAIL OF - P3
(SCALE-1:25)

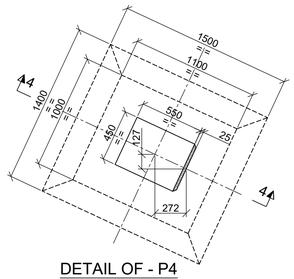

DETAIL OF - P4
(SCALE-1:25)

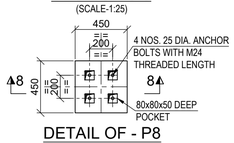

DETAIL OF - P8
(SCALE-1:25)

LEGEND :-

R.L. - REDUCED LEVEL.
T.O.C. - TOP OF CONCRETE.
B.O.F. - BOTTOM OF FOUNDATION
F.G.L. - FINISHED GROUND LEVEL
TYP. - TYPICAL.
P.C.C - PLAIN CEMENT CONCRETE
MKD. - MARKED.
THK. - THICK
Ç - CENTRE LINE
PL. - PLATE

NOTES:-

1. ALL DIMENSIONS ARE IN MILLIMETRES AND LEVELS ARE IN METRES UNLESS OTHERWISE STATED.
2. GRADE OF CONCRETE SHALL BE C35 UNLESS NOTED OTHERWISE.
3. GRADE OF REINFORCEMENT SHALL BE DEFORMED BAR ASTM A615-GRADE 60 (fy=420 MPa)
4. NET SAFE BEARING CAPACITY CONSIDERED AT THE FOUNDING LEVEL IS 460 KN/SQ. M
5. IF ANY PART OF FOUNDATION COMES ON BACKFILL ZONE OF ADJACENT FOUNDATION OR ANY LOOSE POCKETS ARE ENCOUNTERED BELOW FOUNDATION LEVEL THE SAME SHALL BE REMOVED AND FILLED WITH PCC.
6. FOR DETAIL DRAWING REFER DRG. NO. MD-216-3110-EG-CV-DED-1005.
7. THIS DRAWING SHOULD READ IN CONJUNCTION WITH DRG. NO : MD-216-3110-EG-CV-GAD-1007.
8. FOR STANDARD DETAILS FOR PAVING REF. DRG. NO : MD-216-1000-EG-CV-DED-1002.

DOCUMENT NUMBER	REFERENCE DOCUMENTS	REV	DATE	REVISION DESCRIPTION	DRN	CHK	ENG	APP	EMP
		D01	10/03/2023	AS-BUILT	APM	BDA	STY	AG	
		C01	16/05/2020	ISSUED FOR CONSTRUCTION AND REVISED AS MKD. C01	APM	BDA	STY	AG	
		A01	18/04/2020	ISSUED FOR REFERENCE	APM	BDA	STY	AG	

RESERVED FOR VENDOR LOGO AND DRAWING NUMBER

LARSEN & TOUBRO

This drawing is the property of LARSEN & TOUBRO and must not be passed on to any person or body not authorized by us to receive it nor be copied or otherwise made use either in full or in part by such person or body without our prior permission in writing.

Outotec

The content of these documents are the sole property of Outotec Oyj. Any rights not expressly granted herein are reserved. Reproduction, transfer or distribution of part or all of the contents in any form without prior written permission of Outotec is prohibited.

MA'ADEN معادن
Saudi Arabian Mining Company شركة معادن العربية السعودية

This document and the information contained herein is Ma'aden proprietary know-how. This document or any part thereof should not be reproduced, stored in a retrieval system or transmitted by any means, electronic or otherwise, or divulged without prior written permission of Ma'aden.

LARSEN & TOUBRO DRAWING NUMBER: 019045_100_C_G_24059_006 — REVISION: 2
OUTOTEC DRAWING NUMBER: 900707__GAU01__ZC01__MTL01__31160 — DOCUMENT ID: OU10680993 — REVISION: 2

DRAWN	APM	10/04/2020
CHECKED	BDA	16/04/2020
ENGINEER	STY	12/04/2020
APPROVED	AG	18/04/2020
EMPLOYER		
SCALE	1:100, 1:50	A1

MANSOURAH - MASSARAH GOLD PROJECT
GENERAL ARRANGEMENT DRAWING
PRIMARY CRUSHING
SECTIONS

DRAWING NUMBER: MD-216-3110-EG-CV-GAD-1008 — REV: D01