


DRAWING NUMBER MD-216-3110-EG-CV-GAD-1009
REV D01

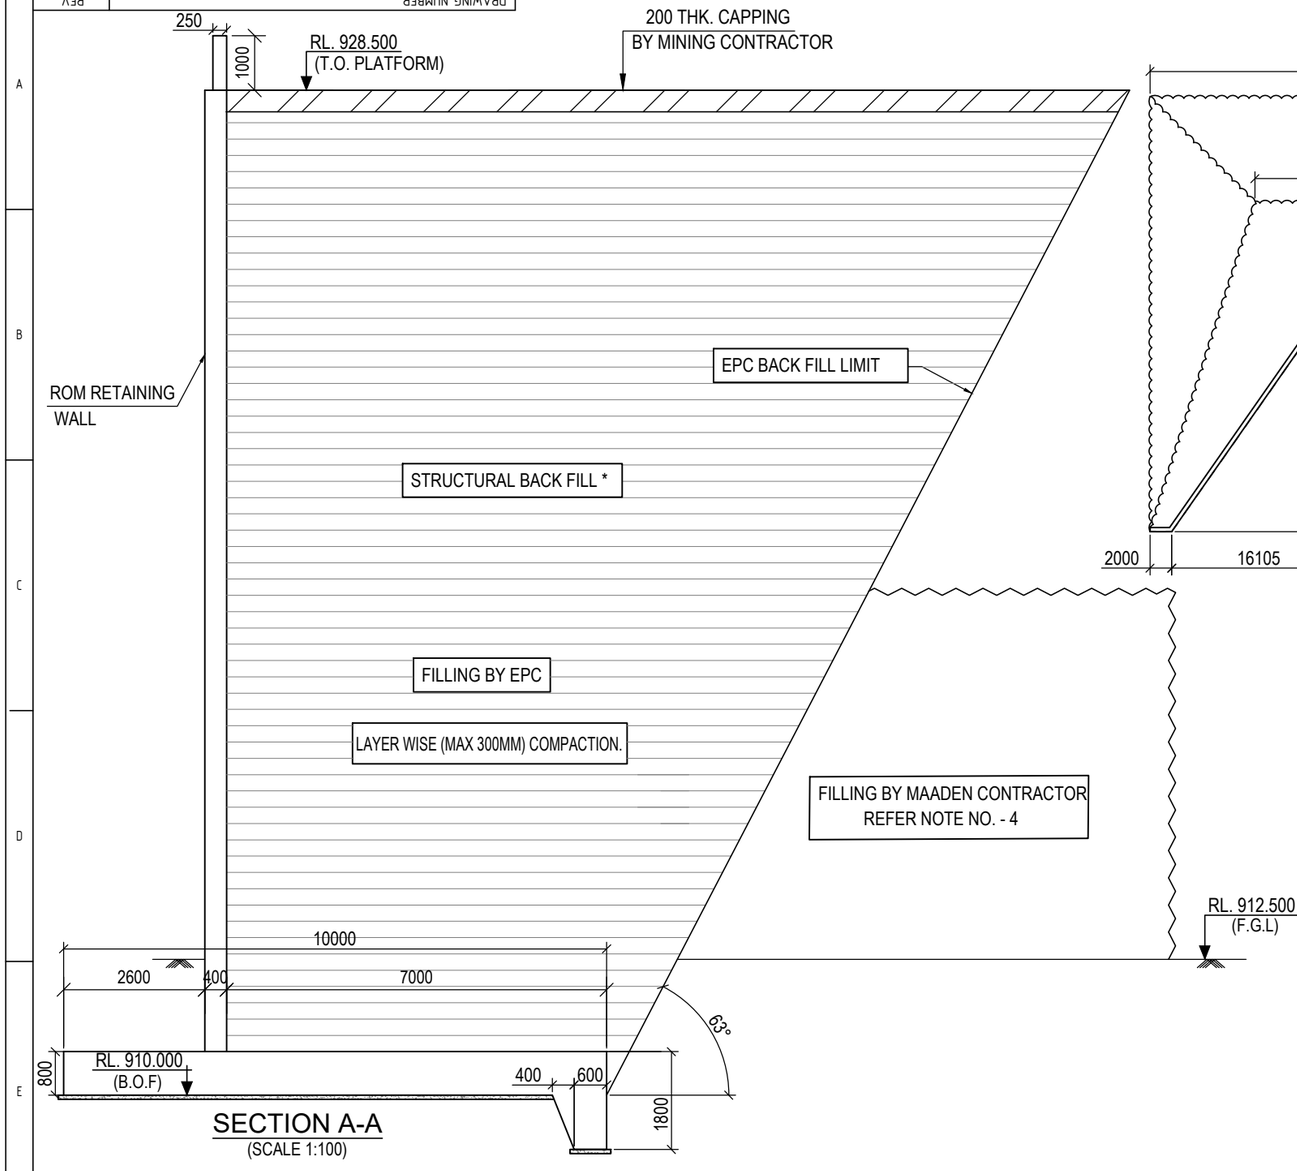

SECTION A-A
(SCALE 1:100)

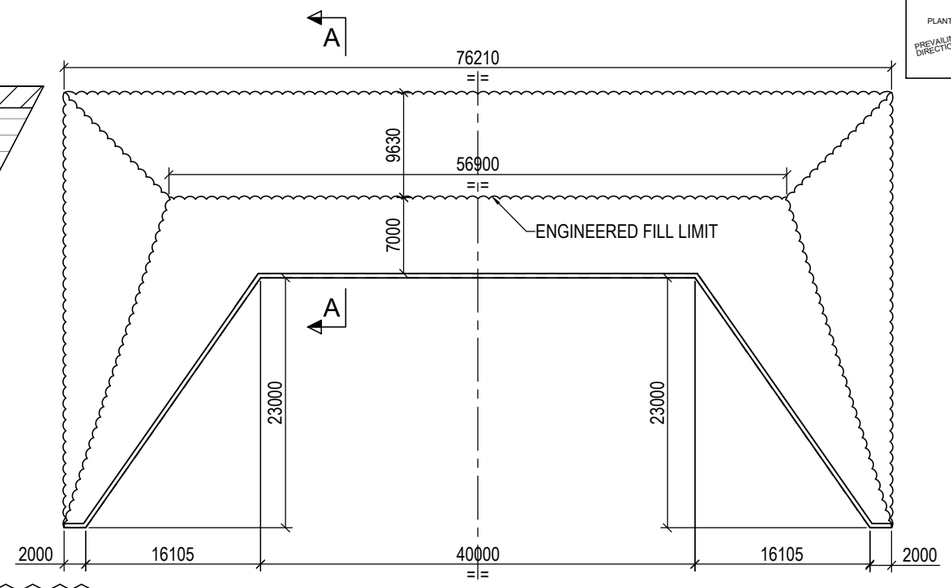

PLAN OF RETAINING WALL
(SCALE 1:500)

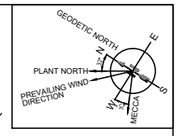

LEGEND.:-
B.O.F - BOTTOM OF FOUNDATION
F.G.L - FINISHED GROUND LEVEL

NOTES:-
1. ALL DIMENSIONS ARE IN MILLIMETRES AND LEVELS ARE IN METRES UNLESS OTHERWISE STATED.
* 2. STRUCTURAL FILL SHALL BE COMPACTED TO AT LEAST 95% OF THE MAXIMUM MODIFIED PROCTOR DE NSITY, AS DETERMINED BY ASTM D1556 & 1557.
3. THIS DRAWING SHALL BE READ IN CONJUNCTION WITH THE DRAWING NO. MD-216-3110-EG-CV-GAD-1003.
4. EPC WILL INITIATE BACKFILLING AS FIRST STEP AND SUBSEQUENTLY, FILLING WORK TO BE EXECUTED AS PER SITE CO-ORDINATION BETWEEN EPC AND MAADEN ROM MINING CONTRACTOR.
   THE SEQUENTIAL HANDING OVER AND TAKING OVER OF THE FILLING FRONT WILL BE DONE AT SITE BETWEEN EPC AND MINING CONTRACTOR TEAM VIA OFFICIAL CORRESPONDENCES.

REV	DATE	REVISION DESCRIPTION	DRN	CHK	ENG	APP	EMP
D01	10.03.2023	AS-BUILT	AMJ	SJM	AVG	AG	
C01	07.03.2022	ISSUED FOR CONSTRUCTION & REVISED AS MKD C01	AMJ	SJM	AVG	AG	
A04	01/02/2022	REVISED AS PER EMPLOYER COMMENTS ON 19/08/2020					
		AND REVISED AS MARKED A04	PML	SJM	AVG	AG	
A03	24/07/2020	REVISED AS PER PMC COMMENTS	APM	BDA	SUE	AG	
A02	19/06/2020	REVISED AS PER PMC COMMENTS	APM	BDA	SUE	AG	
A01	26/05/2020	ISSUED FOR REFERENCE	APM	BDA	SUE	AG	

RESERVED FOR VENDOR LOGO AND DRAWING NUMBER

Outotec
The content of these documents are the sole property of Outotec Oyj. Any rights not expressly granted herein are reserved. Reproduction, transfer or distribution of part or all of the contents in any form without prior written permission of Outotec is prohibited.
LARSEN & TOUBRO
This drawing is the property of LARSEN & TOUBRO and must not be passed on to any person or body not authorized by us to receive it nor be copied or otherwise made use either in full or in part by such person or body without our prior permission in writing.
MA'ADEN معادن
Saudi Arabian Mining Company شركة التعدين العربية السعودية
This document and the information contained herein is Ma'aden proprietary know-how. This document or any part thereof should not be reproduced, stored in a retrieval system or transmitted by any means, electronic or otherwise, or divulged without prior written permission of Ma'aden.

LARSEN & TOUBRO DRAWING NUMBER	O19045_100_C_G_24059_007	REV 5
OUTOTEC DRAWING NUMBER	900707 _ GAU01 _ ZC01 _ MTL01 _ 31165	DOCUMENT ID OU100686011 REV 5

DRAWN	APM	23/05/2020
CHECKED	BDA	25/05/2020
ENGINEER	SUE	23/05/2020
APPROVED	AG	26/05/2020
EMPLOYER		
SCALE	NTS	A3

MANSOURAH - MASSARAH GOLD PROJECT
GENERAL ARRANGEMENT DRAWING
PRIMARY CRUSHING
STRUCTURAL FILL BEHIND ROM RETAINING WALL

DRAWING NUMBER MD-216-3110-EG-CV-GAD-1009 REV D01