


DRAWING NUMBER MD-216-3110-EG-CV-GAD-1012 REV D01

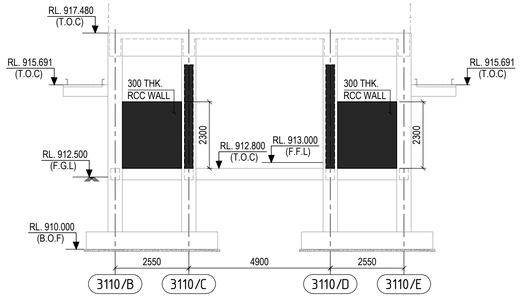


ELEVATION AT GRID - 3110/2
(REF. DWG. NO. MD - 216 - 3110 - EG - CV - GAD - 1005)
(SCALE 1:100)

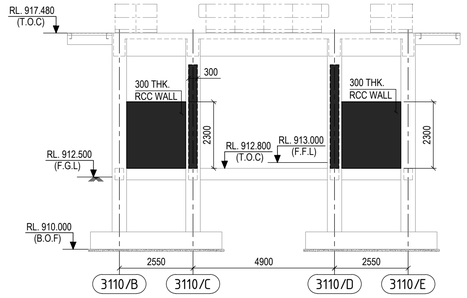


ELEVATION AT GRID - 3110/3
(REF. DWG. NO. MD - 216 - 3110 - EG - CV - GAD - 1005)
(SCALE 1:100)

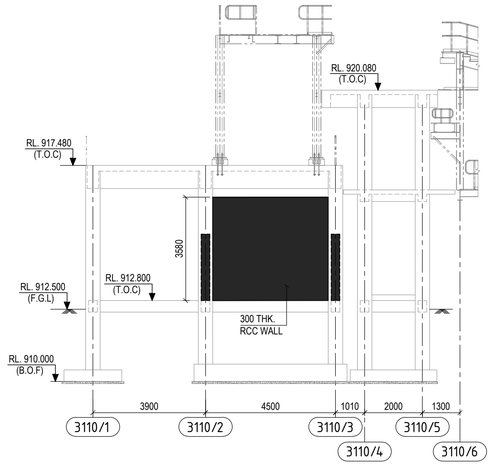

ELEVATION AT GRID - 3110/D
(REF. DWG. NO. MD - 216 - 3110 - EG - CV - GAD - 1005)
(SCALE 1:100)

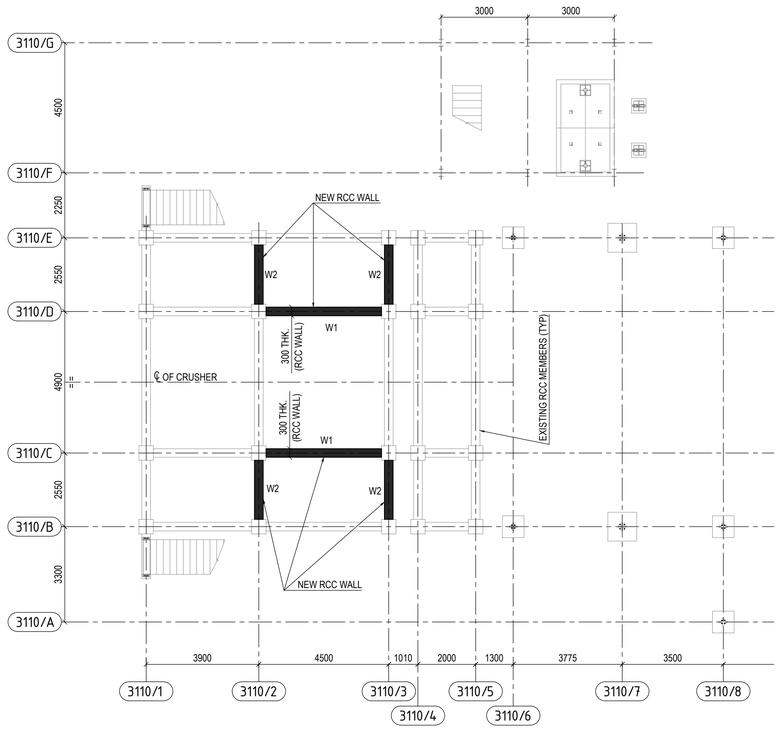

TIE BEAM AND NEW RCC WALL LAYOUT AT RL. 912.800 (T.O.C)
(REF. DWG. NO. MD - 216 - 3110 - EG - CV - GAD - 1004)
(SCALE 1:100)

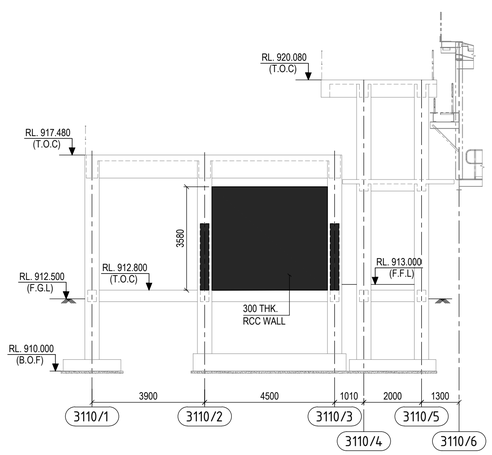

ELEVATION AT GRID - 3110/C
(REF. DWG. NO. MD - 216 - 3110 - EG - CV - GAD - 1005)
(SCALE 1:100)

LEGEND :-

RL. - REDUCED LEVEL
F.G.L - FINISHED GROUND LEVEL
F.F.L - FINISHED FLOOR LEVEL
P.C.C - PLAIN CEMENT CONCRETE
T.O.C - TOP OF CONCRETE
B.O.F - BOTTOM OF FOUNDATION
℄ - CENTRE LINE
THK. - THICK
TYP. - TYPICAL
MKD. - MARKED

NOTES:-

1. ALL DIMENSIONS ARE IN MILLIMETRES AND LEVELS ARE IN METRES UNLESS OTHERWISE STATED.
2. GRADE OF CONCRETE SHALL BE C35 .
3. GRADE OF REINFORCEMENT SHALL BE DEFORMED BAR 420 MPa (GRADE 60)
4. READ THIS DRAWING IN CONJUNCTION WITH DRAWING NO. MD-216-3110-EG-CV-DED-1007.

DOCUMENT NUMBER	REFERENCE DOCUMENTS	REV	DATE	REVISION DESCRIPTION	DRN	CHK	ENG	APP	EMP
MD-216-3110-EG-ME-ELV-1009	PRIMARY CRUSHER HOUSE-SECTION	D01	10/03/2023	AS-BUILT	SBH	BDA	STY	AG	
MD-216-3110-EG-ME-ELV-1008	PRIMARY CRUSHER HOUSE-SECTION	C01	26/10/2022	ISSUED FOR CONSTRUCTION	SBH	BDA	STY	AG	
MD-216-3110-EG-ME-ELV-1007	PRIMARY CRUSHER HOUSE-ELEVATION	A02	16/09/2022	REVISED AS PER EMPLOYER'S COMMENTS	SBH	BDA	STY	AG	
MD-216-3110-EG-ME-LPX-1002	PRIMARY CRUSHER HOUSE-PLAN VIEW			ON 05/09/2022 AND REVISED AS MARKED A02					
MD-216-3110-EG-ME-LPX-1001	PRIMARY CRUSHER HOUSE-PLAN VIEW	A01	28/07/2022	ISSUED OF APPROVAL	SBH	BDA	STY	AG	

RESERVED FOR VENDOR LOGO AND DRAWING NUMBER

LARSEN & TOUBRO

This drawing is the property of LARSEN & TOUBRO and must not be passed on to any person or body not authorized by us to receive it nor be copied or otherwise made use either in full or in part by such person or body without our prior permission in writing.

Outotec

The content of these documents are the sole property of Outotec Oyj. Any rights not expressly granted herein are reserved. Reproduction, transfer or distribution of part or all of the contents in any form without prior written permission of Outotec is prohibited.

MA'ADEN معادن
Saudi Arabian Mining Company شركة معادن العربية السعودية

This document and the information contained herein is Ma'aden proprietary know-how. This document or any part thereof should not be reproduced, stored in a retrieval system or transmitted by any means, electronic or otherwise, or divulged without prior written permission of Ma'aden.

DRAWN	SBH	25/07/2022	MANSOURAH - MASSARAH GOLD PROJECT
CHECKED	BDA	26/07/2022	GENERAL ARRANGEMENT DRAWING
ENGINEER	STY	27/07/2022	PRIMARY CRUSHING
APPROVED	AG	28/07/2022	MODIFICATION OF CRUSHER SUPPORTING STRUCTURE
EMPLOYER			
SCALE	1:100, 1:50	A1	

LARSEN & TOUBRO DRAWING NUMBER: 019045_100_C_G_24059_008 — REVISION: 3
OUTOTEC DRAWING NUMBER: 900707 _GAU01 _ZC01 _MTL01 _31395 — DOCUMENT ID: OU100760089 — REVISION: 3
DRAWING NUMBER: MD - 216 - 3110 - EG - CV - GAD - 1012 — REV: D01