


DRAWING NUMBER: MD-216-3120-EG-CV-GAD-1001 REV D01

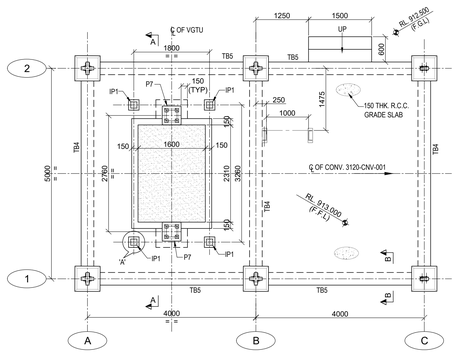

PLAN OF GRADE SLAB AT RL. 913.000
AND TIE BEAM AT RL. 912.850 (T.O.B)
(FOR VGTU TOWER)
(SCALE-1:50)

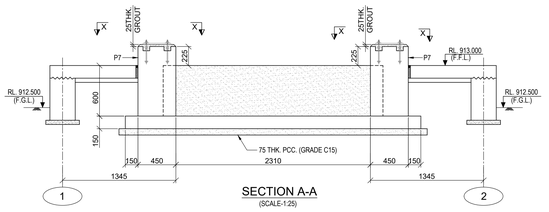


SECTION A-A
(SCALE-1:25)

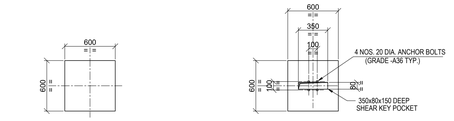

DETAIL OF PEDESTAL MKD. P1
(SCALE-1:25)


DETAIL OF PEDESTAL MKD. P2 & P3
(SCALE-1:25)

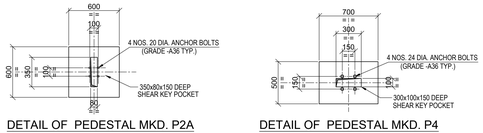


DETAIL OF PEDESTAL MKD. P2A
(SCALE-1:25)




DETAIL OF PEDESTAL MKD. P4
(SCALE-1:25)

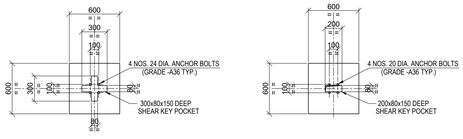


DETAIL OF PEDESTAL MKD. P5
(SCALE-1:25)

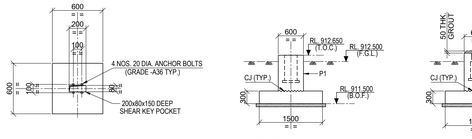

DETAIL OF PEDESTAL MKD. P6
(SCALE-1:25)

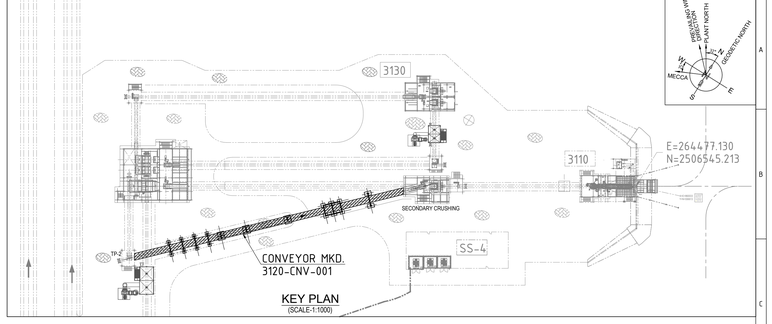


KEY PLAN
(SCALE-1:1000)

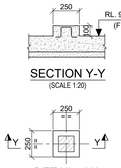


SECTION Y-Y
(SCALE 1:20)


DETAIL - 'A'
(SCALE 1:20)

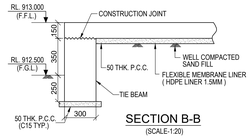


SECTION B-B
(SCALE-1:20)

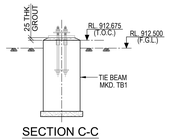


SECTION C-C
(SCALE-1:20)

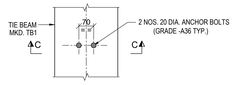


DETAIL - 'B'
(SCALE 1:10)

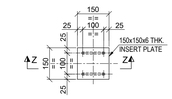

DETAIL OF INSERT PLATE - IP1
(SCALE 1:10)

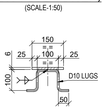


SECTION Z-Z
(SCALE 1:10)

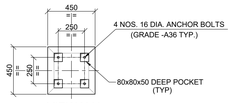

VIEW X-X
DETAIL OF PEDESTAL MKD. P7
(SCALE 1:20)


SCHEDULE OF BEAM


BEAM MKD.	SIZE		LEVEL
	WIDTH (mm.)	DEPTH (mm.)	
TB1	350	600	RL. 912.675 (T.O.B.)
TB2	300	500	RL. 912.500 (T.O.B.)
TB3	300	500	RL. 912.500 (T.O.B.)
TB4	300	500	RL. 912.850 (T.O.B.)
TB5	300	600	RL. 912.850 (T.O.B.)
TB6	300	600	RL. 912.500 (T.O.B.)

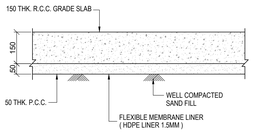

TYP. DETAIL OF 150 THK. GRADE SLAB
SCALE 1:10

LAYOUT OF FOUNDATION AND TIE BEAM
(SCALE-1:100)

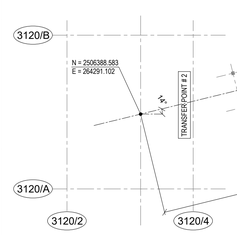


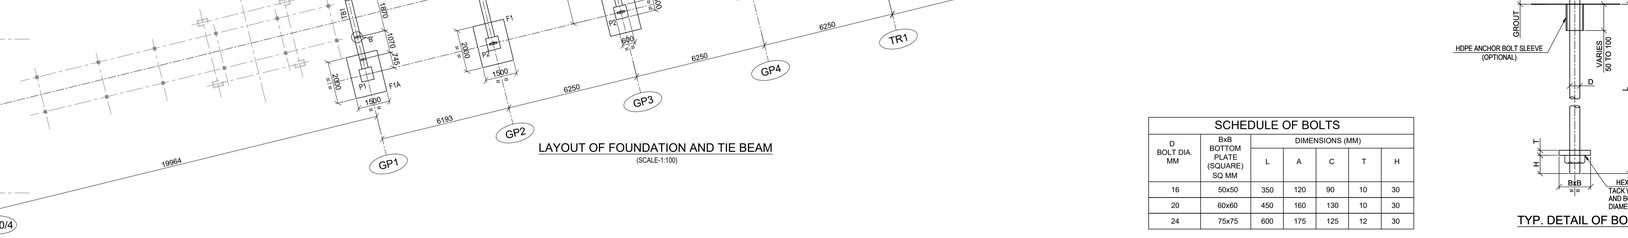

LAYOUT OF FOUNDATION AND TIE BEAM
(SCALE-1:100)


SCHEDULE OF BOLTS

D BOLT DIA. MM	BxB BOTTOM PLATE (SQUARE) SQ MM	DIMENSIONS (MM)				
		L	A	C	T	H
16	50x50	350	120	90	10	30
20	60x60	450	160	130	10	30
24	75x75	600	175	125	12	30

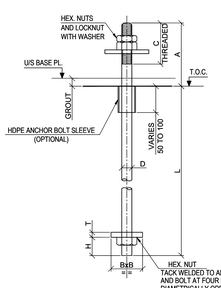


TYP. DETAIL OF BOLT


SECTION 1A-1A
(SCALE-1:50)

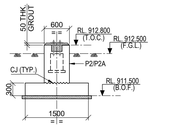


SECTION 1-1
(SCALE-1:50)

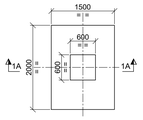


DETAIL OF FOUNDATION MKD. F1A
(SCALE-1:50)

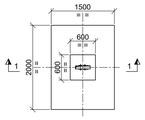


DETAIL OF FOUNDATION MKD. F1
(SCALE-1:50)

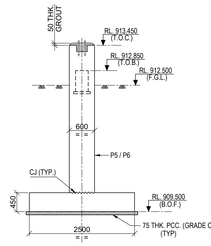


SECTION 3-3
(SCALE-1:50)

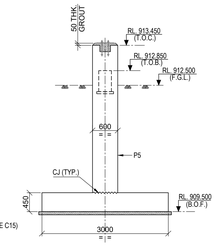


SECTION 4-4
(SCALE-1:50)

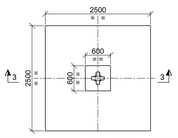


DETAIL OF FOUNDATION MKD. F3
(SCALE-1:50)

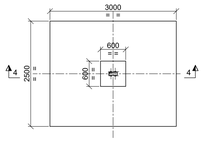


DETAIL OF FOUNDATION MKD. F4
(SCALE-1:50)

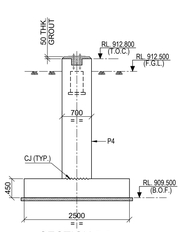


SECTION 5-5
(SCALE-1:50)

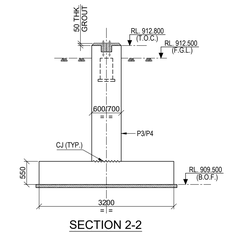

SECTION 2-2
(SCALE-1:50)

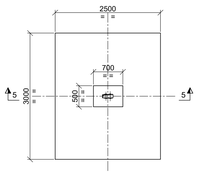

DETAIL OF FOUNDATION MKD. F5
(SCALE-1:50)

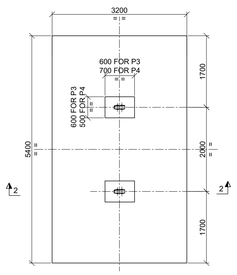

DETAIL OF FOUNDATION MKD. F2
(SCALE-1:50)

NOTES :-

1. ALL DIMENSIONS ARE IN MILLIMETRES AND LEVELS AND CO-ORDINATES ARE IN METRES. UNLESS OTHERWISE STATED.
2. GRADE OF CONCRETE SHALL BE C35 FOR FOUNDATION.
3. GRADE OF REINFORCEMENT SHALL BE DEFORMED BAR ASTM A615 - GRADE 60 (fy = 420 MPa).
4. NET SAFE BEARING CAPACITY OF SOIL AT BOTTOM OF FOUNDATION CONSIDERED 500KN/ SQ. M.
5. CLEAR COVER TO MAIN REINFORCEMENT SHALL BE AS
   a) FOUNDATION = 75 mm (BOTTOM & SIDE) 50 mm. (TOP)
   b) COLUMN & PEDESTAL = 50mm
   c) BEAM = 50mm
   d) SLAB = 40mm
6. FOR MINIMUM LAP LENGTH OF REINFORCEMENT AND OTHER GENERAL NOTES FOR CIVIL WORKS REFER STANDARD DRG : MD-216-1000-EG-CV-DED-1001
7. THIS DRAWING IS TO BE READ IN CONJUNCTION WITH DRAWING MD - 216 - 3120 -EG -ST - GAD - 1001 TO MD - 216 - 3120 -EG -ST - GAD - 1005
8. ALL STRUCTURAL WORK SHALL CONFORM TO CIVIL STRUCTURAL DESIGN CRITERIA NO. MD - 216 - 1000 -EG -ST - CRT - 1001
9. FOR OTHER STANDARD REINFORCEMENT DETAILS REFER DRG : MD-216-1000-EG-CV-DED-1005

LEGEND :-
R.L - REDUCED LEVEL
℄ - CENTRE LINE
CJ - CONSTRUCTION JOINT
FDN. - FOUNDATION.
T.O.C. - TOP OF CONCRETE.
F.G.L. - FINISHED GROUND LEVEL.
F.F.L. - FINISHED FLOOR LEVEL.
B.O.F. - BOTTOM OF FOUNDATION
TYP. - TYPICAL.
B.O.B. - BOTTOM OF BEAM.
B.O.M. - BOTTOM OF MONORAIL.
R.C.C - REINFORCED CEMENT CONCRETE
P.C.C - PLAIN CEMENT CONCRETE
IP - INSERT PLATE
MKD. - MARKED.
THK. - THICK

DOCUMENT NUMBER	REFERENCE DOCUMENTS	REV	DATE	REVISION DESCRIPTION	DRN	CHK	ENG	APP	EMP
		D01	10/03/2023	AS-BUILT	AMJ	SBY	APL	PRI	
MD-216-3120-EG-ME-ELV-1003	SECONDARY CRUSHING CONV. 3120-CNV-001-ELEVATION	C02	06/01/2021	ISSUED FOR CONSTRUCTION & REVISED AS MKD. △02	AMJ	SBY	APL	PRI	
MD-216-3120-EG-ME-ELV-1002	SECONDARY CRUSHING CONV. 3120-CNV-001-ELEVATION	C01	30/04/2020	ISSUED FOR CONSTRUCTION, REVISED AS PER EMPLOYER	AMJ	SBY	APL	PRI	
MD-216-3120-EG-ME-ELV-1001	SECONDARY CRUSHING CONV. 3120-CNV-001-ELEVATION			COMMENTS DATED 24/04/2020 & INTERNALLY REVISED AS MKD. △01					
MD-216-3120-EG-ME-LPX-1001	SECONDARY CRUSHING CONV. 3120-CNV-001-PLAN VIEW	A01	18/03/2020	ISSUED FOR REFERENCE	AMJ	SBY	APL	PRI	

RESERVED FOR VENDOR LOGO AND DRAWING NUMBER

LARSEN & TOUBRO

This drawing is the property of LARSEN & TOUBRO and must not be passed on to any person or body not authorized by us to receive it nor be copied or otherwise made use either in full or in part by such person or body without our prior permission in writing.

Outotec

The content of these documents are the sole property of Outotec Oyj. Any rights not expressly granted herein are reserved. Reproduction, transfer or distribution of part or all of the contents in any form without prior written permission of Outotec is prohibited.

MA'ADEN معادن
Saudi Arabian Mining Company شركة المعادن العربية السعودية

This document and the information contained herein is Ma'aden proprietary know-how. This document or any part thereof should not be reproduced, stored in a retrieval system or transmitted by any means, electronic or otherwise, or divulged without prior written permission of Ma'aden.

LARSEN & TOUBRO DRAWING NUMBER			REVISION
019045_100_C_G_24056_003			3
OUTOTEC DRAWING NUMBER		DOCUMENT ID	REVISION
900707__GAU01__ZC01__MTL01__31246		OU100670363	3
DRAWN	AMJ	13/03/2020	MANSOURAH - MASSARAH GOLD PROJECT
CHECKED	SBY	17/03/2020	GENERAL ARRANGEMENT DRAWING
ENGINEER	APL	16/03/2020	GA OF CONVEYOR 3120-CNV-001
APPROVED	PRI	18/03/2020	LAYOUT & DETAIL
EMPLOYER			
SCALE	1:100,50,20,10	A0	DRAWING NUMBER: MD - 216 - 3120 - EG - CV - GAD - 1001 REV: D01