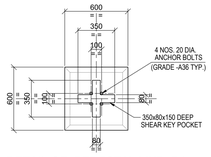
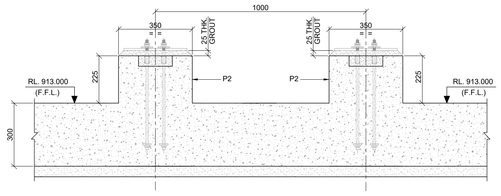
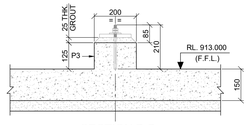
DRAWING NUMBER: MD-216-3120-EG-CV-GAD-1002 | REV: D01



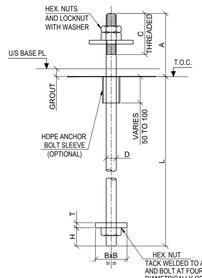

DETAIL OF PEDESTAL MKD. P1
(SCALE-1:20)



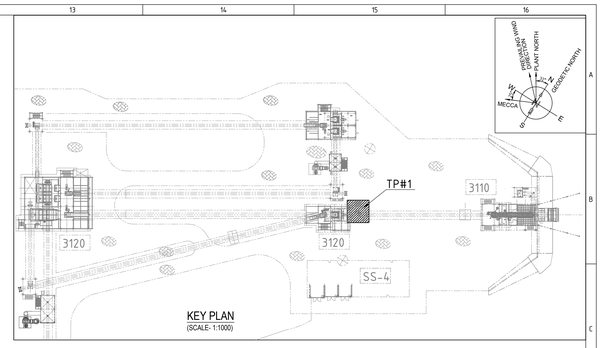

SECTION A-A
(SCALE 1:10)



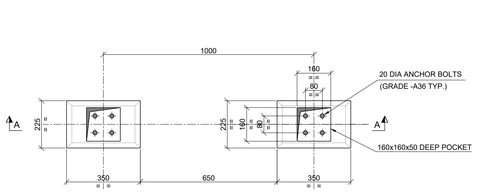

SECTION B-B
(SCALE 1:10)



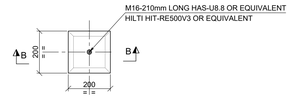

TYP. DETAIL OF BOLT




| SCHEDULE OF BEAM | | | |
|---|---|---|---|
| BEAM MKD. | SIZE | | LEVEL |
| | WIDTH (mm.) | DEPTH (mm.) | |
| TB1 | 300 | 500 | RL. 912.850 (T.O.B.) |
| GB1 | 300 | 450 | RL. 912.850 (T.O.B.)<br>RL. 912.700 (T.O.B.) |

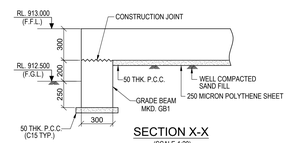



DETAIL OF PEDESTAL MKD. P2
(SCALE 1:10)

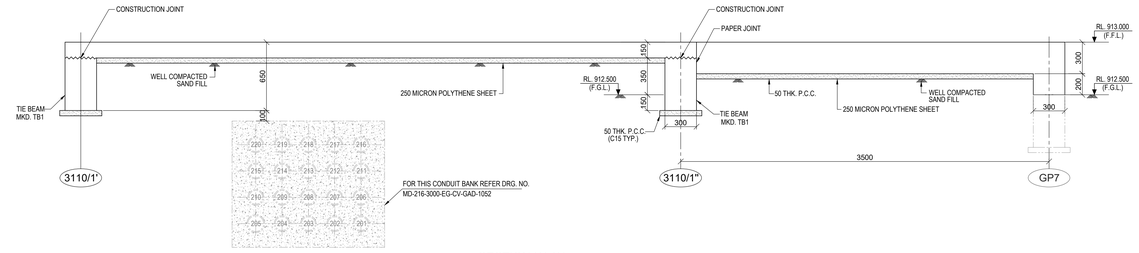



DETAIL OF PEDESTAL MKD. P3
(SCALE 1:10)

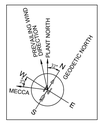
| SCHEDULE OF BOLTS | | | | | | |
|---|---|---|---|---|---|---|
| D BOLT DIA. MM | BxB BOTTOM PLATE (SQUARE) SQ MM | DIMENSIONS (MM) | | | | |
| | | L | A | C | T | H |
| 20 | 60x60 | 450 | 160 | 130 | 10 | 30 |

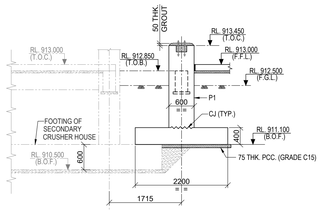



SECTION X-X
(SCALE-1:20)

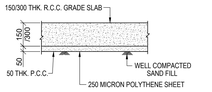



SECTION X1-X1
(SCALE-1:20)

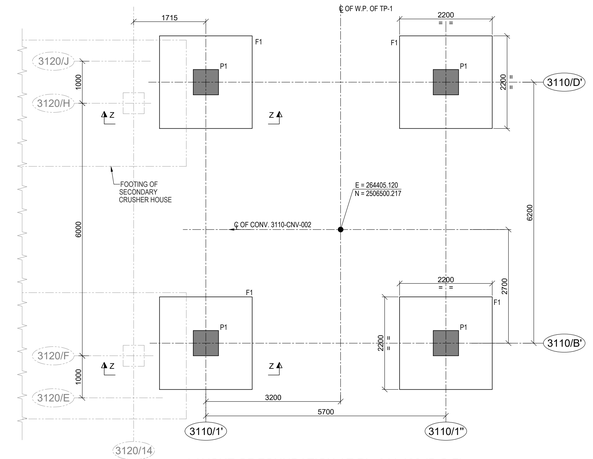


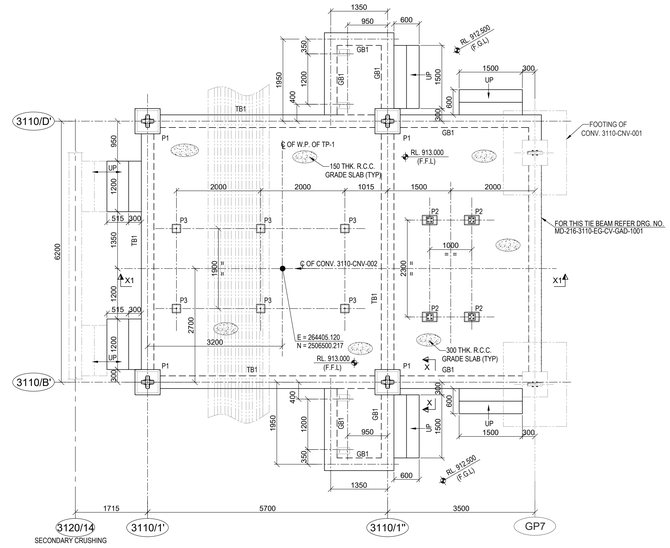

SECTION Z-Z
(SCALE-1:50)



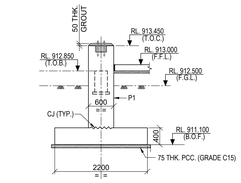

TYP. DETAIL OF GRADE SLAB
SCALE 1:20



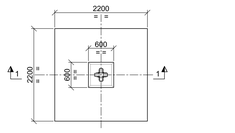

LAYOUT OF FOUNDATION AT RL. 911.100 (B.O.F)
(SCALE-1:50)




PLAN OF GRADE SLAB AT RL. (+) 913.000 (F.F.L)
AND GRADE BEAM & TIE BEAM AT RL. 912.850 (T.O.B)
(SCALE-1:50)




SECTION 1-1
(SCALE-1:50)




DETAIL OF FOUNDATION MKD. F1
(SCALE-1:50)

## LEGENDS :-

R.L - REDUCED LEVEL
℄ - CENTRE LINE
CJ - CONSTRUCTION JOINT
FDN. - FOUNDATION.
T.O.C. - TOP OF CONCRETE.
F.G.L. - FINISHED GROUND LEVEL.
F.F.L. - FINISHED FLOOR LEVEL.
B.O.F. - BOTTOM OF FOUNDATION
TYP. - TYPICAL.
B.O.B. - BOTTOM OF BEAM.
B.O.M. - BOTTOM OF MONORAIL.
R.C.C. - REINFORCED CEMENT CONCRETE
P.C.C - PLAIN CEMENT CONCRETE
IP. - INSERT PLATE
MKD. - MARKED.
THK. - THICK
HDPVC HIGH-DENSITY POLYVINYL CHLORIDE

## NOTES :-

1. ALL DIMENSIONS ARE IN MILLIMETRES AND LEVELS AND CO-ORDINATES ARE IN METRES. UNLESS OTHERWISE STATED.
2. GRADE OF CONCRETE SHALL BE C35 FOR FOUNDATION.
3. GRADE OF REINFORCEMENT SHALL BE DEFORMED BAR ASTM A615 - GRADE 60 (fy = 420 MPa).
4. NET SAFE BEARING CAPACITY OF SOIL AT BOTTOM OF FOUNDATION CONSIDERED 500KN/ SQ. M.
5. CLEAR COVER TO MAIN REINFORCEMENT SHALL BE AS
   a) FOUNDATION = 75 mm (BOTTOM & SIDE) 50 mm. (TOP)
   b) COLUMN & PEDESTAL = 50mm
   c) BEAM = 50mm
   d) SLAB = 40mm
6. FOR MINIMUM LAP LENGTH OF REINFORCEMENT REFER STANDARD DRG : MD-216-1000-EG-CV-DED-1001
7. THIS DRAWING IS TO BE READ IN CONJUNCTION WITH DRAWING MD - 216 - 3120 -EG -ST - GAD - 1018 & MD - 216 - 3120 -EG -ST - GAD - 1019
8. ALL STRUCTURAL WORK SHALL CONFORM TO CIVIL STRUCTURAL DESIGN CRITERIA NO. MD - 216 - 1000-EG -ST - CRT - 1001
9. FOR OTHER STANDARD REINFORCEMENT DETAILS REFER DRG : MD-216-1000-EG-CV-DED-1005

| DOCUMENT NUMBER | REFERENCE DOCUMENTS | REV | DATE | REVISION DESCRIPTION | DRN | CHK | ENG | APP | EMP |
|---|---|---|---|---|---|---|---|---|---|
| | | D01 | 10/03/2023 | AS-BUILT | JKM | SBY | RPK | PRI | |
| | | C03 | 27/01/2021 | ISSUED FOR CONSTRUCTION & REVISED AS MKD. (02) | JKM | SBY | RPK | PRI | |
| | | C02 | 17/12/2020 | ISSUED FOR CONSTRUCTION & REVISED AS MKD. (02) | AMJ | SBY | RPK | PRI | |
| MD-216-3000-EG-CV-GAD-1052 | CRUSHER AREA PULL PIT LAYOUT- LAYOUT & DETAIL | C01 | 11/05/2020 | ISSUED FOR CONSTRUCTION, REVISED AS PER EMPLOYER | AMJ | SBY | RPK | PRI | |
| MD-216-3110-EG-ME-ELEV-1011 | PRIMARY CRUSHING TRANSFER POINT TP#1 - ELEVATION | | | COMMENTS DATED 06/05/2020 & REVISED AS MKD. (01) | | | | | |
| MD-216-3110-EG-ME-LPX-1006 | PRIMARY CRUSHING TRANSFER POINT TP#1 - PLAN VIEW | A01 | 10/04/2020 | ISSUED FOR REFERENCE | AMJ | SBY | RPK | PRI | |

| DOCUMENT NUMBER | REFERENCE DOCUMENTS | REV | DATE | REVISION DESCRIPTION | DRN | CHK | ENG | APP | EMP |
|---|---|---|---|---|---|---|---|---|---|

RESERVED FOR VENDOR LOGO AND DRAWING NUMBER

LARSEN & TOUBRO

This drawing is the property of LARSEN & TOUBRO and must not be passed on to any person or body not authorized by us to receive it nor be copied or otherwise made use either in full or in part by such person or body without our prior permission in writing.

Outotec

The content of these documents are the sole property of Outotec Oyj. Any rights not expressly granted herein are reserved. Reproduction, transfer or distribution of part or all of the contents in any form without prior written permission of Outotec is prohibited.

MA'ADEN معادن
Saudi Arabian Mining Company شركة معادن العربية السعودية

This document and the information contained herein is Ma'aden proprietary know-how. This document or any part thereof should not be reproduced, stored in a retrieval system or transmitted by any means, electronic or otherwise, or divulged without prior written permission of Ma'aden.

| | | |
|---|---|---|
| LARSEN & TOUBRO DRAWING NUMBER | | REVISION |
| 019045_100_C_G_Z4107_001 | | 4 |
| OUTOTEC DRAWING NUMBER | DOCUMENT ID | REVISION |
| 900707__GAU01__ZC01__MTL01__31201 | 0U100668043 | 4 |
| DRAWN: AMJ 08/04/2020 | | |
| CHECKED: SBY 09/04/2020 | | |
| ENGINEER: RPK 07/04/2020 | | |
| APPROVED: PRI 10/04/2020 | | |
| EMPLOYER: | | |
| SCALE: 1:100,50,25,20,10 | A0 | |

MANSOURAH - MASSARAH GOLD PROJECT
GENERAL ARRANGEMENT DRAWING
GA OF TP - 1 (3120 CNV-001)
LAYOUT & DETAIL

| DRAWING NUMBER | REV |
|---|---|
| MD - 216 - 3120 - EG - CV - GAD - 1002 | D01 |