
DRAWING NUMBER: MD-216-3120-EG-CV-GAD-1003 REV D01

SCHEDULE OF BEAM


BEAM MKD.	SIZE WIDTH (mm.)	SIZE DEPTH (mm.)	LEVEL
GB1	300	450	RL. 912.700 (T.O.B.)

SCHEDULE OF BOLTS


D BOLT DIA. MM	BxB BOTTOM PLATE (SQUARE) SQ MM	DIMENSIONS (MM) L	A	C	T	H
20	60x60	450	160	130	10	30
24	75x75	600	175	125	12	30

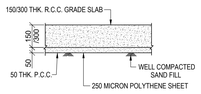


TYP. DETAIL OF GRADE SLAB
SCALE 1:20

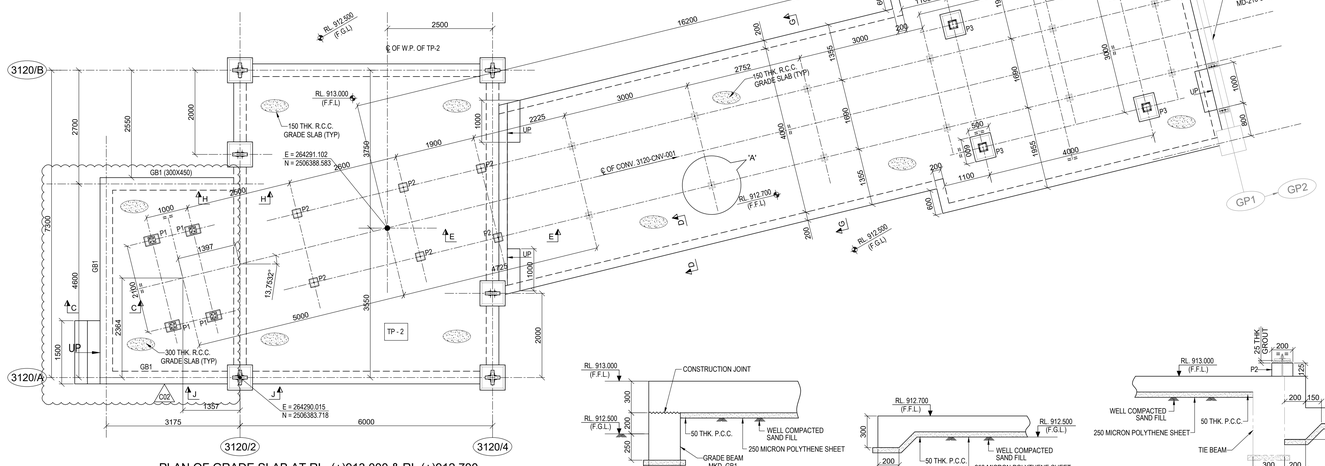


PLAN OF GRADE SLAB AT RL. (+)913.000 & RL.(+)912.700
(FOR TIE BEAM REFER DRG. NO. MD-216-3120-EG-CV-GAD-2021)
(SCALE-1:50)

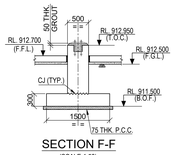


SECTION F-F
(SCALE-1:50)

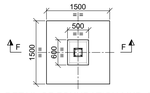


DETAIL OF FOUNDATION MKD. F1
(SCALE-1:50)

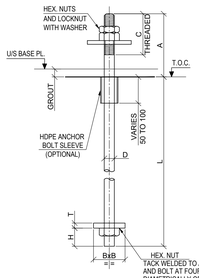


TYP. DETAIL OF BOLT

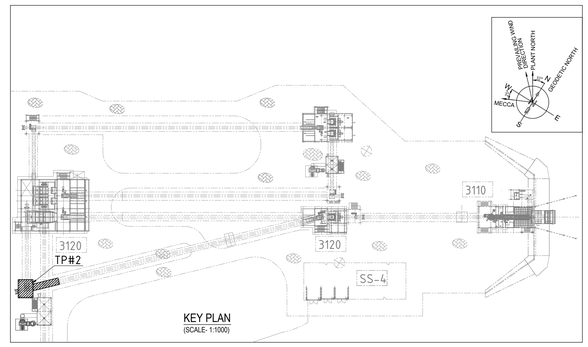


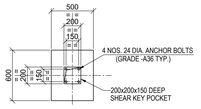


DETAIL OF PEDESTAL MKD. P3
(SCALE-1:25)

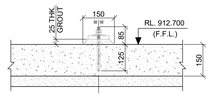


SECTION A1-A1
(SCALE 1:10)

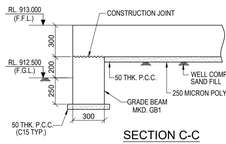


SECTION C-C
(SCALE-1:20)

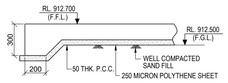


SECTION D-D
(SCALE-1:20)

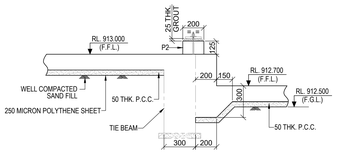


SECTION E-E
(SCALE-1:20)

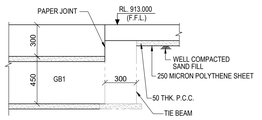


SECTION H-H
(SCALE-1:20)

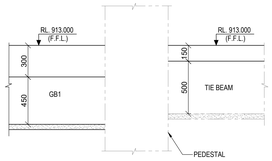

SECTION J-J
(SCALE-1:20)

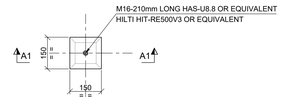


DETAIL 'A'
(SCALE 1:10)

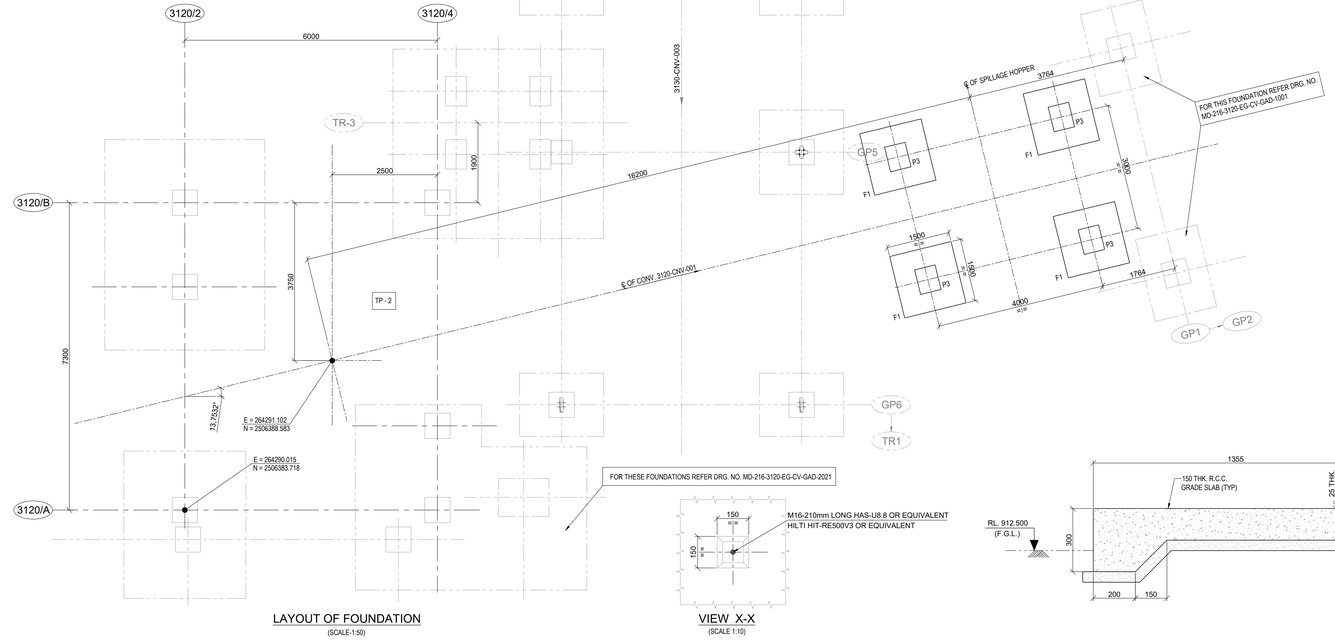


LAYOUT OF FOUNDATION
(SCALE-1:50)


VIEW X-X
(SCALE 1:10)

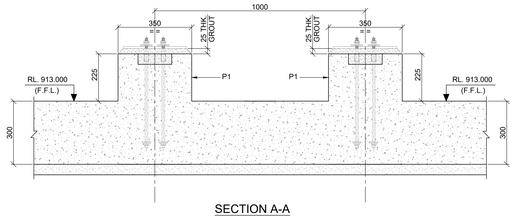


SECTION A-A
(SCALE 1:10)

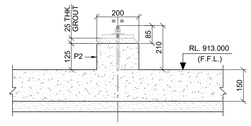


SECTION B-B
(SCALE 1:10)

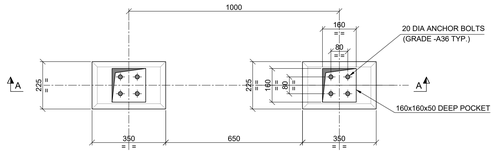

DETAIL OF PEDESTAL MKD. P1
(SCALE 1:10)

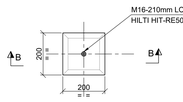

DETAIL OF PEDESTAL MKD. P2
(SCALE 1:10)

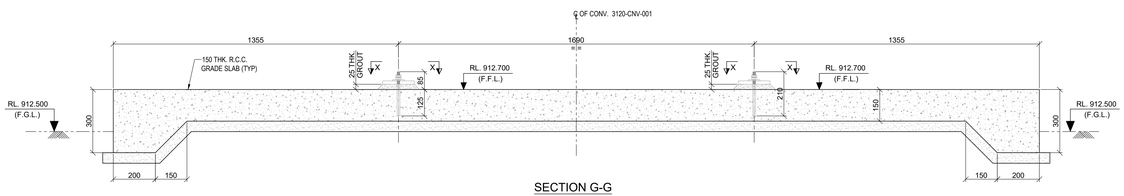

SECTION G-G
(SCALE 1:10)

LEGENDS :-

R.L - REDUCED LEVEL
℄ - CENTRE LINE
CJ - CONSTRUCTION JOINT
FDN. - FOUNDATION.
T.O.C. - TOP OF CONCRETE.
F.G.L. - FINISHED GROUND LEVEL.
F.F.L. - FINISHED FLOOR LEVEL.
B.O.F. - BOTTOM OF FOUNDATION
TYP. - TYPICAL
R.C.C - REINFORCED CEMENT CONCRETE
P.C.C - PLAIN CEMENT CONCRETE
MKD. - MARKED.
THK. - THICK
NTS. - NOT TO SCALE

NOTES :-

1. ALL DIMENSIONS ARE IN MILLIMETRES AND LEVELS AND CO-ORDINATES ARE IN METRES, UNLESS OTHERWISE STATED.
2. GRADE OF CONCRETE SHALL BE C35 FOR FOUNDATION.
3. GRADE OF REINFORCEMENT SHALL BE DEFORMED BAR ASTM A615 - GRADE 60 (fy = 420 MPa).
4. NET SAFE BEARING CAPACITY OF SOIL AT BOTTOM OF FOUNDATION CONSIDERED 500KN/ SQ. M.
5. CLEAR COVER TO MAIN REINFORCEMENT SHALL BE AS
   a) FOUNDATION = 75 mm (BOTTOM & SIDE) 50 mm. (TOP)
   b) COLUMN & PEDESTAL = 50mm
   c) BEAM = 50mm
   d) SLAB = 40mm
6. FOR MINIMUM LAP LENGTH OF REINFORCEMENT AND OTHER GENERAL NOTES FOR CIVIL WORKS REFER STANDARD DRG : MD-216-1000-EG-CV-DED-1001
7. THIS DRG. SHALL BE READ IN CONJUNCTION WITH DRG. NO. MD-216-3120-EG-CV-DED-1003
8. ALL STRUCTURAL WORK SHALL CONFORM TO CIVIL STRUCTURAL DESIGN CRITERIA NO. MD - 216 - 1000 -EG -ST - CRT - 1001
9. FOR OTHER STANDARD REINFORCEMENT DETAILS REFER DRG : MD-216-1000-EG-CV-DED-1005

DOCUMENT NUMBER	REFERENCE DOCUMENTS	REV	DATE	REVISION DESCRIPTION	DRN	CHK	ENG	APP	EMP
MD-216-3120-EG-ME-GAD-1020	SECONDARY CRUSHING SPILLAGE HOPPER								
	PLAN & SECTIONS OF HOPPER								
MD-216-3120-EG-CV-GAD-1001	GA OF CONVEYOR 3120-CNV-001 LAYOUT & DETAIL								
MD-216-3120-EG-ST-GAD-2021	CRUSHING-LAYOUT OF BAG FILTER & DUCT								
	SUPPORT FOUNDATION SHT.1	D01	10/03/2023	AS-BUILT	JKM	SBY	APL	PRI	
MD-216-3120-EG-ST-GAD-1020	STRUCTURAL GA OF TP-2(3120 CNV-001)-1	C02	28/01/2021	ISSUED FOR CONSTRUCTION & REVISED AS MKD. (2X)	JKM	SBY	APL	PRI	
	PLAN, ELEVATIONS & DETAILS	C01	12/12/2020	ISSUED FOR CONSTRUCTION & REVISED AS MKD. (2X)	JKM	SBY	APL	PRI	
MD-216-3120-EG-ME-LPX-1020	TRANSFER POINT TP#2 - PLAN VIEW	A01	12/11/2020	ISSUED FOR REVIEW	JKM	SBY	APL	PRI	

DOCUMENT NUMBER	REFERENCE DOCUMENTS	REV	DATE	REVISION DESCRIPTION	DRN	CHK	ENG	APP	EMP

RESERVED FOR VENDOR LOGO AND DRAWING NUMBER

LARSEN & TOUBRO

This drawing is the property of LARSEN & TOUBRO and must not be passed on to any person or body not authorized by us to receive it nor be copied or otherwise made use either in full or in part by such person or body without our prior permission in writing.

Outotec

The content of these documents are the sole property of Outotec Oyj. Any rights not expressly granted herein are reserved. Reproduction, transfer or distribution of part or all of the contents in any form without prior written permission of Outotec is prohibited.

MA'ADEN معادن Saudi Arabian Mining Company شركة المعادن العربية السعودية

This document and the information contained herein is Ma'aden proprietary know-how. This document or any part thereof should not be reproduced, stored in a retrieval system or transmitted by any means, electronic or otherwise, or divulged without prior written permission of Ma'aden.

LARSEN & TOUBRO DRAWING NUMBER		REVISION
O19045_100_C_G_24107_002		3
OUTOTEC DRAWING NUMBER	DOCUMENT ID	REVISION
900707__GAU01__ZC01__MTL01__31202	OU100668044	3

DRAWN	JKM	11/11/2020
CHECKED	SBY	12/11/2020
ENGINEER	APL	10/11/2020
APPROVED	PRI	12/11/2020
EMPLOYER		

MANSOURAH - MASSARAH GOLD PROJECT
GENERAL ARRANGEMENT DRAWING
GA OF TP-2 (3120-CNV-001)
LAYOUT & DETAIL

SCALE 1:50, 20, 10 | A0 | DRAWING NUMBER MD - 216 - 3120 - EG - CV - GAD - 1003 | REV D01