

DRAWING NUMBER: MD-216-3120-EG-CV-GAD-1004 | REV: D01

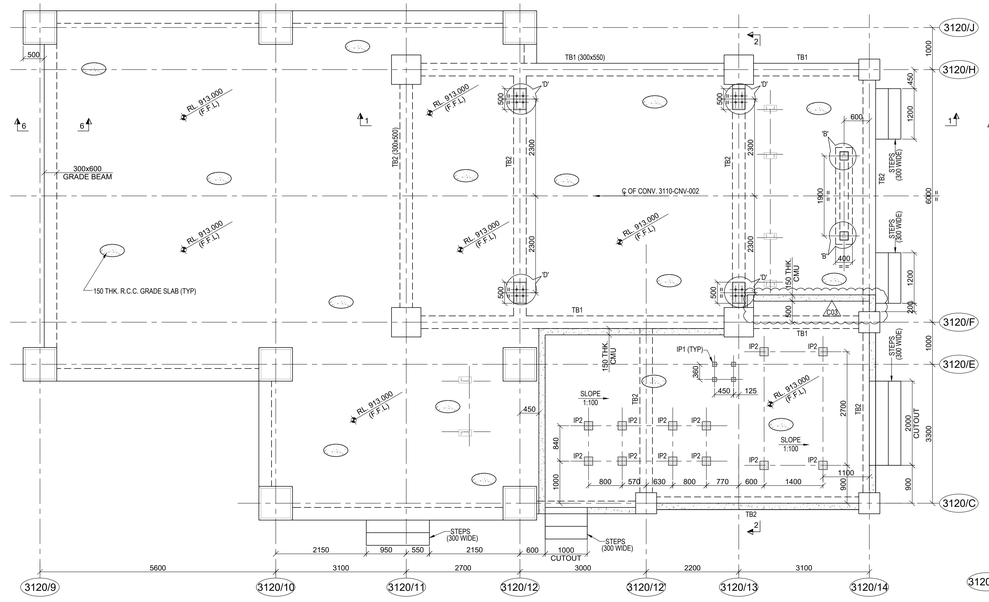


PLAN OF GRADE SLAB AT RL. 913.000 AND TIE BEAM AT RL. 912.850 (T.O.B)

(SCALE-1:50)

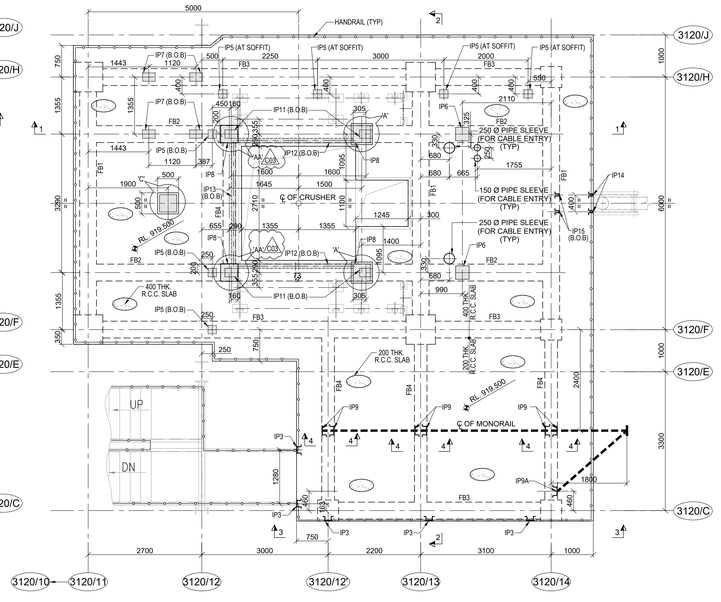

PLAN AT RL 919.500M LEVEL

(SCALE-1:50)

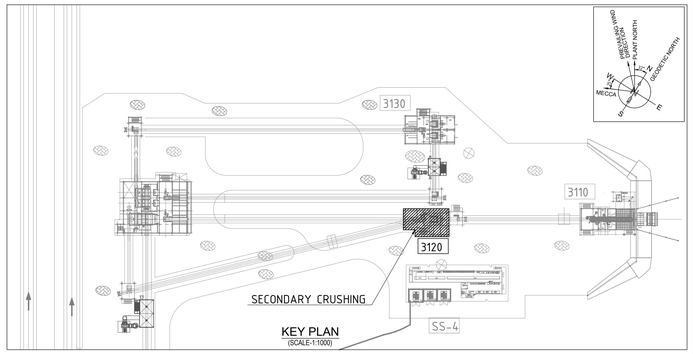

KEY PLAN


(SCALE-1:1000)

SCHEDULE OF BEAM

BEAM MKD.	SIZE WIDTH (mm.)	SIZE DEPTH (mm.)	LEVEL
TB1	300	550	RL. 912.850 (T.O.C.)
TB2	300	500	
FB1	400	1000	RL. 919.500 (T.O.C.)
FB2	400	900	
FB3	400	700	
FB4	300	500	


FOUNDATION SCHEDULE

FDN. MKD.	TYPE MKD.	PEDESTAL/COLUMN MKD.	FOUNDATION DETAILS L	B	D	BOTTOM OF FDN.	TOP OF PEDESTAL/COLUMN	NOS. FDN.
F1	I	P1	3000	2000	400	RL. 910.500	RL. 913.450	2
F1A	I	C1	3000	2000	400	RL. 910.500	RL. 919.500	2
F2	I	P3	4500	3300	900	RL. 910.500	RL. 913.450	2
CF1 & CF1A	II	P2 & P3	8300	3500	800	RL. 910.500	RL. 913.450	2
CF2	II	C2	9000	2000	500	RL. 910.500	RL. 919.500	1
CF3	II	C2	3000	6100	600	RL. 910.500	RL. 919.500	2

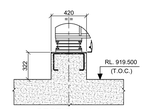


SECTION A1-A1

(SCALE 1:20)

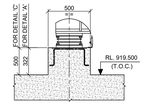


SECTION A-A

(SCALE 1:20)

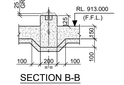

SECTION B-B

(SCALE 1:20)

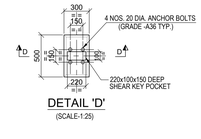

DETAIL 'D'

(SCALE-1:25)

DETAIL 'AA'


(SCALE 1:20)

DETAIL 'A' & 'C'

(SCALE 1:20)


DETAIL - 'B'

(SCALE 1:20)

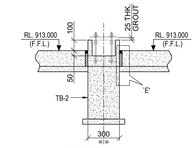


SECTION D-D

(SCALE-1:20)

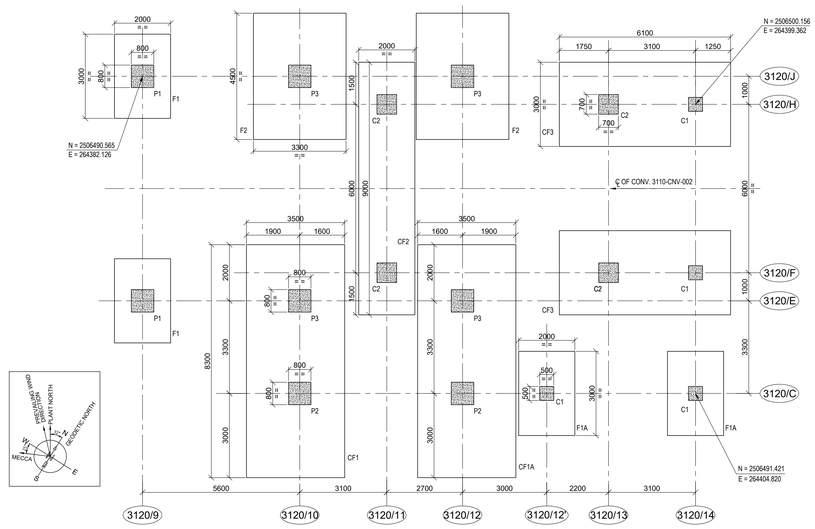


LAYOUT OF FOUNDATION

(SCALE-1:75)

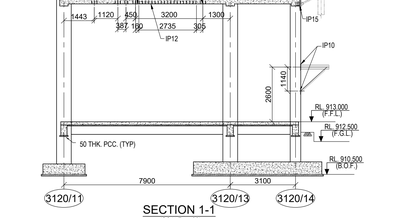


SECTION 1-1

(SCALE-1:100)

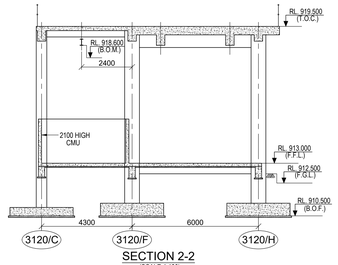

SECTION 2-2

(SCALE-1:100)

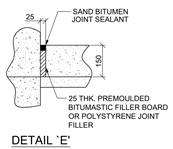


DETAIL 'E'

(SCALE-1:10)


SCHEDULE OF BOLTS

D BOLT DIA. MM	BxB BOTTOM PLATE (SQUARE) SQ MM	DIMENSIONS (MM) L	A	C	T	H
16	50x50	350	150	100	10	30
20	60x60	450	150	100	10	30
32	100x100	800	200	150	16	35
36	110x110	1000	225	175	20	35

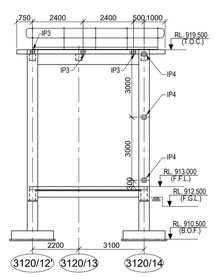

SECTION 3-3


(SCALE-1:100)

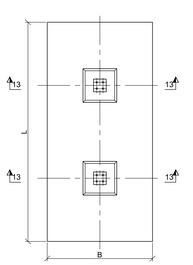

TYPICAL FOUNDATION PLAN

(TYPE-II)


(SCALE-1:50)

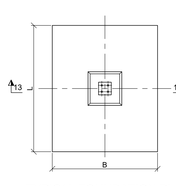

TYPICAL FOUNDATION PLAN


(TYPE-I)

(SCALE-1:50)

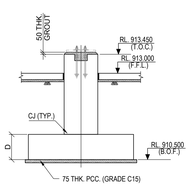

SECTION 13-13

(SCALE-1:50)

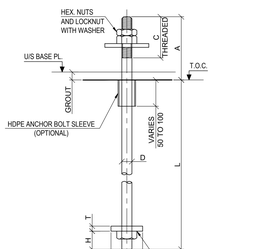

TYP. DETAIL OF BOLT

LEGENDS :-

R.L. - REDUCED LEVEL
℄ - CENTRE LINE
CJ - CONSTRUCTION JOINT
FDN. - FOUNDATION.
T.O.C. - TOP OF CONCRETE.
F.G.L. - FINISHED GROUND LEVEL.
F.F.L. - FINISHED FLOOR LEVEL.
B.O.F. - BOTTOM OF FOUNDATION
TYP. - TYPICAL.
B.O.B. - BOTTOM OF BEAM.
B.O.M. - BOTTOM OF MONORAIL.
R.C.C. - REINFORCED CEMENT CONCRETE
P.C.C. - PLAIN CEMENT CONCRETE
IP. - INSERT PLATE
MKD. - MARKED.
THK. - THICK

CMU - CONCRETE MASONRY UNIT

NOTES :-

1. ALL DIMENSIONS ARE IN MILLIMETRES AND LEVELS AND CO-ORDINATES ARE IN METRES. UNLESS OTHERWISE STATED.
2. GRADE OF CONCRETE SHALL BE C35 FOR FOUNDATION.
3. GRADE OF REINFORCEMENT SHALL BE DEFORMED BAR ASTM A615 - GRADE 60 (fy = 420 MPa).
4. NET SAFE BEARING CAPACITY OF SOIL AT BOTTOM OF FOUNDATION CONSIDERED 500KN/SQ. M.
5. CLEAR COVER TO MAIN REINFORCEMENT SHALL BE AS
   a) FOUNDATION = 75 mm (BOTTOM & SIDE) 50 mm. (TOP)
   b) COLUMN & PEDESTAL = 50mm
   c) BEAM = 50mm
   d) SLAB = 40mm
6. MINIMUM LAP LENGTH OF REINFORCEMENT SHALL BE 40 x DIA. OF BAR.
7. THIS DRG. SHALL BE READ IN CONJUNCTION WITH DRG. NO. MD-216-3120-EG-CV-GAD-1007 & MD-216-3120-EG-CV-DED-1004
8. FOR DETAIL OF HANDRAIL FIXING REFER STANDARD DRAWING.

DOCUMENT NUMBER	REFERENCE DOCUMENTS	REV	DATE	REVISION DESCRIPTION	DRN	CHK	ENG	APP	EMP
MD-216-3120-EG-ME-ELV-1012	SECONDARY CRUSHER HOUSE-ELEVATION								
MD-216-3120-EG-ME-ELV-1013	SECONDARY CRUSHER HOUSE-ELEVATION	D01	10/03/2023	AS-BUILT	JKM	SBY	APR	AG	
MD-216-3120-EG-ME-LPX-1014	SECONDARY CRUSHER HOUSE-PLAN VIEW	C03	19/10/2020	ISSUED FOR CONSTRUCTION & REVISED AS MKD. (C03)	JKM	SBY	APR	AG	
MD-216-3120-EG-ME-LPX-1015	SECONDARY CRUSHER HOUSE-PLAN VIEW	C02	26/06/2020	ISSUED FOR CONSTRUCTION & REVISED AS MKD. (C02)	MGH	SBY	APR	AG	
MD-216-3120-EG-ME-LPX-1016	SECONDARY CRUSHER HOUSE-PLAN VIEW	C01	11/03/2020	ISSUED FOR CONSTRUCTION, REVISED AS PER EMPLOYER					
MD-216-3120-EG-ME-LPX-1017	SECONDARY CRUSHER HOUSE-PLAN VIEW			COMMENTS DATED 26.02.2020 & REVISED AS MKD. (C01)	HSK	SBY	APR	AG	
MD-216-3120-EG-ME-LPX-1018	SECONDARY CRUSHER HOUSE-PLAN VIEW	A01	27/01/2020	ISSUED FOR REFERENCE	JKM	SBY	APR	AG	

RESERVED FOR VENDOR LOGO AND DRAWING NUMBER

LARSEN & TOUBRO

This drawing is the property of LARSEN & TOUBRO and must not be passed on to any person or body not authorized by us to receive it nor be copied or otherwise made use either in full or in part by such person or body without our prior permission in writing.

Outotec

The content of these documents are the sole property of Outotec Oyj. Any rights not expressly granted herein are reserved. Reproduction, transfer or distribution of part or all of the contents in any form without prior written permission of Outotec is prohibited.

MA'ADEN معادن
Saudi Arabian Mining Company شركة المعادن للتعدين العربية السعودية

This document and the information contained herein is Ma'aden proprietary know-how. This document or any part thereof should not be reproduced, stored in a retrieval system or transmitted by any means, electronic or otherwise, or divulged without prior written permission of Ma'aden.

LARSEN & TOUBRO DRAWING NUMBER: 019045_100_C_G_24062_001 | REVISION: 4
OUTOTEC DRAWING NUMBER: 900707__GAU01__ZC01__MTL01__31252 | DOCUMENT ID: OU100670443 | REVISION: 4

DRAWN	JKM	10/01/2020	MANSOURAH - MASSARAH GOLD PROJECT
CHECKED	SBY	21/01/2020	GENERAL ARRANGEMENT DRAWING
ENGINEER	APR	20/01/2020	SECONDARY CRUSHING
APPROVED	AG	27/01/2020	LAYOUT & DETAIL
EMPLOYER			
SCALE	1:100,1:75,1:50,1:25,1:20,1:10	A0	DRAWING NUMBER: MD - 216 - 3120 - EG - CV - GAD - 1004

REV: D01