

DRAWING NUMBER: MD - 216 - 3120 - EG - CV - GAD - 1005 | REV: D01

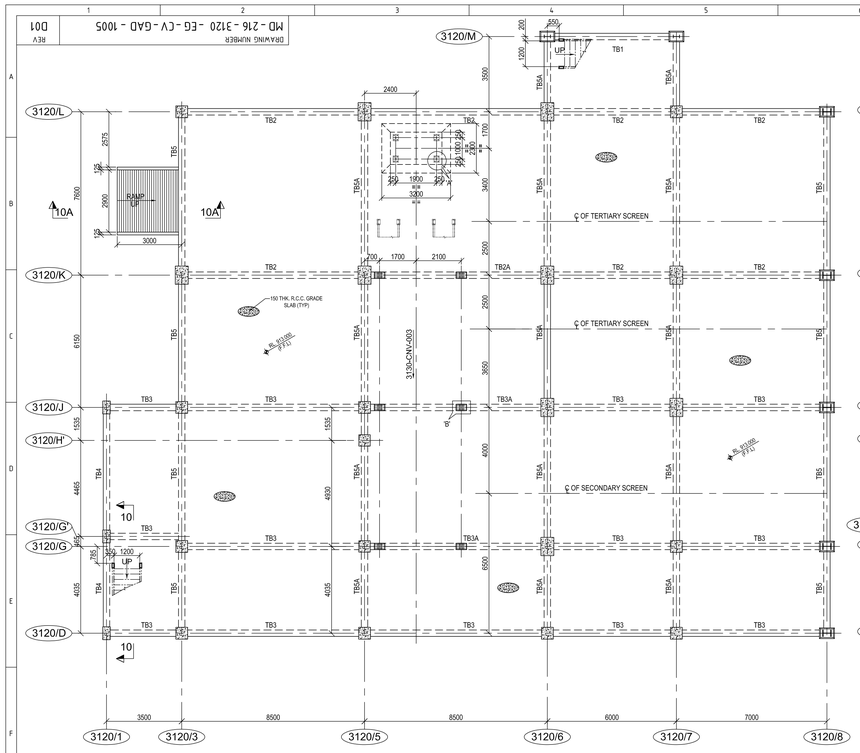


PLAN OF GRADE SLAB AT RL.913.000 (F.F.L) AND TIE BEAM AT RL. 912.850 (T.O.C)

(SCALE 1:100)

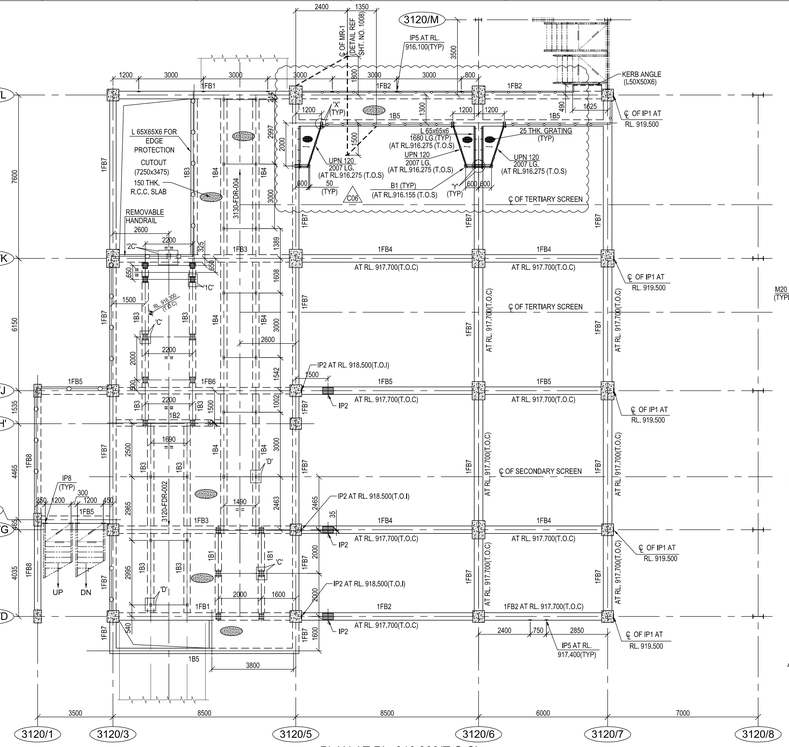

PLAN AT RL. 916.300(T.O.C)

(SCALE 1:100)

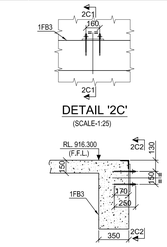


DETAIL '2C'

(SCALE-1:25)


SECTION 2C1-2C1

(SCALE-1:25)

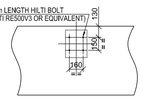


SECTION 2C2-2C2

(SCALE-1:25)

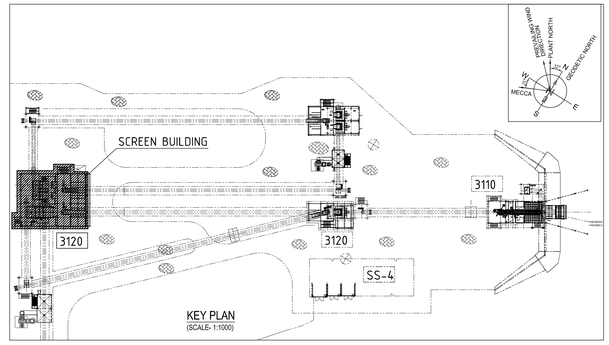

KEY PLAN

(SCALE- 1:1000)

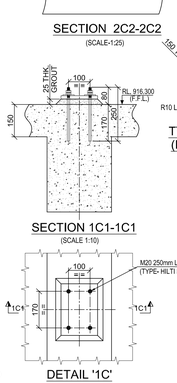

SECTION 1C1-1C1

(SCALE 1:10)

DETAIL '1C'

(SCALE 1:10)




TYP. DET.OF KERB ANGLE (FOR EDGE PROTECTION)

(SCALE 1:10)


TYP. DET.OF KERB ANGLE (FOR CUTOUT LOCATION)

(SCALE 1:10)

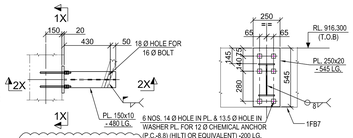


DETAIL OF BEAM MKD. AS "B1"

(SCALE - 1:20)

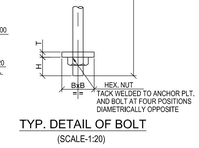


SECTION 1X-1X

(SCALE - 1:20)

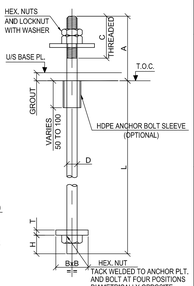

TYP. DETAIL OF BOLT

(SCALE-1:20)

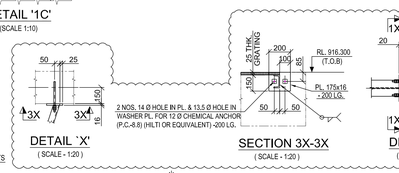

DETAIL `X`


(SCALE - 1:20)

SECTION 3X-3X

(SCALE - 1:20)


DETAIL `Y`

(SCALE - 1:20)

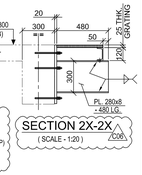

SECTION 2X-2X

(SCALE - 1:20)

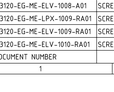

FOUNDATION PLAN

(SCALE 1:100)

SECTION 1-1

SECTION 2-2

SECTION 3-3

(FOR FOUNDATION MKD. F1, F2 & F4)

(SCALE - 1:50)

SECTION 4-4

SECTION 5-5

(FOR FOUNDATION MKD. F2A & F3)

(SCALE - 1:50)

SECTION 6-6

SECTION 7-7

SECTION 8-8

SECTION 9-9


SECTION 9A-9A

(FOR FOUNDATION MKD. F1A, F2B, F3A, F4A & CF1)

(SCALE - 1:50)


DETAIL - 'A'

(SCALE-1:25)

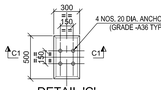


DETAIL 'C'

(SCALE-1:25)

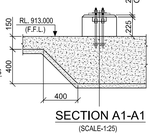

SECTION A1-A1

(SCALE-1:25)

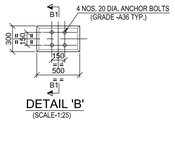

DETAIL 'B'

(SCALE-1:25)


SCHEDULE OF BOLTS (GRADE - A36)						
D BOLT DIA. MM	BxB BOTTOM PLATE (SQUARE) SQ MM	DIMENSIONS (MM)				
		L	A	C	T	H
16	50x50	350	150	100	10	30
20	60x60	450	160	110	10	30
24	75x75	600	175	125	12	30
32	100x100	800	190	140	16	35
40	120x120	1000	225	175	20	45

SCREEN FIXING BOLT OF GRADE - 8.8						
D BOLT DIA. MM	BxB BOTTOM PLATE (SQUARE) SQ MM	DIMENSIONS (MM)				
		L	A	C	T	H
16	50x50	-	125	100	12	30

SCHEDULE OF FOUNDATION				
FOUNDATION MKD.	SIZE			BOTTOM OF FOUNDATION
	WIDTH (mm.)	LENGTH (mm.)	THICKNESS (mm.)	
F1 & F1A	2500	2500	450	RL. 910.500
F2, F2A & F2B	3000	3000	600	RL. 910.500
F3 & F3A	3200	3200	700	RL. 910.500
F4	4000	4000	600	RL. 910.500
CF1	3000	4035	650	RL. 910.500
F4A	4000	4000	800	RL. 910.500


SCHEDULE OF COLUMN		
COLUMN MKD.	SIZE	
	WIDTH (mm.)	LENGTH (mm.)
C1	350	600
C2,C2A, C2B & C2C	550	550
C3, C3A & C3B	600	850
P1, P2, P3 & P4	500	700

SCHEDULE OF BEAM			
BEAM MKD.	SIZE		LEVEL
	WIDTH (mm.)	DEPTH (mm.)	
TB1, TB2 , TB3, TB2A & TB3A	300	550	RL. 912.850 (T.O.B.)
TB4, TB5 & TB5A	300	500	
1FB1	350	850	
1FB2,1FB4 & 1FB5	350	600	RL. 916.300 (T.O.C.) RL. 917.700 (T.O.C.)
1FB3 & 1FB6	350	1000	
1FB7 &1FB8	300	550	
1B1 & 1B2	300	500	
1B3,1B4 & 1B5	300	500	

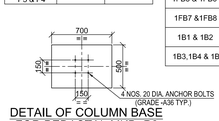


DETAIL OF COLUMN BASE FOR PEDASTAL MKD. P2

(SCALE-1:25)

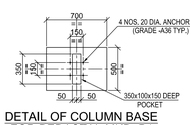


DETAIL OF COLUMN BASE FOR PEDASTAL MKD. P1

(SCALE-1:25)

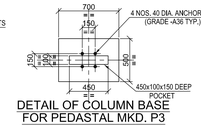


DETAIL OF COLUMN BASE FOR PEDASTAL MKD. P3

(SCALE-1:25)

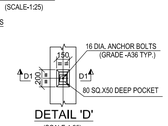


DETAIL 'D'

(SCALE-1:25)

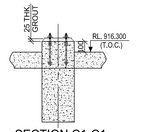


SECTION C1-C1

(SCALE-1:20)

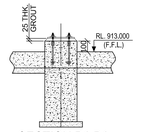


SECTION B1-B1

(SCALE-1:20)

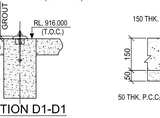


SECTION D1-D1

(SCALE-1:20)

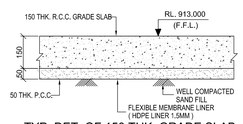


TYP. DET. OF 150 THK. GRADE SLAB

(SCALE 1:10)

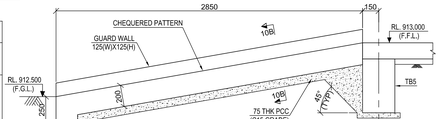


SECTION 10A-10A

(SCALE-1:20)

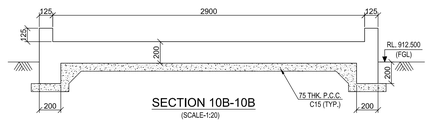

SECTION 10B-10B

(SCALE-1:20)

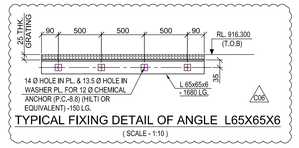

TYPICAL FIXING DETAIL OF ANGLE L65X65X6

(SCALE - 1:10)

LEGENDS :-

RL. - REDUCED LEVEL
℄ - CENTRE LINE
T.O.C. - TOP OF CONCRETE.
F.G.L. - FINISHED GROUND LEVEL.
B.O.F. - BOTTOM OF FOUNDATION
B.O.B. - BOTTOM OF BEAM
TYP. - TYPICAL.
R.C.C - REINFORCED CEMENT CONCRETE
P.C.C - PLAIN CEMENT CONCRETE
MKD. - MARKED
THK. - THICK
MR. - MONORAIL
B.O.M.R. - BOTTOM OF MONORAIL
SEC. - SECTION
IP - INSERT PLATE
MM - MILLIMETER
SQ. - SQUARE
T.O.B. - TOP OF BEAM
T.O.I. - TOP OF INSERT
PL. - PLATE
LG. -LONG

NOTES :-

1. ALL DIMENSIONS ARE IN MILLIMETRES AND LEVELS AND CO-ORDINATES ARE IN METRES, UNLESS OTHERWISE STATED.
2. GRADE OF CONCRETE SHALL BE C35 FOR FOUNDATION.
3. GRADE OF REINFORCEMENT SHALL BE DEFORMED BAR ASTM A615 - GRADE 60 (fy = 420 MPa).
4. NET SAFE BEARING CAPACITY OF SOIL AT BOTTOM OF FOUNDATION CONSIDERED 500KN/SQ. M.
5. CLEAR COVER TO MAIN REINFORCEMENT SHALL BE AS
   a) FOUNDATION = 75mm (BOTTOM & SIDE) 50 mm (TOP)
   b) TIE BEAM = 50 mm c) COLUMN = 50mm d) BEAM = 50mm e) SLAB = 40mm
6. FOR MINIMUM LAP LENGTH OF REINFORCEMENT REFER STANDARD DRAWING NO. MD-216-1000-EG-CV-DED-1001
7. THIS DRG. SHALL BE READ IN CONJUNCTION WITH DRG. NO. MD-216-3120-EG-CV-GAD-1004 & 1008, MD-216-3120-EG-CV-DED-1005 & 1006
8. FOR DETAIL OF HANDRAIL FIXING REFER STANDARD DRAWING.

DOCUMENT NUMBER	REFERENCE DOCUMENTS	REV	DATE	REVISION DESCRIPTION	DRN	CHK	ENG	APP	EMP
MD-216-3120-EG-ME-LPX-1004-RA01	SCREEN HOUSE-PLAN VIEW	D01	10/03/2023	AS-BUILT	JKM	SBY	RPK	AG	
MD-216-3120-EG-ME-LPX-1005-RA01	SCREEN HOUSE - PLAN VIEW	C06	30/01/2023	ISSUED FOR CONSTRUCTION & REVISED AS MKD. C06	JKM	SBY	RPK	AG	
MD-216-3120-EG-ME-LPX-1006-RA01	SCREEN HOUSE - PLAN VIEW	C05	13/02/2021	ISSUED FOR CONSTRUCTION & REVISED AS MKD. C05	JKM	SBY	RPK	AG	
MD-216-3120-EG-ME-LPX-1007-RA01	SCREEN HOUSE - PLAN VIEW	C04	06/01/2021	ISSUED FOR CONSTRUCTION & REVISED AS MKD. C04	JKM	SBY	RPK	AG	
MD-216-3120-EG-ME-LPX-1008-RA01	SCREEN HOUSE - PLAN VIEW	C03	12/08/2020	ISSUED FOR CONSTRUCTION & REVISED AS MKD. C03	JKM	SBY	RPK	AG	
MD-216-3120-EG-ME-ELV-1008-A01	SCREEN HOUSE - ELEVATION	C02	22/06/2020	ISSUED FOR CONSTRUCTION & REVISED AS MKD. C02	MGH	SBY	RPK	AG	
MD-216-3120-EG-ME-LPX-1009-RA01	SCREEN HOUSE - PLAN VIEW	C01	09/04/2020	ISSUED FOR CONSTRUCTION, REVISED AS PER EMPLOYER COMMENTS DATED 04/04/2020 & REVISED AS MKD. C01	MGH	SBY	RPK	AG	
MD-216-3120-EG-ME-ELV-1010-RA01	SCREEN HOUSE - ELEVATION	A01	07/03/2020	ISSUED OF REFERENCE	MGH	SBY	RPK	AG	

RESERVED FOR VENDOR LOGO AND DRAWING NUMBER

LARSEN & TOUBRO

This drawing is the property of LARSEN & TOUBRO and must not be passed on to any person or body not authorized by us to receive it nor be copied or otherwise made use either in full or in part by such person or body without our prior permission in writing.

Outotec

The content of these documents are the sole property of Outotec Oyj. Any rights not expressly granted herein are reserved. Reproduction, transfer or distribution of part or all of the contents in any form without prior written permission of Outotec is prohibited.

MA'ADEN معادن

Saudi Arabian Mining Company شركة معادن العربية السعودية

This document and the information contained herein is Ma'aden proprietary know-how. This document or any part thereof should not be reproduced, stored in a retrieval system or transmitted by any means, electronic or otherwise, or divulged without prior written permission of Ma'aden.

LARSEN & TOUBRO DRAWING NUMBER	019045_100_C_G_24068_001
REVISION	7
OUTOTEC DRAWING NUMBER	900707 _ GAU01 _ ZC01 _ MTL01 _ 31258
DOCUMENT ID	OU100670457
REVISION	7

DRAWN	MGH	29/02/2020
CHECKED	SBY	05/03/2020
ENGINEER	RPK	04/03/2020
APPROVED	AG	07/03/2020
EMPLOYER		

MANSOURAH - MASSARAH GOLD PROJECT
GENERAL ARRANGEMENT DRAWING
SCREEN BUILDING
FOUNDATION LAYOUT, FLOOR PLAN & DETAILS

SCALE	DRAWING NUMBER	REV
1:100,1:75,1:50,1:25,1:20,1:10	MD - 216 - 3120 - EG - CV - GAD - 1005	D01

A0