


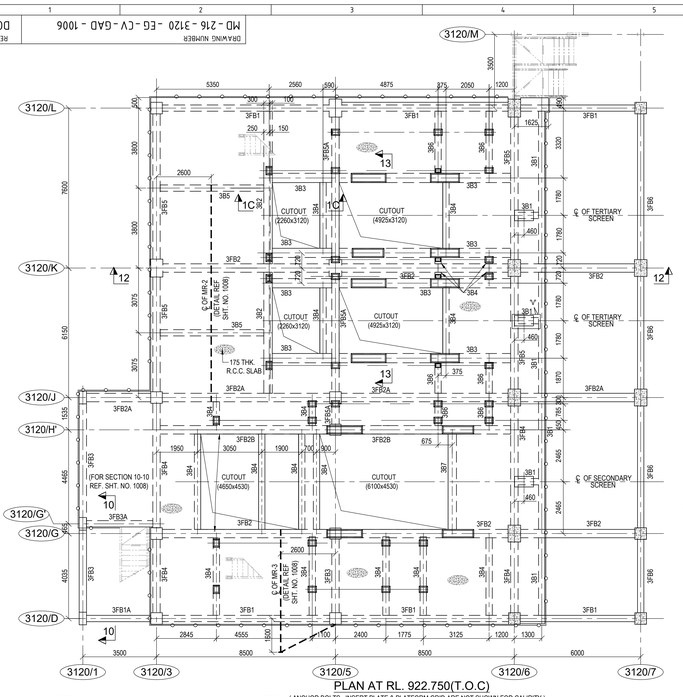


PLAN AT RL. 922.750(T.O.C)

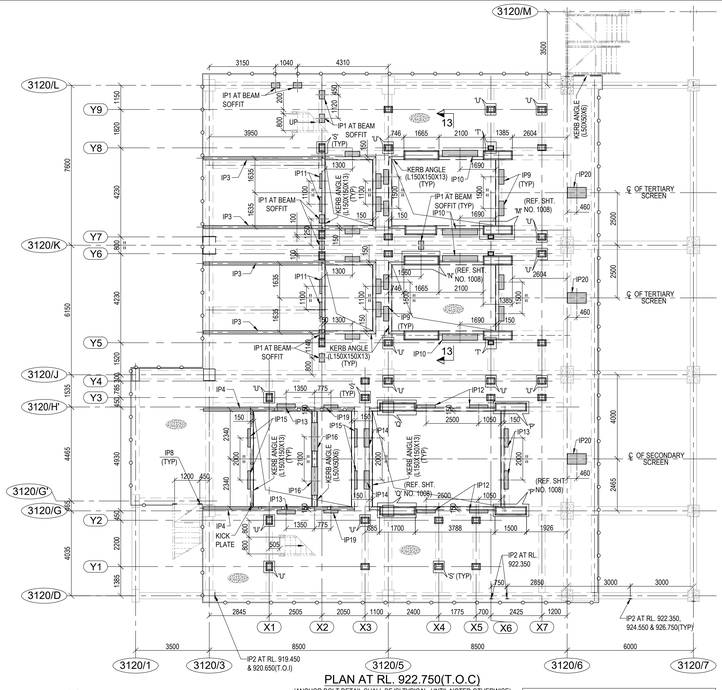


PLAN AT RL. 922.750(T.O.C)
(ANCHOR BOLT DETAIL SHALL BE 'S' TYPICAL, UNTIL NOTED OTHERWISE)
(BEAM MARKING ARE NOT SHOWN FOR CLARITY)

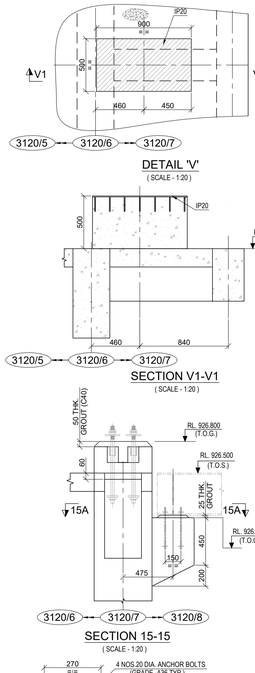

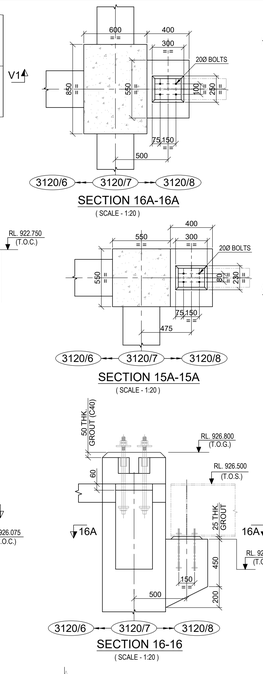


SECTION 1A-1A
(SCALE - 1:20)

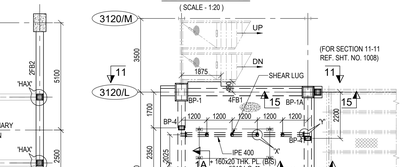


SECTION 1B-1B
(SCALE - 1:20)


DETAIL 'Z'
(SCALE - 1:20)

SECTION Z1-Z1
(SCALE - 1:20)

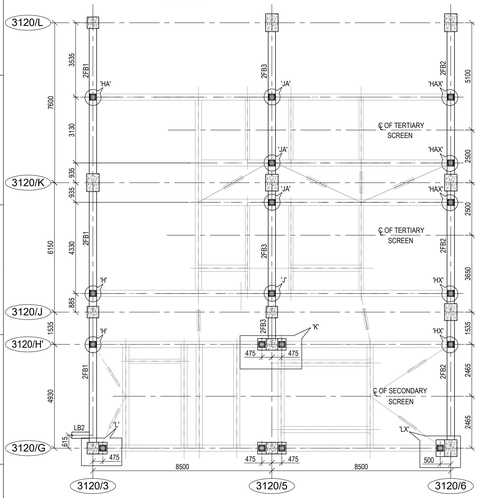


PLAN AT EL. 920.025(T.O.C)
(SCALE 1:100)

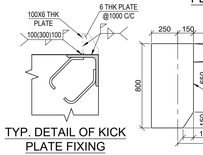


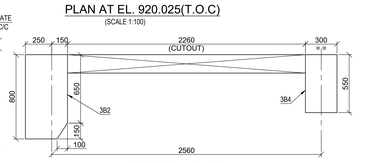

SECTION 1C-1C
(SCALE - 1:20)

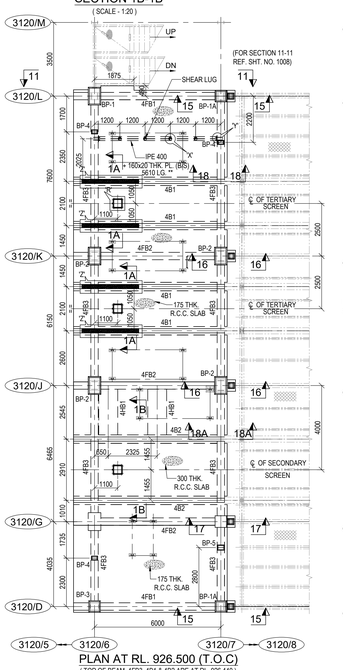

PLAN AT RL. 926.500 (T.O.C)
(TOP OF BEAM 4FB3, 4B1 & 4B2 ARE AT RL. 926.440)
(EMBEDDED PARTS ARE NOT SHOWN FOR CLARITY)
(SCALE - 1:100)

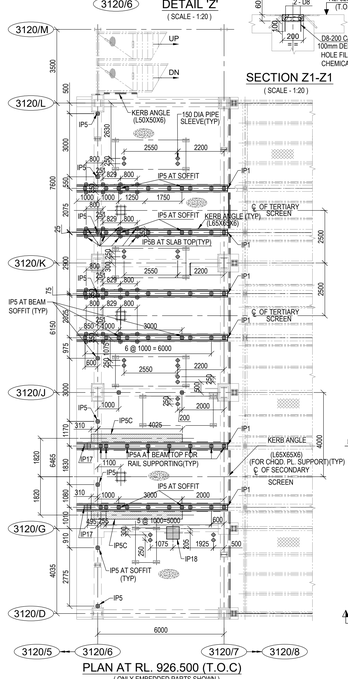


SECTION Z1-Z1
(SCALE - 1:20)

DETAIL 'Z'
(SCALE - 1:20)

PLAN AT RL. 926.500 (T.O.C)
(ONLY EMBEDDED PARTS SHOWN)
(SCALE - 1:100)

SCHEDULE OF BEAM

BEAM MKD.	SIZE WIDTH (mm.)	SIZE DEPTH (mm.)	LEVEL
2FB1	350	650	RL. 920.025 (T.O.B.)
2FB2	350	650	
2FB3	350	1000	
3FB1 & 3FB1A	300	1050	
3FB2A	400	1050	
3FB2 & 3FB2B	400	1150	
3FB3 & 3FB3A	350	650	
3FB4	350	1200	
3FB5	350	850	RL. 922.750 (T.O.B.)
3FB5A	350	1000	
3FB6	300	500	
3B1	300	500	
3B2	400	800	
3B3	440	750	
3B4	300	550	
3B5	300	600	
3B6	300	600	
3B7	300	700	
4FB1	350	600	RL. 926.500 (T.O.B.)
4FB2	350	600	
4FB3	350	750	
4HB1	900	300	
4B1	400	550	RL. 926.440 (T.O.B.)
4B2	400	650	

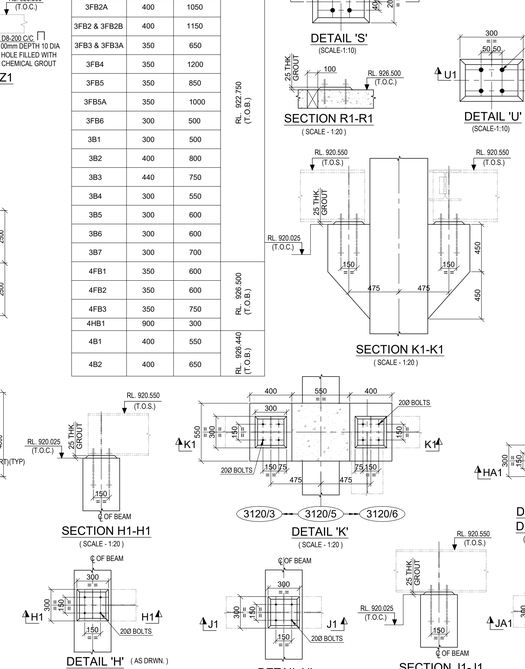

NOTES :-

1. ALL DIMENSIONS ARE IN MILLIMETRES AND LEVELS AND CO-ORDINATES ARE IN METRES. UNLESS OTHERWISE STATED.
2. GRADE OF CONCRETE SHALL BE C35 FOR FOUNDATION.
3. GRADE OF REINFORCEMENT SHALL BE DEFORMED BAR ASTM A615 - GRADE 60 (fy = 420 MPa).
4. NET SAFE BEARING CAPACITY OF SOIL AT BOTTOM OF FOUNDATION CONSIDERED 600KN/SQ. M.
5. CLEAR COVER TO MAIN REINFORCEMENT SHALL BE AS
   a) FOUNDATION = 75mm (BOTTOM & SIDE) 50 mm (TOP)
   b) TIE BEAM = 50 mm c) COLUMN = 50mm d) BEAM = 50mm e) SLAB = 40mm
6. FOR MINIMUM LAP LENGTH OF REINFORCEMENT REFER STANDARD DRAWING NO. MD-216-1000-EG-CV-DED-1001
7. THIS DRG. SHALL BE READ IN CONJUNCTION WITH DRG. NO. MD-216-3120-EG-CV-GAD-1005 & 1008, MD-216-3120-EG-CV-DED-1005 & 1006
8. WHERE KERB ANGLE AND INSERT PLATE IS OVERLAPING , KERB ANGLE SHALL BE DISCONTINUED AT THAT LOCATION LOCALLY.
9. VIBRO FEEDER SHALL BE MOVED TO THE MAINTENANCE POSITION BEFORE MODIFICATIONS.
10. ** TO BE CONFIRMED AT SITE.

LEGENDS :-
RL - REDUCED LEVEL
℄ - CENTRE LINE.
T.O.C. - TOP OF CONCRETE.
F.G.L. - FINISHED GROUND LEVEL.
B.O.F. - BOTTOM OF FOUNDATION
B.O.B. - BOTTOM OF BEAM
TYP. - TYPICAL
R.C.C - REINFORCED CEMENT CONCRETE
P.C.C. - PLAIN CEMENT CONCRETE
MKD. - MARKED
THK. - THICK
MR. - MONORAIL
B.O.M.R. - BOTTOM OF MONORAIL
SEC. - SECTION
IP - INSERT PLATE
MM - MILLIMETER
SQ. - SQUARE
T.O.B. - TOP OF BEAM
T.O.I. - TOP OF INSERT
REF. - REFER
SHT. - SHEET

DOCUMENT NUMBER	REFERENCE DOCUMENTS	REV	DATE	REVISION DESCRIPTION	DRN	CHK	ENG	APP	EMP
		D01	10/03/2023	AS-BUILT	JKM	SBY	RPK	AG	
		C08	06/08/2022	ISSUED FOR CONSTRUCTION & REVISED AS MKD	JKM	SBY	RPK	AG	
MD-216-3120-EG-ME-LPX-1004-RA01	SCREEN HOUSE-PLAN VIEW	C07	15/06/2022	ISSUED FOR CONSTRUCTION & REVISED AS MKD	HSK	SBY	RPK	AG	
MD-216-3120-EG-ME-LPX-1005-RA01	SCREEN HOUSE - PLAN VIEW	C06	02/04/2021	ISSUED FOR CONSTRUCTION & REVISED AS MKD	JKM	SBY	RPK	AG	
MD-216-3120-EG-ME-LPX-1006-RA01	SCREEN HOUSE - PLAN VIEW	C05	06/01/2021	ISSUED FOR CONSTRUCTION & REVISED AS MKD	HSK	SBY	RPK	AG	
MD-216-3120-EG-ME-LPX-1007-RA01	SCREEN HOUSE - PLAN VIEW	C04	05/12/2020	ISSUED FOR CONSTRUCTION & REVISED AS MKD	HSK	SBY	RPK	AG	
MD-216-3120-EG-ME-LPX-1008-RA01	SCREEN HOUSE - PLAN VIEW	C03	12/08/2020	ISSUED FOR CONSTRUCTION & REVISED AS MKD	JKM	SBY	RPK	AG	
MD-216-3120-EG-ME-ELV-1008-A01	SCREEN HOUSE - ELEVATION	C02	22/06/2020	ISSUED FOR CONSTRUCTION & REVISED AS MKD	MGH	SBY	RPK	AG	
MD-216-3120-EG-ME-LPX-1009-RA01	SCREEN HOUSE - PLAN VIEW	C01	09/04/2020	ISSUED FOR CONSTRUCTION, REVISED AS PER EMPLOYER COMMENTS DATED 04/04/2020 & REVISED AS MKD	MGH	SBY	RPK	AG	
MD-216-3120-EG-ME-LPX-1010-RA01	SCREEN HOUSE - PLAN VIEW								
MD-216-3120-EG-ME-ELV-1010-RA01	SCREEN HOUSE - ELEVATION	A01	07/03/2020	ISSUED OF REFERENCE	MGH	SBY	RPK	AG	

RESERVED FOR VENDOR LOGO AND DRAWING NUMBER

LARSEN & TOUBRO

This drawing is the property of LARSEN & TOUBRO and must not be passed on to any person or body not authorized by us to receive it nor be copied or otherwise made use either in full or in part by such person or body without our prior permission in writing.

Outotec

The content of these documents are the sole property of Outotec Oy. Any rights not expressly granted herein are reserved. Reproduction, transfer or distribution of part or all of the contents in any form without prior written permission of Outotec is prohibited.

MA'ADEN معادن
Saudi Arabian Mining Company شركة معادن العربية السعودية

This document and the information contained herein is Ma'aden proprietary know-how. This document or any part thereof should not be reproduced, stored in a retrieval system or transmitted by any means, electronic or otherwise, or divulged without prior written permission of Ma'aden.

LARSEN & TOUBRO DRAWING NUMBER	0190455_100_C_G_Z4068_002
REVISION	9
OUTOTEC DRAWING NUMBER	900707__GAU01__ZC01__MTL01__31269
DOCUMENT ID	OU100671386
REVISION	9
DRAWN	MGH 29/02/2020
CHECKED	SBY 05/03/2020
ENGINEER	RPK 04/03/2020
APPROVED	AG 07/03/2020
EMPLOYER	
SCALE	1:100,1:75,1:50,1:25,1:20,1:10
	A0

MANSOURAH - MASSARAH GOLD PROJECT
GENERAL ARRANGEMENT DRAWING
SCREEN BUILDING
FLOOR PLANS & DETAILS

DRAWING NUMBER: MD - 216 - 3120 - EG - CV - GAD - 1006
REV: D01