


DRAWING NUMBER: MD-216-3120-EG-CV-GAD-1008 | REV: D01

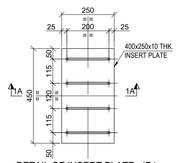


DETAIL OF INSERT PLATE - IP1
(SCALE 1:10)

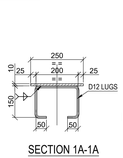


SECTION 1A-1A
(SCALE 1:10)

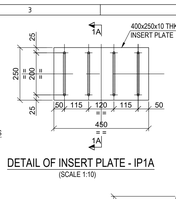


DETAIL OF INSERT PLATE - IP1A
(SCALE 1:10)

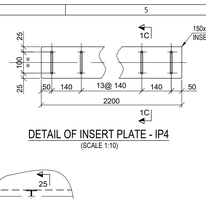


DETAIL OF INSERT PLATE - IP4
(SCALE 1:10)

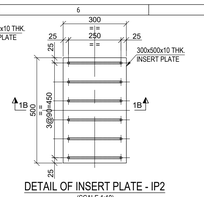


DETAIL OF INSERT PLATE - IP2
(SCALE 1:10)

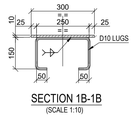


SECTION 1B-1B
(SCALE 1:10)

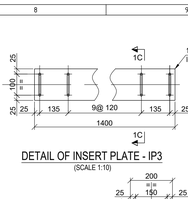


DETAIL OF INSERT PLATE - IP3
(SCALE 1:10)

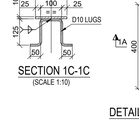

SECTION 1C-1C
(SCALE 1:10)

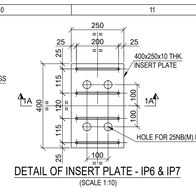


DETAIL OF INSERT PLATE - IP6 & IP7
(SCALE 1:10)

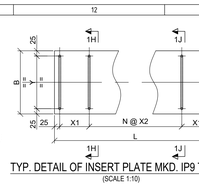


TYP. DETAIL OF INSERT PLATE MKD. IP9 TO IP20 & IP5C
(SCALE 1:10)

SCHEDULE OF INSERT PLATE


INSERT PLATE MKD.	SIZE	PURPOSE
IP1 & IP1A	250x450x10 THK.	FOR STRUCTURAL
IP2	300x500x10 THK.	FOR DUCT SUPPORT
IP3	150x5600(4X1400) 10 THK.	FOR EQUIPMENT
IP4	150x2200x10 THK	
IP5	150x150x10 THK.	FOR CABLE SUPPORT
IP5A	150x150x10 THK.	FOR RAIL SUPPORT
IP5B	150x150x10 THK.	FOR VIBRO FEEDER SUPPORT
IP5C	4335x400x10 THK.	FOR VIBRO FEEDER SUPPORT
IP6 & IP7	250x400x10 THK.	FOR MONORAIL SUPPORT
IP6A	250x350x10 THK.	FOR MONORAIL SUPPORT
IP8	200x300x10 THK.	FOR STAIR SUPPORT
IP9	250x700x10 THK.	
IP10	300x1680x10 THK.	
IP11	100x700x10 THK.	
IP12	150x875x10 THK.	
IP13	200x875x10 THK.	FOR EQUIPMENT
IP14	250x875x10 THK.	
IP15	120x875x10 THK.	
IP16	300x1350x10 THK.	
IP17	300x200x10 THK.	FOR BUFFER STOP
IP18	600x600x10 THK.	FOR EQUIPMENT
IP19	150x675x10 THK.	
IP20	900x500x10 THK.	

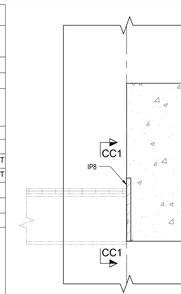


DETAIL - CC
(SCALE - 1:10)

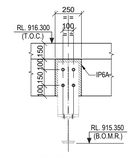


SECTION 23A-23A
(SCALE-1:20)

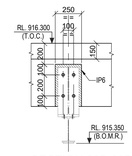


SECTION 23B-23B
(SCALE-1:20)

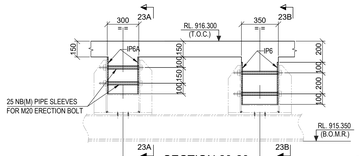

SECTION 23-23
(SCALE-1:20)

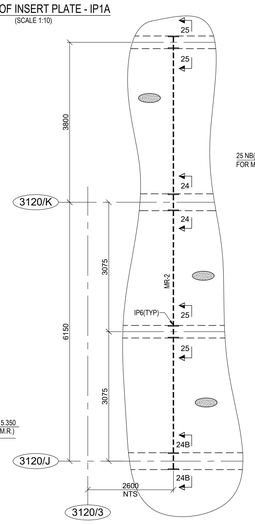


DETAIL OF MR-2
(SCALE - 1:50)

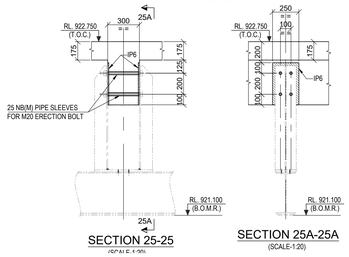


SECTION 25-25
(SCALE-1:20)


SECTION 25A-25A
(SCALE-1:20)

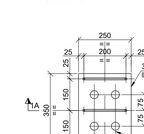


DETAIL OF INSERT PLATE - IP6A
(SCALE 1:10)

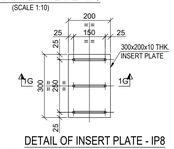


DETAIL OF INSERT PLATE - IP8
(SCALE 1:10)

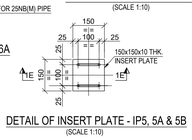


DETAIL OF INSERT PLATE - IP5, 5A & 5B
(SCALE 1:10)

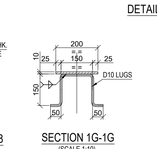


SECTION 1G-1G
(SCALE 1:10)

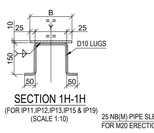

SECTION 1H-1H
(FOR IP11,IP12,IP13,IP15 & IP19)
(SCALE 1:10)

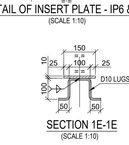

SECTION 1E-1E
(SCALE 1:10)

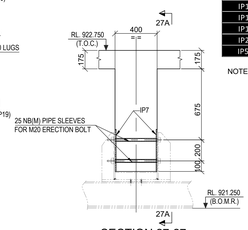


SECTION 27-27
(SCALE-1:20)


NOTE :- CONSIDER 6mm WELD ON BOTH SIDE OF THE LUGS.

DETAILS OF INSERT PLATE MKD. IP9 TO IP20


INSERT MKD	L(mm)	B(mm)	X1(mm)	X2(mm)	N	Y(mm)
IP9	700	250	105	110	4	200
IP10	1680	300	140	135	10	250
IP11	700	100	130	130	3	50
IP12	875	150	142.5	135	4	100
IP13	875	200	142.5	135	4	150
IP14	875	250	125	115	5	200
IP15	875	120	142.5	135	4	70
IP16	1350	300	130	130	8	250
IP17	300	200	125	125	1	150
IP18	600	600	110	110	3	550
IP19	675	150	125	125	3	100
IP20	900	500	145	140	4	450
IP5C	4335	400	117.5	150	27	350

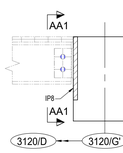


DETAIL - AA
(SCALE - 1:10)

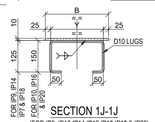


SECTION 1J-1J
(FOR IP9, IP10,IP14,IP16,IP17,IP18 & IP20)
(SCALE 1:10)

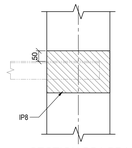


SECTION BB1-BB1
(SCALE - 1:10)

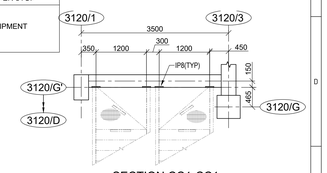


SECTION CC1-CC1
(SCALE - 1:50)

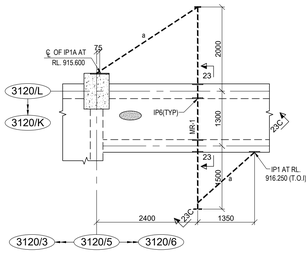


DETAIL OF MR-1
(SCALE - 1:50)

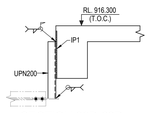


SECTION 23D-23D
(SCALE-1:20)

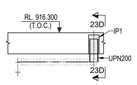


SECTION 23C-23C
(SCALE - 1:50)

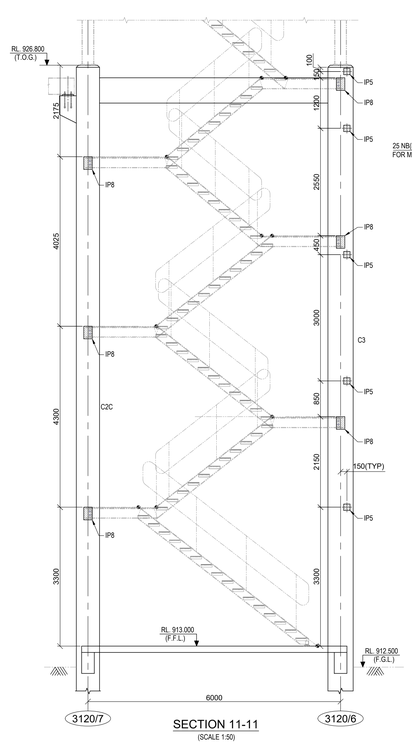


SECTION 11-11
(SCALE 1:50)

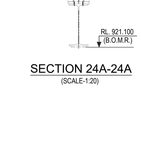


SECTION 24A-24A
(SCALE-1:20)

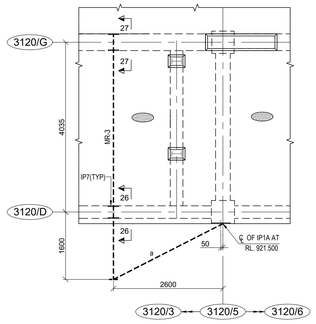


DETAIL OF MR-3
(SCALE - 1:50)

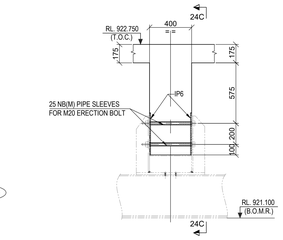


SECTION 24B-24B
(SCALE-1:20)

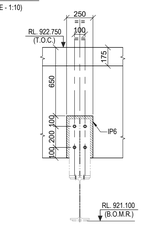


SECTION 24C-24C
(SCALE-1:20)

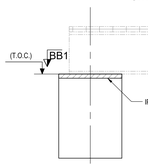


DETAIL - BB
(SCALE - 1:10)

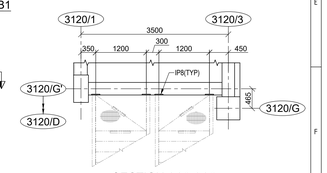


SECTION AA1-AA1
(SCALE - 1:50)

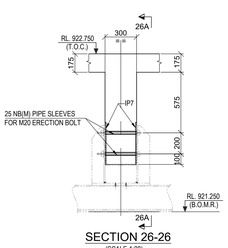


SECTION 26-26
(SCALE-1:20)

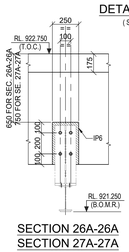


SECTION 26A-26A
SECTION 27A-27A
(SCALE-1:20)

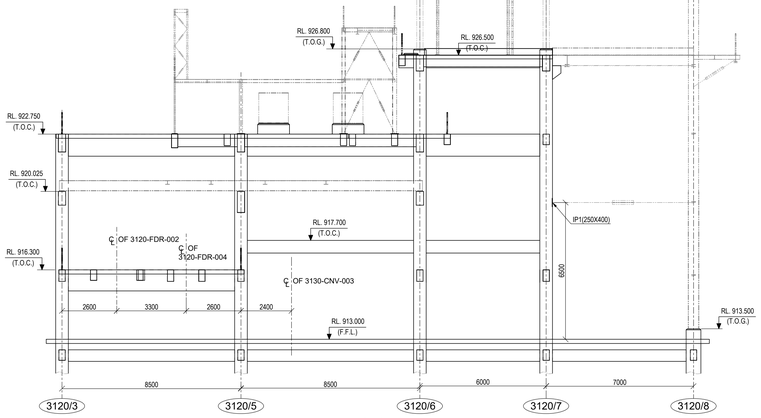


SECTION 12-12
(SCALE 1:100)

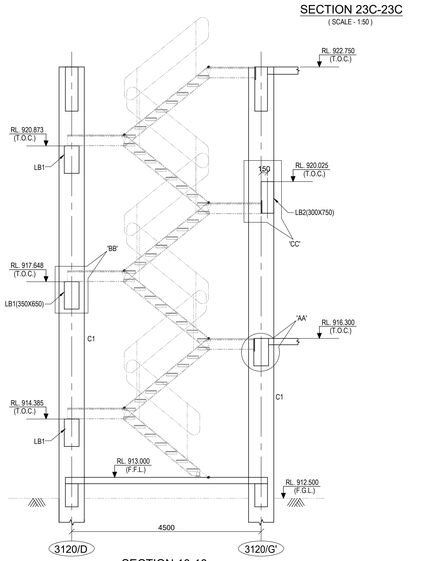


SECTION 10-10
(SCALE 1:50)

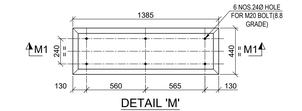


SECTION M1-M1
(SCALE - 1:20)

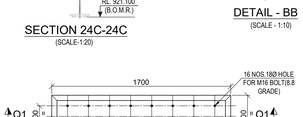

DETAIL 'Q'
(SCALE - 1:20)

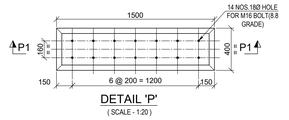


DETAIL 'P'
(SCALE - 1:20)

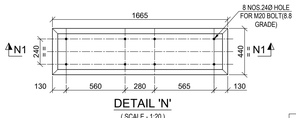


DETAIL 'N'
(SCALE - 1:20)


DETAIL 'M'
(SCALE - 1:20)

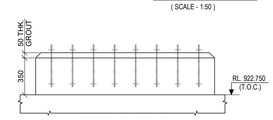

SECTION Q1-Q1
(SCALE - 1:20)

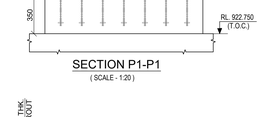

SECTION P1-P1
(SCALE - 1:20)

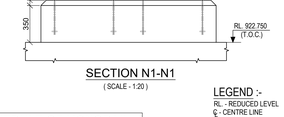

SECTION N1-N1
(SCALE - 1:20)

SCHEDULE OF MONORAIL

MEMBER MKD.	SECTION	MEMBER
MR-1 & MR-3	I-1 2	1. IPE240 2. PL. 100X12
MR-2	I-1 2	1. IPE400 2. PL. 140X12
a	+	2L 65X65X6

LEGEND :-
RL - REDUCED LEVEL
℄ - CENTRE LINE
T.O.C. - TOP OF CONCRETE.
F.G.L - FINISHED GROUND LEVEL.
B.O.F. - BOTTOM OF FOUNDATION
B.O.B. - BOTTOM OF BEAM
TYP. - TYPICAL.
R.C.C - REINFORCED CEMENT CONCRETE
P.C.C - PLAIN CEMENT CONCRETE
MKD. - MARKED
THK. - THICK
MR. - MONORAIL
B.O.M.R. - BOTTOM OF MONORAIL
SEC. - SECTION
IP - INSERT PLATE
MM - MILLIMETER
SQ. - SQUARE
T.O.I. - TOP OF INSERT

NOTES :-
1. ALL DIMENSIONS ARE IN MILLIMETRES AND LEVELS AND CO-ORDINATES ARE IN METRES. UNLESS OTHERWISE STATED.
2. GRADE OF CONCRETE SHALL BE C35 FOR FOUNDATION.
3. GRADE OF REINFORCEMENT SHALL BE DEFORMED BAR ASTM A615 - GRADE 60 (fy = 420 MPa).
4. NET SAFE BEARING CAPACITY OF SOIL AT BOTTOM OF FOUNDATION CONSIDERED 500KN/SQ. M.
5. CLEAR COVER TO MAIN REINFORCEMENT SHALL BE AS
   a) FOUNDATION = 75mm (BOTTOM & SIDE) 50 mm (TOP)
   b) TIE BEAM = 50 mm c) COLUMN = 50mm d) BEAM = 50mm e) SLAB = 40mm
6. FOR MINIMUM LAP LENGTH OF REINFORCEMENT REFER STANDARD DRAWING NO. MD-216-1000-EG-CV-DED-1001
7. THIS DRG. SHALL BE READ IN CONJUNCTION WITH DRG. NO. MD-216-3120-EG-CV-GAD-1005 & 1006, MD-216-3120-EG-CV-DED-1005 & 1006

DOCUMENT NUMBER	REFERENCE DOCUMENTS	REV	DATE	REVISION DESCRIPTION	DRN	CHK	ENG	APP	EMP
MD-216-3120-EG-ME-LPX-1004-RA01	SCREEN HOUSE-PLAN VIEW								
MD-216-3120-EG-ME-LPX-1005-RA01	SCREEN HOUSE - PLAN VIEW								
MD-216-3120-EG-ME-LPX-1006-RA01	SCREEN HOUSE - PLAN VIEW	D01	10/03/2023	AS-BUILT	MGH	SBY	RPK	AG	
MD-216-3120-EG-ME-LPX-1007-RA01	SCREEN HOUSE - PLAN VIEW	C04	05/12/2020	ISSUED FOR CONSTRUCTION & REVISED AS MKD. C04	MGH	SBY	RPK	AG	
MD-216-3120-EG-ME-LPX-1008-RA01	SCREEN HOUSE - PLAN VIEW	C03	12/08/2020	ISSUED FOR CONSTRUCTION & REVISED AS MKD. C03	JKM	SBY	RPK	AG	
MD-216-3120-EG-ME-ELV-1008-A01	SCREEN HOUSE - ELEVATION	C02	22/06/2020	ISSUED FOR CONSTRUCTION & REVISED AS MKD. C02	MGH	SBY	RPK	AG	
MD-216-3120-EG-ME-LPX-1009-RA01	SCREEN HOUSE - PLAN VIEW	C01	09/04/2020	ISSUED FOR CONSTRUCTION, REVISED AS PER EMPLOYER COMMENTS C01					
MD-216-3120-EG-ME-ELV-1009-RA01	SCREEN HOUSE - PLAN VIEW			COMMENTS DATED 04/04/2020 & REVISED AS MKD. C01	MGH	SBY	RPK	AG	
MD-216-3120-EG-ME-ELV-1010-RA01	SCREEN HOUSE - ELEVATION	A01	07/03/2020	ISSUED OF REFERENCE	MGH	SBY	RPK	AG	

RESERVED FOR VENDOR LOGO AND DRAWING NUMBER

LARSEN & TOUBRO

This drawing is the property of LARSEN & TOUBRO and must not be passed on to any person or body not authorized by us to receive it nor be copied or otherwise made use either in full or in part by such person or body without our prior permission in writing.

Outotec

The content of these documents are the sole property of Outotec Oyj. Any rights not expressly granted herein are reserved. Reproduction, transfer or distribution of part or all of the contents in any form without prior written permission of Outotec is prohibited.

MA'ADEN معادن Saudi Arabian Mining Company شركة المملكة العربية السعودية للتعدين

This document and the information contained herein is Ma'aden proprietary know-how. This document or any part thereof should not be reproduced, stored in a retrieval system or transmitted by any means, electronic or otherwise, or divulged without prior written permission of Ma'aden.

LARSEN & TOUBRO DRAWING NUMBER: 019045_100_C_G_24068_003 | REVISION: 5
OUTOTEC DRAWING NUMBER: 900707__GAU01__ZC01__MTL01__31275 | DOCUMENT ID: OU100675150 | REVISION: 5

DRAWN	MGH	29/02/2020
CHECKED	SBY	05/03/2020
ENGINEER	RPK	04/03/2020
APPROVED	AG	07/03/2020
EMPLOYER		
SCALE	1:100,1:75,1:50,1:25,1:20,1:10	A0

MANSOURAH - MASSARAH GOLD PROJECT
GENERAL ARRANGEMENT DRAWING
SCREEN BUILDING
SECTION & DETAILS

DRAWING NUMBER: MD-216-3120-EG-CV-GAD-1008 | REV: D01