
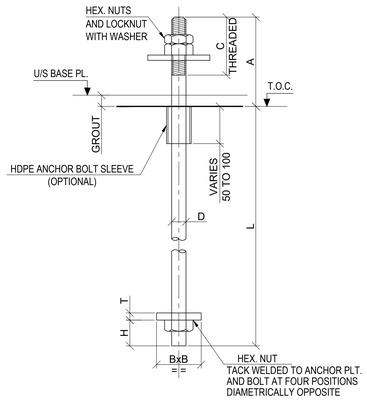


TYP. DETAIL OF BOLT

(SCALE-1:20)


SCHEDULE OF BOLTS						
D BOLT DIA. (MM)	BxB BOTTOM PLATE (SQUARE) SQ MM	DIMENSIONS (MM)				
		L	A	C	T	H
20	60x60	450	160	110	10	30

SCHEDULE OF BEAM			
BEAM MKD.	SIZE		LEVEL
	WIDTH (mm.)	DEPTH (mm.)	
TB1	300	500	RL. 912.500 (T.O.B.)

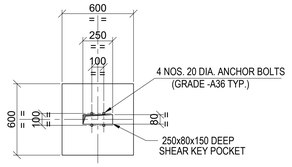


DETAIL OF PEDESTAL MKD. P1

(SCALE-1:25)

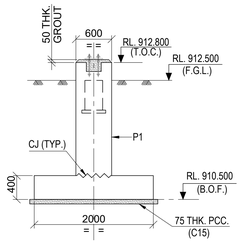


SECTION 1-1

(SCALE-1:40)

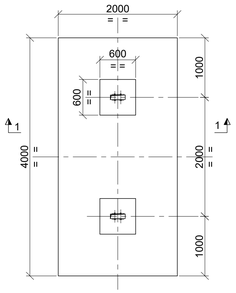


DETAIL OF FOUNDATION MKD. CF1


(SCALE-1:50)

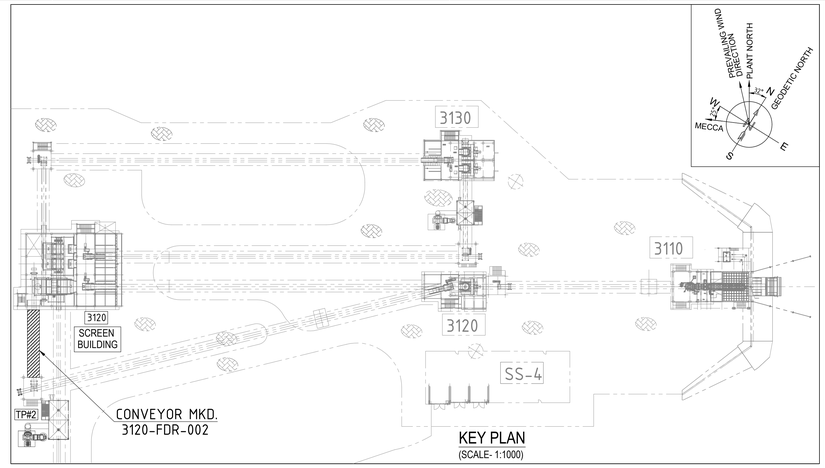

KEY PLAN

(SCALE- 1:1000)

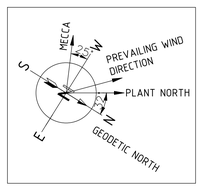

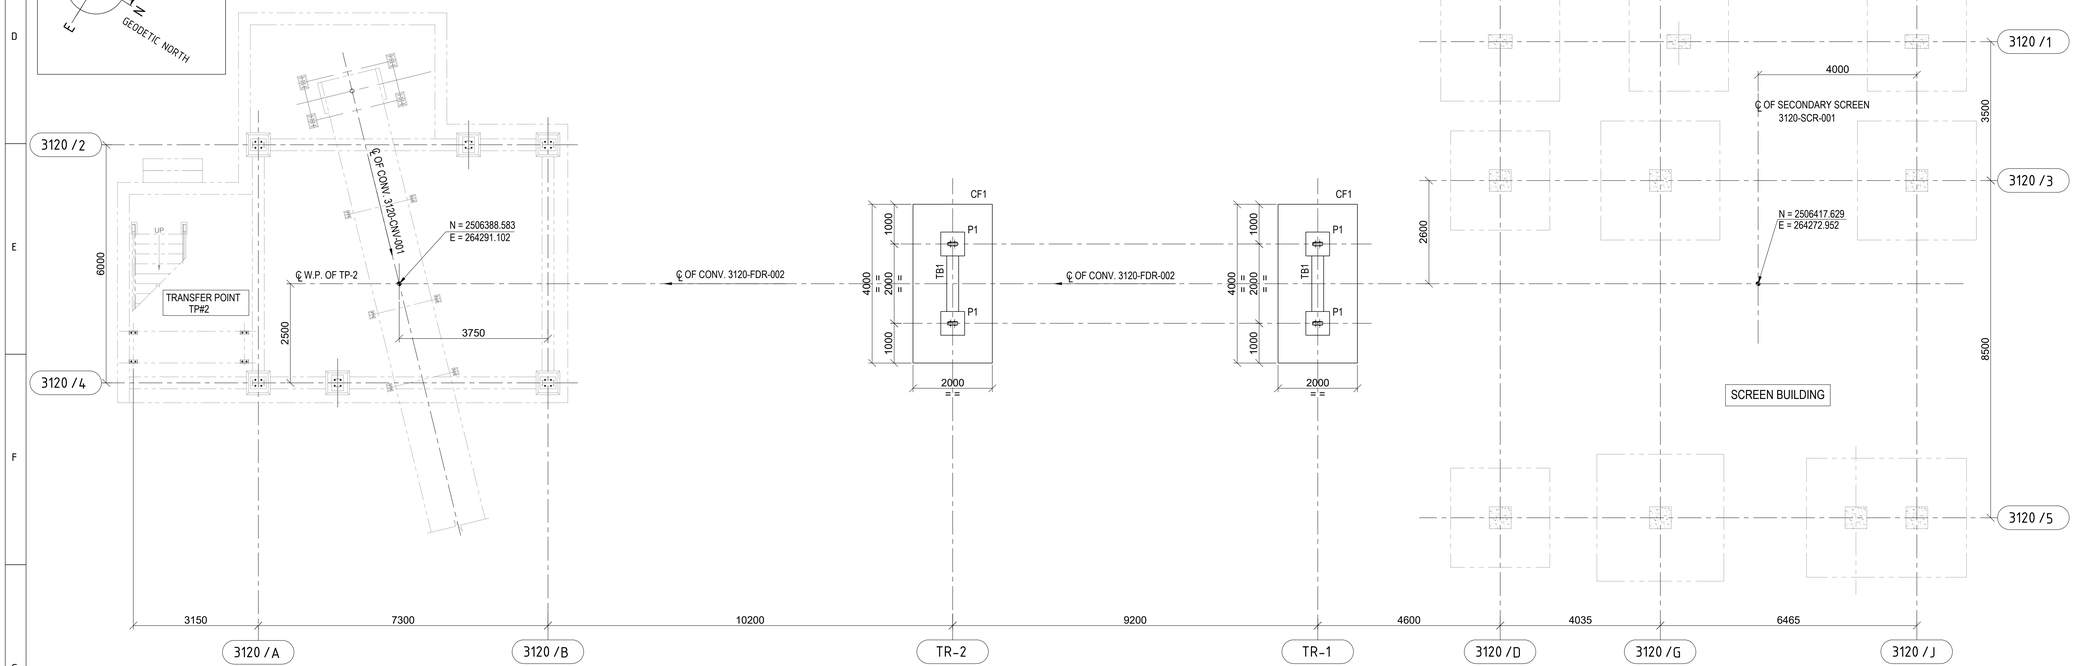

LAYOUT OF FOUNDATION AND TIE BEAM FOR CONVEYOR MKD. 3120-FDR-002

(SCALE-1:75)

LEGENDS :-

R.L. - REDUCED LEVEL
℄ - CENTRE LINE
CJ - CONSTRUCTION JOINT
FDN. - FOUNDATION.
T.O.C. - TOP OF CONCRETE.
F.G.L. - FINISHED GROUND LEVEL.
F.F.L. - FINISHED FLOOR LEVEL.
B.O.F. - BOTTOM OF FOUNDATION
TYP. - TYPICAL.
B.O.B. - BOTTOM OF BEAM.
B.O.M. - BOTTOM OF MONORAIL.
R.C.C - REINFORCED CEMENT CONCRETE
P.C.C - PLAIN CEMENT CONCRETE
IP. - INSERT PLATE
MKD. - MARKED.
THK. - THICK

NOTES :-

1. ALL DIMENSIONS ARE IN MILLIMETRES AND LEVELS AND CO-ORDINATES ARE IN METRES. UNLESS OTHERWISE STATED.
2. GRADE OF CONCRETE SHALL BE C35 FOR FOUNDATION.
3. GRADE OF REINFORCEMENT SHALL BE DEFORMED BAR ASTM A615 - GRADE 60 (fy = 420 MPa).
4. NET SAFE BEARING CAPACITY OF SOIL AT BOTTOM OF FOUNDATION CONSIDERED 500KN/ SQ. M.
5. CLEAR COVER TO MAIN REINFORCEMENT SHALL BE AS
   a) FOUNDATION = 75 mm (BOTTOM & SIDE) 50 mm. (TOP)
   b) COLUMN & PEDESTAL = 50mm
   c) BEAM = 50mm
   d) SLAB = 40mm
6. FOR MINIMUM LAP LENGTH OF REINFORCEMENT REFER STANDARD DRAWING NO. MD-216-1000-EG-CV-DED-1001
7. THIS DRAWING IS TO BE READ IN CONJUNCTION WITH DRAWING MD-216-3120-EG-ST-GAD-1022 & MD-216-3120-EG-ST-GAD-1023
8. ALL STRUCTURAL WORK SHALL CONFORM TO CIVIL STRUCTURAL DESIGN CRITERIA NO. MD - 216 - 1000 -EG -ST - CRT - 1001

DOCUMENT NUMBER	REFERENCE DOCUMENTS	REV	DATE	REVISION DESCRIPTION	DRN	CHK	ENG	APP	EMP
		D01	10/03/2023	AS-BUILT	HSK	SBY	APR	PRI	
MD-216-3120-EG-ME-ELV-1005	FEEDER 3120-FDR-002 - ELEVATION	C01	26/05/2020	ISSUED FOR CONSTRUCTION	HSK	SBY	APR	PRI	
MD-216-3120-EG-ME-LPX-1003	FEEDER 3120-FDR-002 - PLAN VIEW	A01	16/04/2020	ISSUED FOR REFERENCE	HSK	SBY	APR	PRI	

RESERVED FOR VENDOR LOGO AND DRAWING NUMBER

LARSEN & TOUBRO

This drawing is the property of LARSEN & TOUBRO and must not be passed on to any person or body not authorized by us to receive it nor be copied or otherwise made use either in full or in part by such person or body without our prior permission in writing.

Outotec

The content of these documents are the sole property of Outotec Oyj. Any rights not expressly granted herein are reserved. Reproduction, transfer or distribution of part or all of the contents in any form without prior written permission of Outotec is prohibited.

MA'ADEN معادن
Saudi Arabian Mining Company شركة معادن العربية السعودية

This document and the information contained herein is Ma'aden proprietary know-how. This document or any part thereof should not be reproduced, stored in a retrieval system or transmitted by any means, electronic or otherwise, or divulged without prior written permission of Ma'aden.

LARSEN & TOUBRO DRAWING NUMBER		REVISION
019045_100_C_G_24056_008		2
OUTOTEC DRAWING NUMBER	DOCUMENT ID	REVISION
900707__GAU01__US01__MTL01__32130	OU100680970	2

DRAWN	HSK	14/04/2020
CHECKED	SBY	15/04/2020
ENGINEER	APR	13/04/2020
APPROVED	PRI	16/04/2020
EMPLOYER		
SCALE	1:100,20,25	A1

MANSOURAH - MASSARAH GOLD PROJECT
GENERAL ARRANGEMENT DRAWING
GA OF CONVEYOR -3120- FDR-002
LAYOUT & DETAIL

DRAWING NUMBER: MD - 216 - 3120 - EG - CV - GAD - 1009 REV: D01