


DRAWING NUMBER MD-216-3360-EG-CV-DED-1230 REV D01

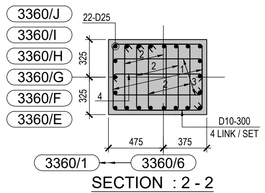

SECTION : 2 - 2
R.C. DETAIL COLUMN MKD. C1
SCALE 1:25

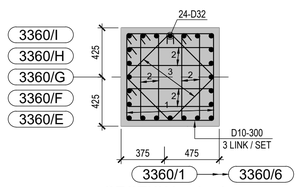

SECTION : 4 - 4
R.C. DETAIL COLUMN MKD. C2
SCALE 1:25

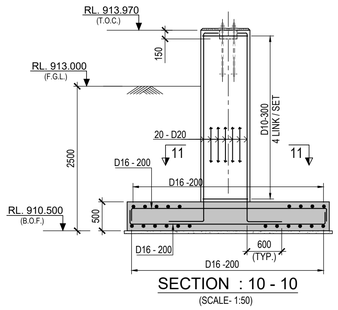


SECTION : 10 - 10
(SCALE- 1:50)




3360/5 / 3360/6

SECTION : 13 - 13
R.C. DETAIL COLUMN MKD. C7
SCALE 1:25

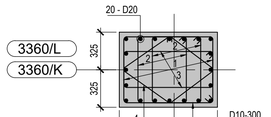


3360/1 — 3360/6

SECTION : 11 - 11
R.C. DETAIL COLUMN MKD. C6
SCALE 1:25

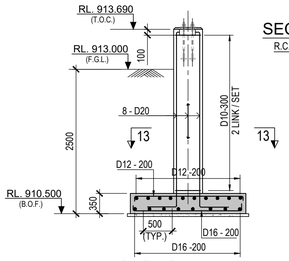


SECTION : 12 - 12
(SCALE- 1:50)

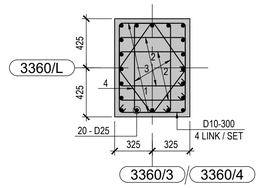


3360/3 / 3360/4

SECTION : 8A - 8A
SCALE 1:25

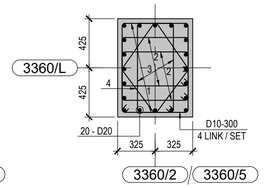


3360/2 / 3360/5

SECTION : 8 - 8
SCALE 1:25

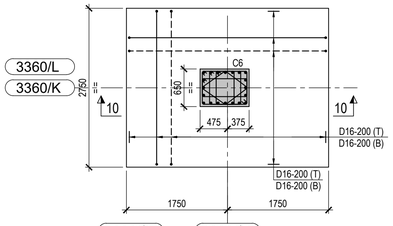


3360/1 — 3360/6

DETAIL OF FOUNDATION MKD. F6
(2 NOS. REQUIRED)
(SCALE- 1:50)

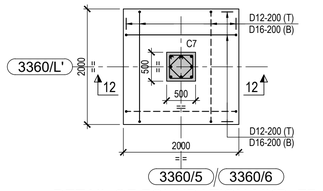


3360/5 / 3360/6

DETAIL OF FOUNDATION MKD. F7
(2 NOS. REQUIRED)
(SCALE- 1:50)

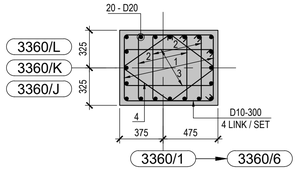


3360/1 — 3360/6


SECTION : 6 - 6
R.C. DETAIL COLUMN MKD. C3
SCALE 1:25

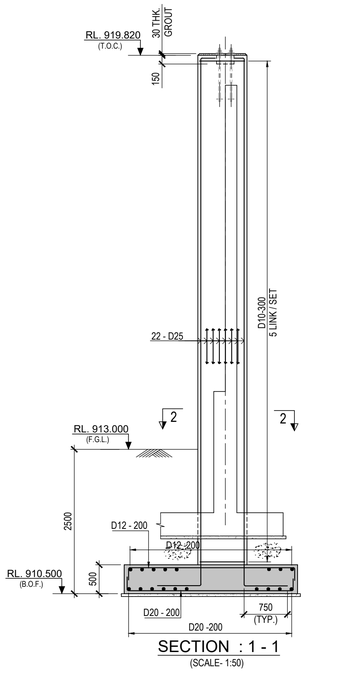


SECTION : 1 - 1
(SCALE- 1:50)

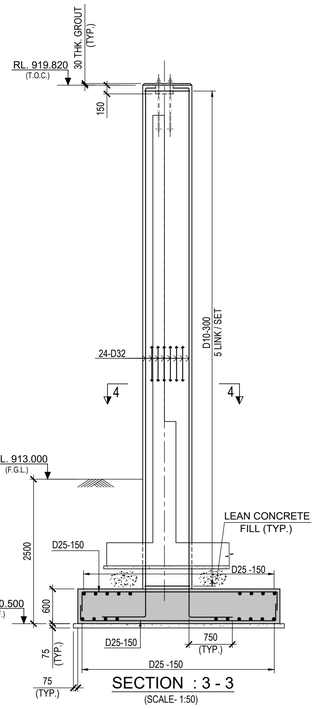


SECTION : 3 - 3
(SCALE- 1:50)

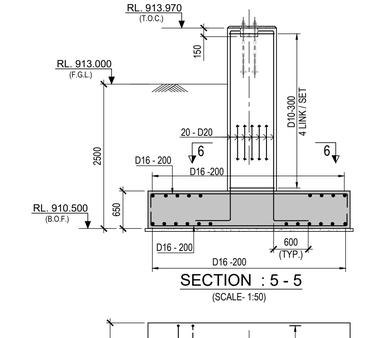


SECTION : 5 - 5
(SCALE- 1:50)

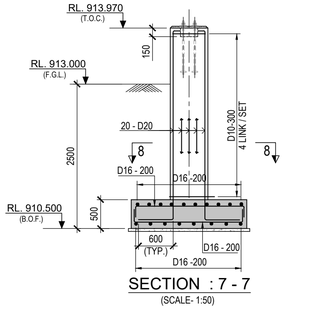

SECTION : 7 - 7
(SCALE- 1:50)

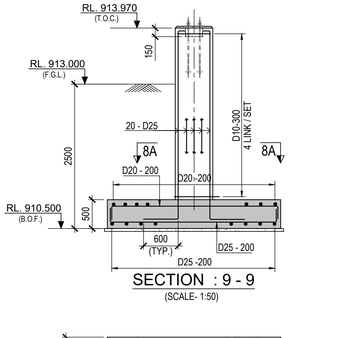


SECTION : 9 - 9
(SCALE- 1:50)

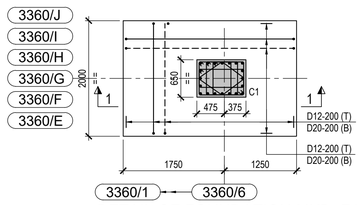


3360/1 — 3360/6

DETAIL OF FOUNDATION MKD. F1
(6 NOS. REQUIRED)
(SCALE- 1:50)

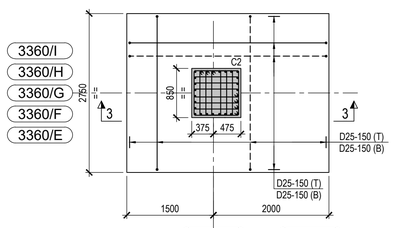


3360/1 — 3360/6

DETAIL OF FOUNDATION MKD. F2
(5 NOS. REQUIRED)
(SCALE- 1:50)

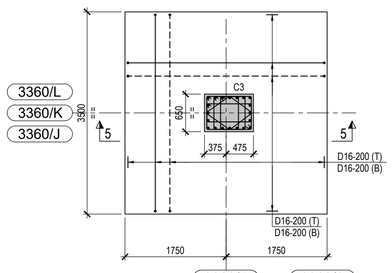


3360/1 — 3360/6

DETAIL OF FOUNDATION MKD. F3
(3 NOS. REQUIRED)
(SCALE- 1:50)

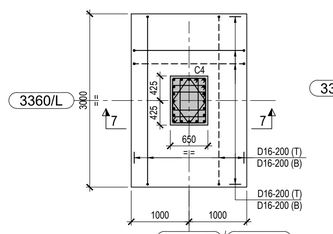

3360/2 / 3360/5

DETAIL OF FOUNDATION MKD. F4
(2 NOS. REQUIRED)
(SCALE- 1:50)

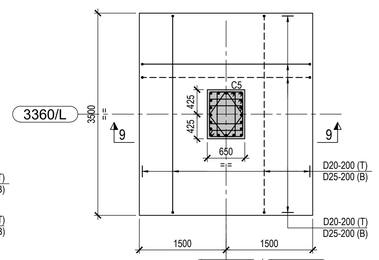

3360/3 / 3360/4

DETAIL OF FOUNDATION MKD. F5
(2 NOS. REQUIRED)
(SCALE- 1:50)

LEGEND :-

R.L. - REDUCED LEVEL
T.O.C. - TOP OF CONCRETE.
F.G.L. - FINISHED GROUND LEVEL.
F.F.L. - FINISHED FLOOR LEVEL.
B.O.F. - BOTTOM OF FOUNDATION
TYP. - TYPICAL.
P.C.C - PLAIN CEMENT CONCRETE
MKD. - MARKED.
R.C. - REINFORCED CONCRETE.

NOTES :-

1. ALL DIMENSIONS ARE IN MILLIMETERS AND LEVELS AND CO-ORDINATES ARE IN METERS. UNLESS OTHERWISE STATED.
2. THIS DRAWING SHALL BE READ IN CONJUNCTION WITH DRG. NO. MD-216-3360-EG-CV-GAD-1229.
3. ALL OTHER NOTES REFER DRAWING NO. MD-101-SMEM-EG-ST-DST-0001 TO 0008.
4. GENERAL NOTES FOR CIVIL WORKS & STANDARD REINFORCEMENT DETAIL REFER DRAWING NO. MD-216-1000-EG-CV-DED-1001 & 1005.

DOCUMENT NUMBER	REFERENCE DOCUMENTS	REV	DATE	REVISION DESCRIPTION	DRN	CHK	ENG	APP	EMP
		D01	15/03/2023	AS-BUILT	PDK	SGC	SHD	PRI	
		C02	19/08/2020	ISSUED FOR CONSTRUCTION & REVISED AS MKD. C02	PDK	SGC	SHD	PRI	
		C01	27/04/2020	ISSUED FOR CONSTRUCTION & REVISED AS PER EMPLOYER	PDK	SGC	SHD	PRI	
MD-216-1000-EG-ST-CRT-1001	CIVIL, STRUCTURAL AND ARCHITECTURAL DESIGN CRITERIA			COMMENTS ON DATED 25/04/2020 & REVISED AS MKD. C01					
MD-216-3360-EG-ST-GAD-2223	CONCRETE STORAGE AND REPULP-PLAN,ELEVATION & DETAILS	A02	03/04/2020	REVISED AS PER EMPLOYER COMMENTS	PDK	SGC	SHD	PRI	
MD-216-3360-EG-ST-GAD-2222	CONCRETE STORAGE AND REPULP-PLAN,ELEVATION & DETAILS			ON DATED 20/03/2020 & REVISED AS MKD. A02					
MD-216-3360-EG-ST-GAD-2215	CONCRETE STORAGE AND REPULP-PLAN,ELEVATION & DETAILS	A01	28/01/2020	ISSUED FOR APPROVAL	MD	SGC	SHD	PRI	

RESERVED FOR VENDOR LOGO AND DRAWING NUMBER

LARSEN & TOUBRO

This drawing is the property of LARSEN & TOUBRO and must not be passed on to any person or body not authorized by us to receive it nor be copied or otherwise made use either in full or in part by such person or body without our prior permission in writing.

Outotec

The content of these documents are the sole property of Outotec Oyj. Any rights not expressly granted herein are reserved. Reproduction, transfer or distribution of part or all of the contents in any form without prior written permission of Outotec is prohibited.

MA'ADEN معادن
Saudi Arabian Mining Company شركة معادن العربية السعودية

This document and the information contained herein is Ma'aden proprietary know-how. This document or any part thereof should not be reproduced, stored in a retrieval system or transmitted by any means, electronic or otherwise, or divulged without prior written permission of Ma'aden.

LARSEN & TOUBRO DRAWING NUMBER: 019045_450_C_D_24099_001 — REVISION: 4
OUTOTEC DRAWING NUMBER: 900707__GAU01__US02__CTB13__36000 — DOCUMENT ID: 0U100666583 — REVISION: 4

DRAWN	MD	07/01/2020
CHECKED	SGC	16/01/2020
ENGINEER	SHD	03/01/2020
APPROVED	PRI	28/01/2020
EMPLOYER		
SCALE 1:50		A1

MANSOURAH - MASSARAH GOLD PROJECT
DETAIL DRAWING
CONCENTRATE STORAGE AND REPULP
R.C. DETAIL OF STORAGE BUILDING FOUNDATION

DRAWING NUMBER: MD-216-3360-EG-CV-DED-1230 — REV: D01