


DRAWING NUMBER: MD-216-3360-EG-CV-DED-1231 REV: D01

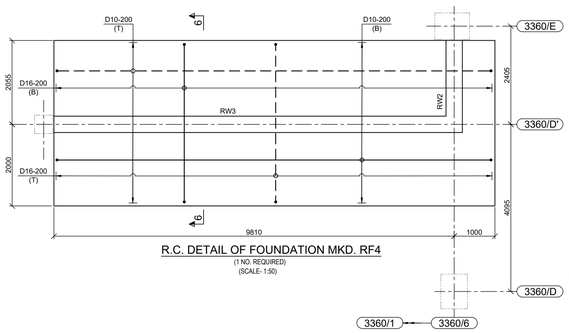


R.C. DETAIL OF FOUNDATION MKD. RF4
(1 NO. REQUIRED)
(SCALE- 1:50)

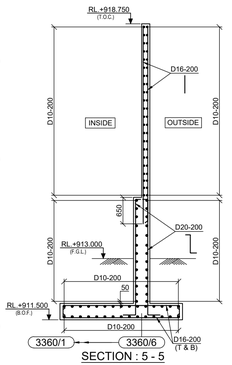


SECTION : 5 - 5
(SCALE- 1:50)

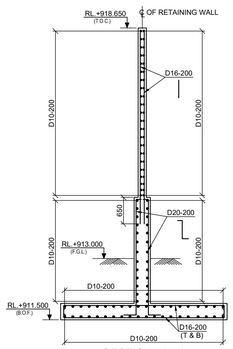


SECTION : 6 - 6
(SCALE- 1:50)

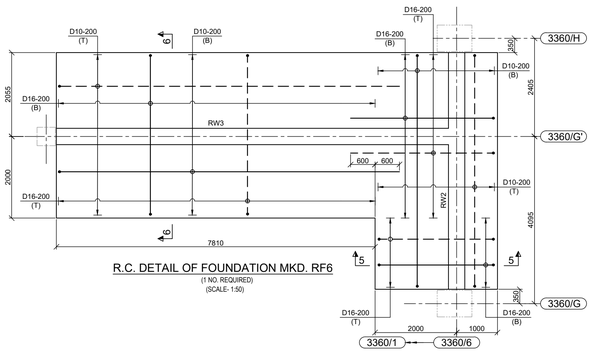


R.C. DETAIL OF FOUNDATION MKD. RF6
(1 NO. REQUIRED)
(SCALE- 1:50)

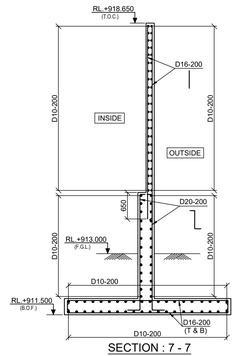


SECTION : 7 - 7
(SCALE- 1:50)

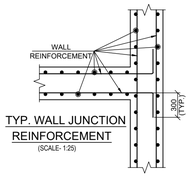


TYP. WALL JUNCTION REINFORCEMENT
(SCALE- 1:25)

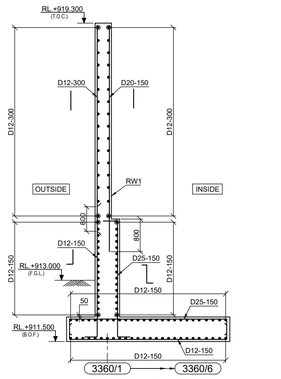


SECTION : 1 - 1
(SCALE- 1:50)

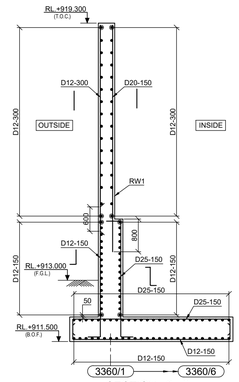


SECTION : 2 - 2
(SCALE- 1:50)

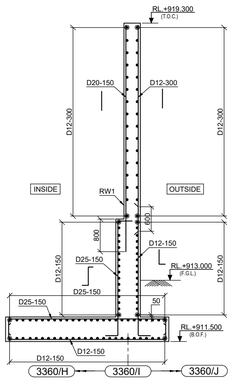


SECTION : 3 - 3
(SCALE- 1:50)

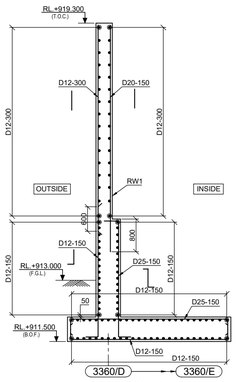


SECTION : 4 - 4
(SCALE- 1:50)

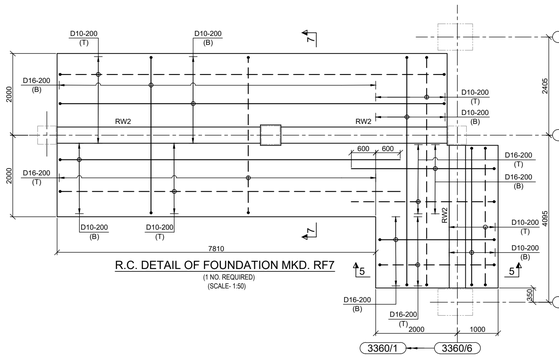


R.C. DETAIL OF FOUNDATION MKD. RF7
(1 NO. REQUIRED)
(SCALE- 1:50)

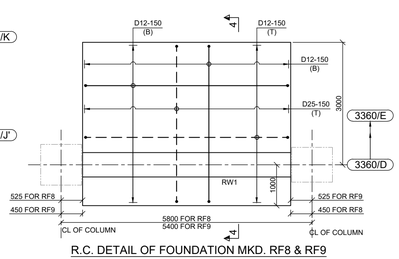


R.C. DETAIL OF FOUNDATION MKD. RF8 & RF9
(2 NOS. REQUIRED)
(SCALE- 1:50)

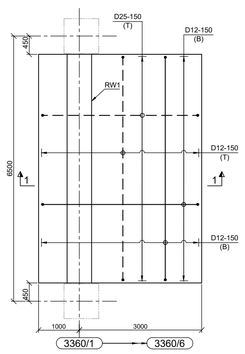


R.C. DETAIL OF FOUNDATION MKD. RF1
(3 NOS. REQUIRED)
(SCALE- 1:50)

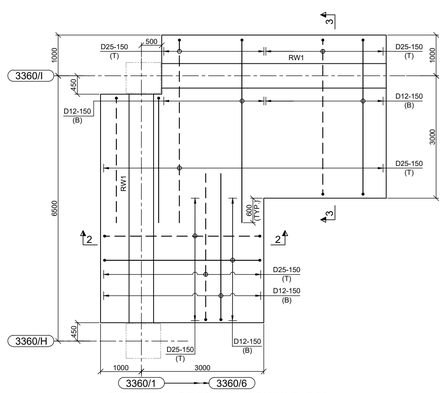

R.C. DETAIL OF FOUNDATION MKD. RF2
(1 NO. REQUIRED)
(SCALE- 1:50)

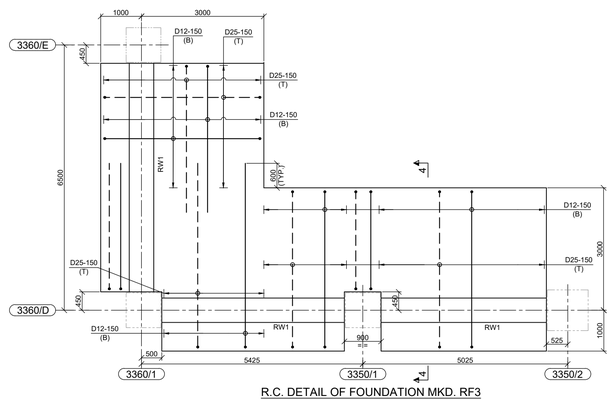

R.C. DETAIL OF FOUNDATION MKD. RF3
(1 NO. REQUIRED)
(SCALE- 1:50)

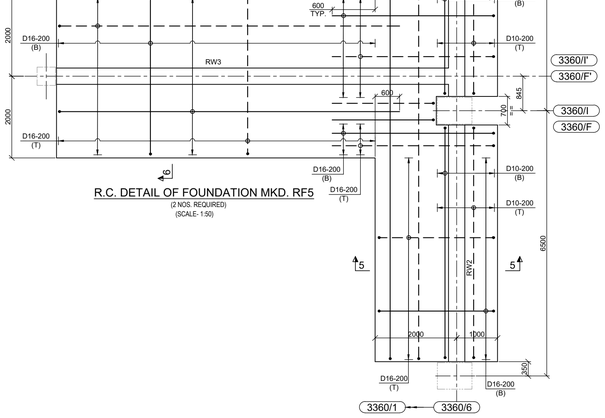

R.C. DETAIL OF FOUNDATION MKD. RF5
(2 NOS. REQUIRED)
(SCALE- 1:50)

LEGEND :-

RL - REDUCED LEVEL.
T.O.C. - TOP OF CONCRETE.
F.G.L. - FINISHED GROUND LEVEL.
B.O.F. - BOTTOM OF FOOTING
TYP. - TYPICAL.
B/W - BOTHWAYS.
R.C. - REINFORCED CONCRETE..
T - TOP.
B - BOTTOM.
- - - - - - - TOP REINFORCEMENT.
——— BOTTOM REINFORCEMENT.

NOTES :-

1. ALL DIMENSIONS ARE IN MILLIMETERS AND LEVELS AND CO-ORDINATES ARE IN METERS. UNLESS OTHERWISE STATED.
2. THIS DRAWING SHALL BE READ IN CONJUNCTION WITH DRG. NO. MD-216-3360-EG-CV-GAD-1230.
3. ALL OTHER NOTES REFER DRAWING NO. MD-101-SMEM-EG-ST-DST-0001 TO 0008.

DOCUMENT NUMBER	REFERENCE DOCUMENTS	REV	DATE	REVISION DESCRIPTION	DRN	CHK	ENG	APP	EMP
MD-216-1000-EG-ST-CRT-1001	CIVIL, STRUCTURAL AND ARCHITECTURAL DESIGN CRITERIA	D01	15/03/2023	AS-BUILT	PDK	SGC	SHD	PRI	
MD-216-3360-EG-ST-GAD-2223	CONCENTRATE STORAGE & REPULP PLAN, ELEVATION & DET.	C02	04/05/2020	ISSUED FOR CONSTRUCTION & REVISED AS MKD. C02	PDK	SGC	SHD	PRI	
MD-216-3360-EG-ST-GAD-2222	CONCENTRATE STORAGE & REPULP PLAN, ELEVATION & DET.	C01	02/04/2020	ISSUED FOR CONSTRUCTION & REVISED AS MKD. C01	PDK	SGC	SHD	PRI	
MD-216-3360-EG-ST-GAD-2275	CONCENTRATE STORAGE & REPULP PLAN, ELEVATION & DET.	A01	28/01/2020	ISSUED FOR REFERENCE	PDK	SGC	SHD	PRI	

DOCUMENT NUMBER	REFERENCE DOCUMENTS	REV	DATE	REVISION DESCRIPTION	DRN	CHK	ENG	APP	EMP

RESERVED FOR VENDOR LOGO AND DRAWING NUMBER

LARSEN & TOUBRO
This drawing is the property of LARSEN & TOUBRO and must not be passed on to any person or body not authorized by us to receive it nor be copied or otherwise made use either in full or in part by such person or body without our prior permission in writing.

Outotec
The content of these documents are the sole property of Outotec Oyj. Any rights not expressly granted herein are reserved. Reproduction, transfer or distribution of part or all of the contents in any form without prior written permission of Outotec is prohibited.

MA'ADEN معادن Saudi Arabian Mining Company شركة معادن السعودية
This document and the information contained herein is Ma'aden proprietary know-how. This document or any part thereof should not be reproduced, stored in a retrieval system or transmitted by any means, electronic or otherwise, or divulged without prior written permission of Ma'aden.

LARSEN & TOUBRO DRAWING NUMBER	019045_450_C_D_24099_002		REVISION 3
OUTOTEC DRAWING NUMBER	900707__GAU01__US02_CTB17__33601	DOCUMENT ID OU100670790	REVISION 3
DRAWN	PDK	08/01/2020	MANSOURAH - MASSARAH GOLD PROJECT
CHECKED	SGC	15/01/2020	DETAIL DRAWING
ENGINEER	SHD	04/01/2020	CONCENTRATE STORAGE AND REPULP
APPROVED	PRI	28/01/2020	R.C. DETAILS OF RETAINING WALL
EMPLOYER			
SCALE 1:100	A0		DRAWING NUMBER MD-216-3360-EG-CV-DED-1231 REV D01