


DRAWING NUMBER: MD-216-3360-EG-CV-DED-1232 | REV: D01

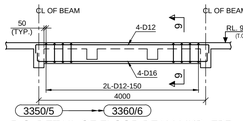


R.C. DETAIL OF FLOOR BEAM MKD. FB7
(CROSS BEAM & SLAB REIN. NOT SHOWN FOR CLARITY)
(SCALE- 1:50)

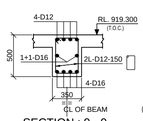


SECTION : 9 - 9
(SLAB REIN. NOT SHOWN FOR CLARITY)
(SCALE- 1:25)

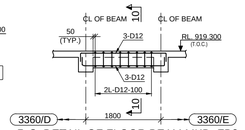


R.C. DETAIL OF FLOOR BEAM MKD. FB8
(CROSS BEAM & SLAB REIN. NOT SHOWN FOR CLARITY)
(SCALE- 1:50)

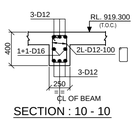


SECTION : 10 - 10
(SCALE- 1:25)

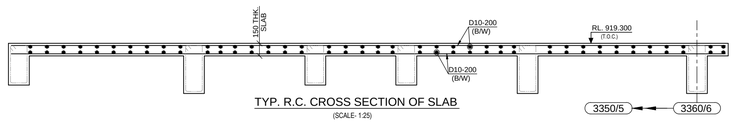


TYP. R.C. CROSS SECTION OF SLAB
(SCALE- 1:25)

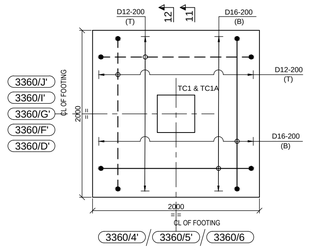


R.C. DETAIL OF FOUNDATION MKD. TF1
(7 NOS. REQUIRED)
(SCALE- 1:25)

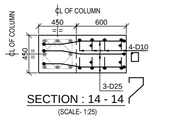


SECTION : 14 - 14
(SCALE- 1:25)

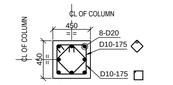

SECTION : 13 - 13
TYP. CROSS SECTION OF COLUMN MKD. TC1 & TC1A
(7 NOS. REQUIRED)
(SCALE- 1:25)

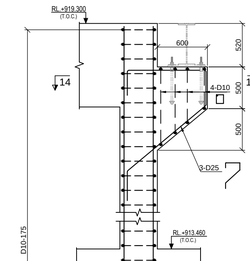


SECTION : 12 - 12
(FOR TC1A COLUMN)
(BEAM REIN. NOT SHOWN FOR CLARITY)
(SCALE- 1:25)

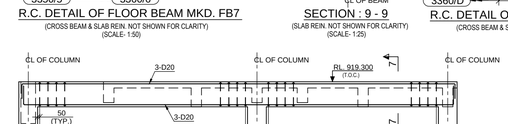


R.C. DETAIL OF FLOOR BEAM MKD. FB6 (FOR GRID 3360/J')
(CROSS BEAM & SLAB REIN. NOT SHOWN FOR CLARITY)
(SCALE- 1:50)




SECTION : 7 - 7
(SLAB REIN. NOT SHOWN FOR CLARITY)
(SCALE- 1:25)

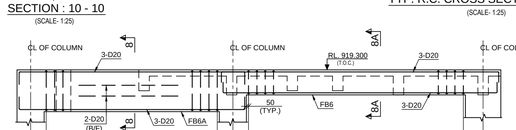


R.C. DETAIL OF FLOOR BEAM MKD. FB6A & FB6 (FOR GRID 3360/D)
(CROSS BEAM & SLAB REIN. NOT SHOWN FOR CLARITY)
(SCALE- 1:50)

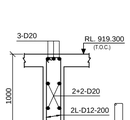


SECTION : 8 - 8
(SLAB REIN. NOT SHOWN FOR CLARITY)
(SCALE- 1:25)

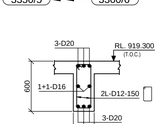


SECTION : 8A - 8A
(SLAB REIN. NOT SHOWN FOR CLARITY)
(SCALE- 1:25)

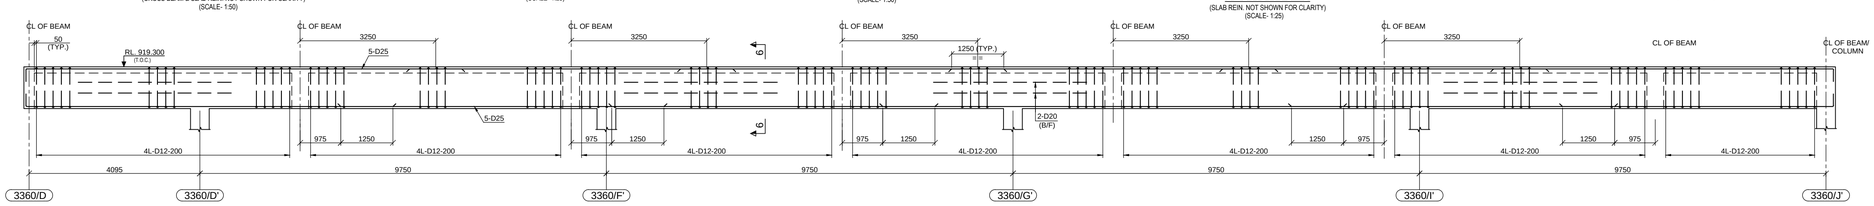


R.C. DETAIL OF FLOOR BEAM MKD. FB5
(CROSS BEAM & SLAB REIN. NOT SHOWN FOR CLARITY)
(SCALE- 1:50)

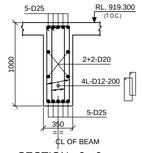


SECTION : 6 - 6
(SLAB REIN. NOT SHOWN FOR CLARITY)
(SCALE- 1:25)

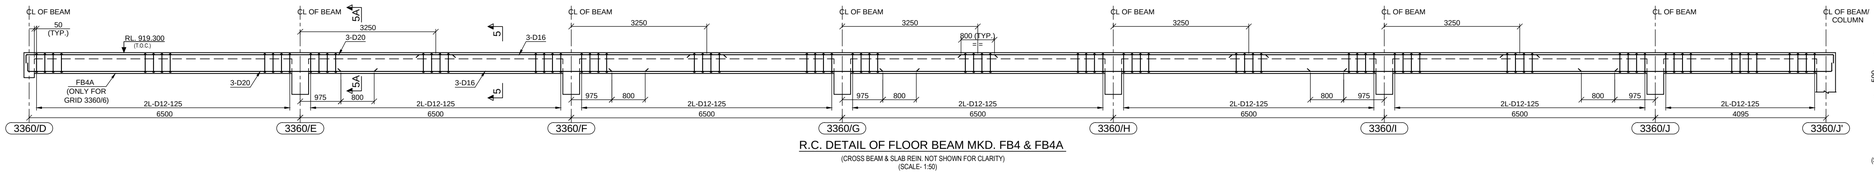


R.C. DETAIL OF FLOOR BEAM MKD. FB4 & FB4A
(CROSS BEAM & SLAB REIN. NOT SHOWN FOR CLARITY)
(SCALE- 1:50)

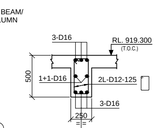


SECTION : 5 - 5
(SLAB REIN. NOT SHOWN FOR CLARITY)
(SCALE- 1:25)

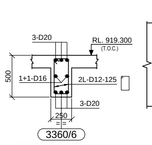


SECTION : 5A - 5A
(BETWEEN GRID 3360/D & 3360/E)
(SCALE- 1:25)

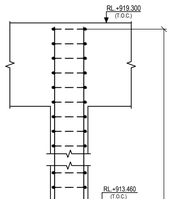


SECTION : 11 - 11
(FOR TC1 COLUMN)
(BEAM REIN. NOT SHOWN FOR CLARITY)
(SCALE- 1:25)

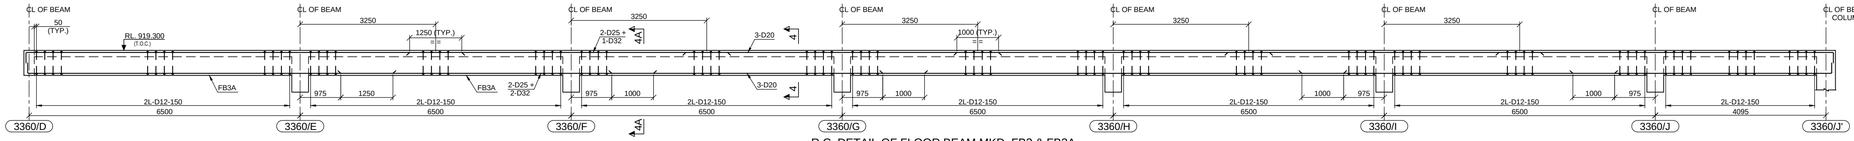


R.C. DETAIL OF FLOOR BEAM MKD. FB3 & FB3A
(CROSS BEAM & SLAB REIN. NOT SHOWN FOR CLARITY)
(SCALE- 1:50)

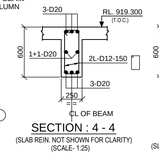


SECTION : 4 - 4
(SLAB REIN. NOT SHOWN FOR CLARITY)
(SCALE- 1:25)

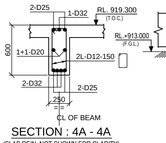


SECTION : 4A - 4A
(SLAB REIN. NOT SHOWN FOR CLARITY)
(SCALE- 1:25)

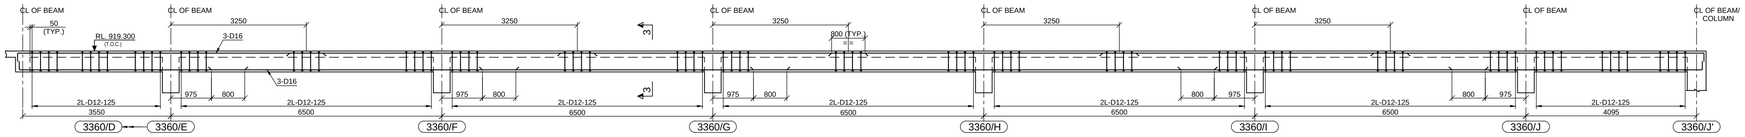


R.C. DETAIL OF FLOOR BEAM MKD. FB2
(CROSS BEAM & SLAB REIN. NOT SHOWN FOR CLARITY)
(SCALE- 1:50)

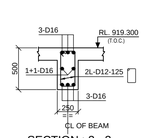


SECTION : 3 - 3
(SLAB REIN. NOT SHOWN FOR CLARITY)
(SCALE- 1:25)

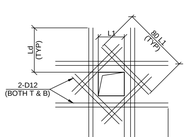


EXTRA REINF. AROUND OPENING IN SLAB
(SCALE- 1:25)

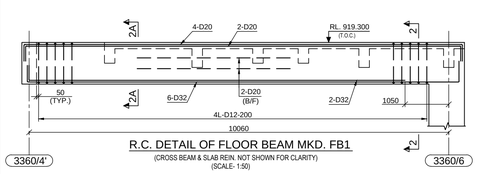


R.C. DETAIL OF FLOOR BEAM MKD. FB1
(CROSS BEAM & SLAB REIN. NOT SHOWN FOR CLARITY)
(SCALE- 1:50)

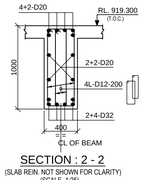


SECTION : 2 - 2
(SLAB REIN. NOT SHOWN FOR CLARITY)
(SCALE- 1:25)

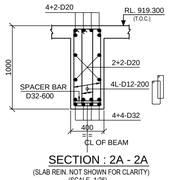


SECTION : 2A - 2A
(SLAB REIN. NOT SHOWN FOR CLARITY)
(SCALE- 1:25)

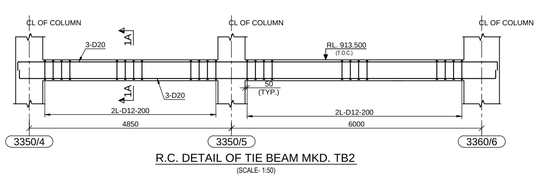


R.C. DETAIL OF TIE BEAM MKD. TB2
(SCALE- 1:50)

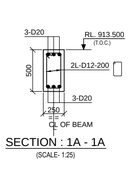

SECTION : 1A - 1A
(SCALE- 1:25)

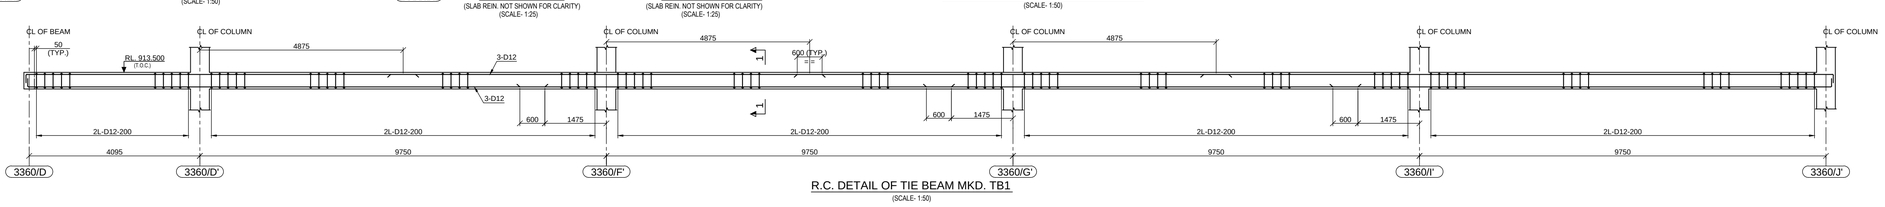

R.C. DETAIL OF TIE BEAM MKD. TB1
(SCALE- 1:50)

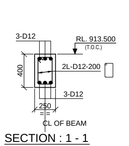

SECTION : 1 - 1
(SCALE- 1:25)

LEGEND :-

RL - REDUCED LEVEL.
CL - CENTRE LINE.
T.O.C. - TOP OF CONCRETE.
F.G.L. - FINISHED GROUND LEVEL.
B.O.F. - BOTTOM OF FOOTING
TYP. - TYPICAL.
B/W - BOTHWAYS.
B/F - BOTHFACE.
MKD. - MARKED.
R.C. - REINFORCED CONCRETE..
DET. - DETAIL.
REIN. - REINFORCEMENT.
T - TOP.
B - BOTTOM.
- - - - TOP REINFORCEMENT.
—— BOTTOM REINFORCEMENT.

NOTES :-

1. ALL DIMENSIONS ARE IN MILLIMETRE AND LEVELS AND CO-ORDINATES ARE IN METRE. UNLESS OTHERWISE STATED.
3. THIS DRAWING SHALL BE READ IN CONJUNCTION WITH DRAWING NO. MD-216-3360-EG-CV-GAD-1231.
3. ALL OTHER NOTES & DETAILS REFER DRAWING NO. MD-101-SMEM-EG-ST-DST-0001 TO 0008.

DOCUMENT NUMBER	REFERENCE DOCUMENTS	REV	DATE	REVISION DESCRIPTION	DRN	CHK	ENG	APP	EMP
MD-216-1000-EG-CV-DED-1003	ANCHOR BOLTS STANDARD DETAILS								
MD-216-1000-EG-ST-CRT-1001	CIVIL, STRUCTURAL AND ARCHITECTURAL DESIGN CRITERIA	D01	15/03/2023	AS-BUILT	PDK	SGC	SHD	PRI	
MD-216-3360-EG-ST-GAD-2223	CONCENTRATE STORAGE & REPULP PLAN, ELEVATION & DET.	C02	20/11/2020	ISSUED FOR CONSTRUCTION & REVISED AS MKD. (2)	PDK	SGC	SHD	PRI	
MD-216-3360-EG-ST-GAD-2222	CONCENTRATE STORAGE & REPULP PLAN, ELEVATION & DET.	C01	02/04/2020	ISSUED FOR CONSTRUCTION & REVISED AS MKD. (1)	PDK	SGC	SHD	PRI	
MD-216-3360-EG-ST-GAD-2215	CONCENTRATE STORAGE & REPULP PLAN, ELEVATION & DET.	A01	28/01/2020	ISSUED FOR REFERENCE	PDK	SGC	SHD	PRI	

RESERVED FOR VENDOR LOGO AND DRAWING NUMBER

LARSEN & TOUBRO

This drawing is the property of LARSEN & TOUBRO and must not be passed on to any person or body not authorised by us to receive it nor be copied or otherwise made use either in full or in part by such person or body without our prior permission in writing.

Outotec

The content of these documents are the sole property of Outotec Oyj. Any rights not expressly granted herein are reserved. Reproduction, transfer or distribution of part or all of the contents in any form without prior written permission of Outotec is prohibited.

MA'ADEN معادن Saudi Arabian Mining Company

This document and the information contained herein is Ma'aden proprietary know-how. This document or any part thereof should not be reproduced, stored in a retrieval system or transmitted by any means, electronic or otherwise, or divulged without prior written permission of Ma'aden.

LARSEN & TOUBRO DRAWING NUMBER			REVISION
019045_450_C_D_24099_003			3
OUTOTEC DRAWING NUMBER		DOCUMENT ID	REVISION
900707__GAU01__US02__CTB17__33602		OU100670791	3
DRAWN	PDK	10/01/2020	MANSOURAH - MASSARAH GOLD PROJECT
CHECKED	SGC	17/01/2020	DETAIL DRAWING
ENGINEER	SHD	07/01/2020	CONCENTRATE STORAGE AND REPULP
APPROVED	PRI	28/01/2020	R.C. DET. OF BEAM FOR TRIPPER SUPPORTING STR.
EMPLOYER			DRAWING NUMBER: MD-216-3360-EG-CV-DED-1232 — REV: D01
SCALE: 1:100		AO	