


DRAWING NUMBER MD-216-3360-EG-CV-DED-1233 REV D01

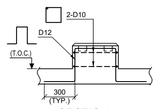


SECTION : 7 - 7
(SCALE - 1 : 20)

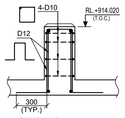


SECTION : 8 - 8
(SCALE - 1 : 20)

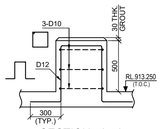


SECTION : 9 - 9
(SCALE - 1 : 20)

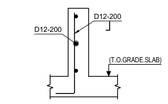


TYP. DETAIL OF BUND WALL
(FOR 100 THK. & 150 THK. BUND WALL)
(SCALE - 1 : 15)

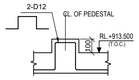


SECTION : 11 - 11
(SCALE - 1 : 15)

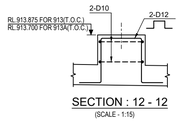


SECTION : 12 - 12
(SCALE - 1:15)

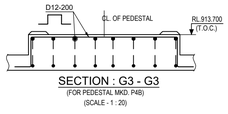


SECTION : G3 - G3
(FOR PEDESTAL MKD. P4B)
(SCALE - 1 : 20)

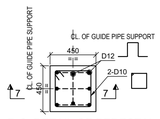


R.C. DETAIL OF PEDESTAL
MKD. P6 & P6A
(SCALE - 1:20)

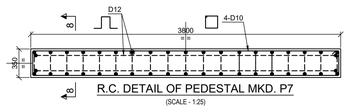


R.C. DETAIL OF PEDESTAL MKD. P7
(SCALE - 1:25)

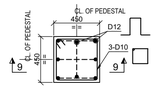


R.C. DETAIL OF PEDESTAL
MKD. P8
(SCALE - 1:20)

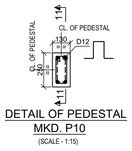


DETAIL OF PEDESTAL
MKD. P10
(SCALE - 1:15)

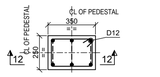


DETAIL OF PEDESTAL
MKD. P13 & P13A
(SCALE - 1:15)

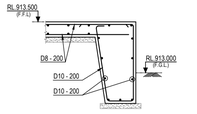


DETAIL - F
(SHOWING RC DETAIL)
(SCALE 1:20)

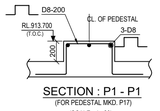


SECTION : P1 - P1
(FOR PEDESTAL MKD. P17)
(SCALE - 1 : 20)

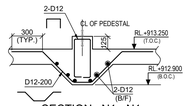


SECTION : N1 - N1
(SHOWING R.C. DETAIL ONLY)
(FOR PEDESTAL MKD. P16)
(SCALE - 1 : 20)

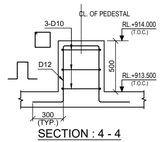


SECTION : 4 - 4
(SCALE - 1 : 20)

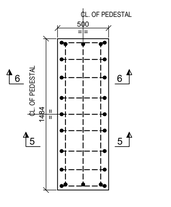


R.C. DETAIL OF PEDESTAL
MKD. P4 & P4A
(SCALE - 1:20)

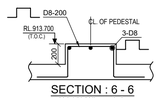


SECTION : 6 - 6
(FOR PEDESTAL MKD. P4A)
(SCALE - 1 : 20)

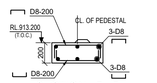


SECTION : 5 - 5
(FOR PEDESTAL MKD. P4)
(SCALE - 1 : 20)

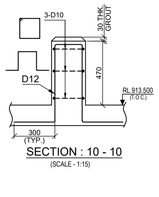


SECTION : 10 - 10
(SCALE - 1:15)

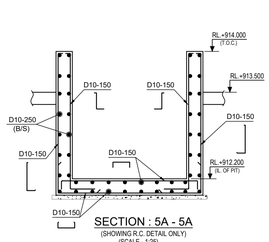


SECTION : 5A - 5A
(SHOWING R.C. DETAIL ONLY)
(SCALE - 1:25)

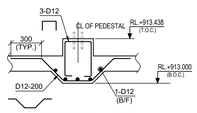


SECTION : L1 - L1
(SHOWING R.C. DETAIL ONLY)
(FOR PEDESTAL MKD. P14)
(SCALE - 1 : 20)

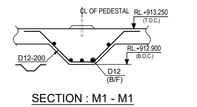


SECTION : M1 - M1
(SHOWING R.C. DETAIL ONLY)
(FOR PEDESTAL MKD. P15)
(SCALE - 1 : 20)

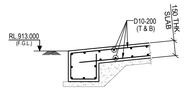


DETAIL - E
(SHOWING RC DETAIL)
(SCALE 1:20)

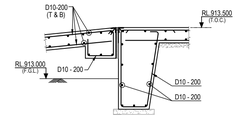


DETAIL - D
(SHOWING RC DETAIL)
(SCALE 1:20)

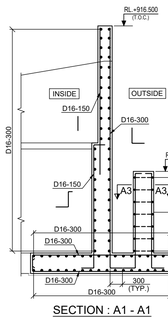

SECTION : A1 - A1
(SCALE - 1:50)

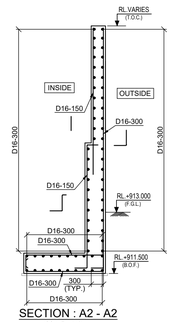


SECTION : A2 - A2
(SCALE - 1:50)

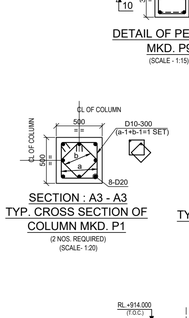


DETAIL OF PEDESTAL
MKD. P9
(SCALE - 1:15)


SECTION : A3 - A3
TYP. CROSS SECTION OF
COLUMN MKD. P1
(2 NOS. REQUIRED)
(SCALE- 1:20)

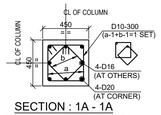


SECTION : 1A - 1A
TYP. CROSS SECTION OF
COLUMN MKD. P2
(8 NOS. REQUIRED)
(SCALE- 1:20)

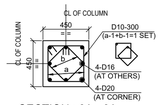

SECTION : 2A - 2A
TYP. CROSS SECTION OF
COLUMN MKD. P3 & P3A
(4 NOS. REQUIRED)
(SCALE- 1:20)

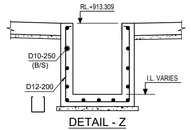


DETAIL - Z
(SHOWING R.C. DETAIL ONLY)
(SCALE - 1:25)

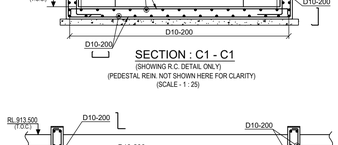


SECTION : C1 - C1
(SHOWING R.C. DETAIL ONLY)
(PEDESTAL REIN. NOT SHOWN HERE FOR CLARITY)
(SCALE - 1 : 25)


SECTION : B1 - B1
(SHOWING R.C. DETAIL ONLY)
(PEDESTAL REIN. NOT SHOWN HERE FOR CLARITY)
(SCALE - 1 : 25)

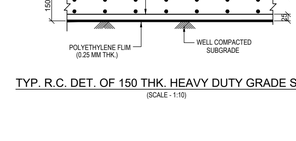


TYP. R.C. DET. OF 150 THK. HEAVY DUTY GRADE SLAB
(SCALE - 1:10)

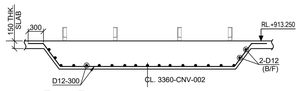


SECTION : X1 - X1
(SHOWING R.C. DETAIL ONLY)
(GRADE SLAB REIN. NOT SHOWN HERE FOR CLARITY)
(SCALE - 1:40)

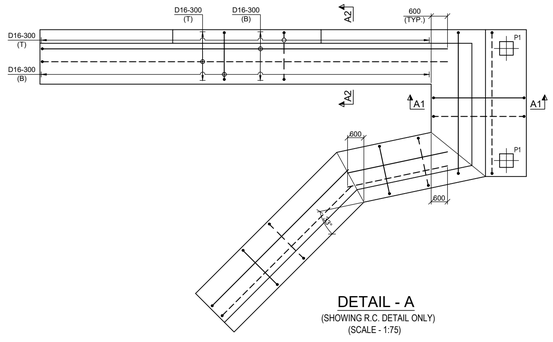


DETAIL - A
(SHOWING R.C. DETAIL ONLY)
(SCALE - 1:75)

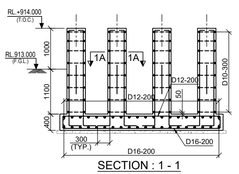


SECTION : 1 - 1
(SCALE - 1:50)

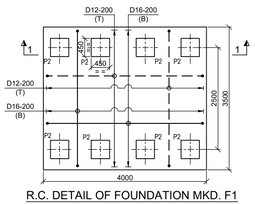


R.C. DETAIL OF FOUNDATION MKD. F1
(SCALE - 1:50)

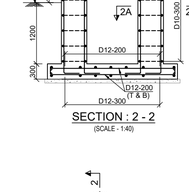


SECTION : 2 - 2
(SCALE - 1:40)

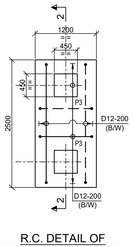


R.C. DETAIL OF
FOUNDATION MKD. F2
(SCALE - 1:40)

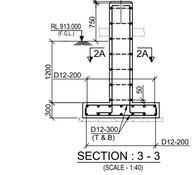


SECTION : 3 - 3
(SCALE - 1:40)

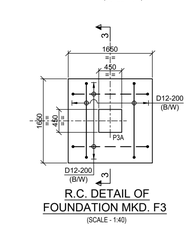


R.C. DETAIL OF
FOUNDATION MKD. F3
(SCALE - 1:40)

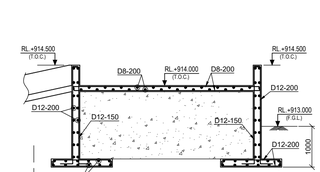

SECTION : Y1 - Y1
(SCALE - 1:50)

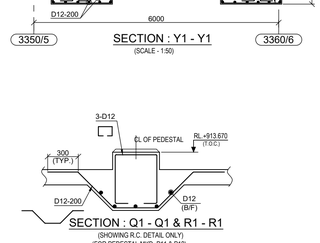

SECTION : Q1 - Q1 & R1 - R1
(SHOWING R.C. DETAIL ONLY)
(FOR PEDESTAL MKD. P11 & P12)
(SCALE - 1 : 20)

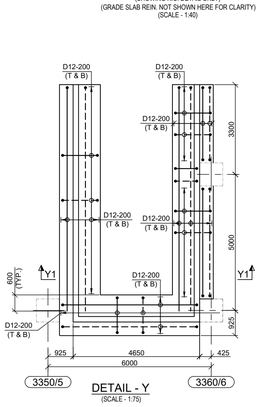

DETAIL - Y
(SCALE - 1:75)

LEGENDS :-

RL - REDUCED LEVEL.
T.O.C. - TOP OF CONCRETE.
F.G.L. - FINISHED GROUND LEVEL.
B.O.F. - BOTTOM OF FOOTING
TYP. - TYPICAL.
B/F - BOTH FACES.
B/W - BOTHWAYS.
R.C. - REINFORCED CONCRETE..
T - TOP.
B - BOTTOM.
- - - - - TOP REINFORCEMENT.
——— BOTTOM REINFORCEMENT.

NOTES :-

1. ALL DIMENSIONS ARE IN MILLIMETERS AND LEVELS AND CO-ORDINATES ARE IN METERS. UNLESS OTHERWISE STATED.
2. THIS DRAWING SHALL BE READ IN CONJUNCTION WITH DRAWING NO. MD-216-3360-EG-CV-GAD-1233.
3. ALL OTHER NOTES REFER DRAWING NO. MD-101-SMEM-EG-ST-DST-0001 TO 0008.
4. GENERAL NOTES FOR CIVIL WORKS & STANDARD REINFORCEMENT DETAIL REFER DRAWING NO. MD-216-1000-EG-CV-DED-1001 & 1005.

REV	DESCRIPTION	DATE	DRN	CHK	ENG	APP	EMP
D01	AS-BUILT	15/03/2023	PDK	SGC	SHD	PRI	
C02	ISSUED FOR CONSTRUCTION AND REVISED AS MKD. C01	11/11/2020	PDK	SGC	SHD	PRI	
C01	ISSUED FOR CONSTRUCTION AND REVISED AS MKD. A01	22/10/2020	AMJ	SGC	SHD	PRI	
A01	ISSUED FOR REFERENCE	02/09/2020	PDK	SGC	SHD	PRI	

DOCUMENT NUMBER	REFERENCE DOCUMENTS
MD-216-3360-EG-CV-GAD-1001	CONCENTRATE STORAGE & REPULP. PLAN AT 913.500
MD-216-3350-EG-ME-GAD-1053	CONCENTRATE FILTRATION. PLAN AT 913.500

RESERVED FOR VENDOR LOGO AND DRAWING NUMBER

LARSEN & TOUBRO
This drawing is the property of LARSEN & TOUBRO and must not be passed on to any person or body not authorized by us to receive it nor be copied or otherwise made use either in full or in part by such person or body without our prior permission in writing.

Outotec
The content of these documents are the sole property of Outotec Oyj. Any rights not expressly granted herein are reserved. Reproduction, transfer or distribution of part or all of the contents in any form without prior written permission of Outotec is prohibited.

MA'ADEN معادن
Saudi Arabian Mining Company شركة معادن السعودية
This document and the information contained herein is Ma'aden proprietary know-how. This document or any part thereof should not be reproduced, stored in a retrieval system or transmitted by any means, electronic or otherwise, or divulged without prior written permission of Ma'aden.

LARSEN & TOUBRO DRAWING NUMBER	019045_450_C_D_24099_004
REVISION	3
OUTOTEC DRAWING NUMBER	900707__GAU01__US02__CTB17__33603
DOCUMENT ID	OU100670792
REVISION	3

DRAWN	PDK	26/08/2020
CHECKED	SGC	30/08/2020
ENGINEER	SHD	28/08/2020
APPROVED	PRI	02/09/2020
EMPLOYER		

MANSOURAH - MASSARAH GOLD PROJECT
DETAIL DRAWING
CONCENTRATE STORAGE AND REPULP
R.C. DETAIL OF GRADE SLAB

SCALE 1:200,100,20 | A0

DRAWING NUMBER MD-216-3360-EG-CV-DED-1233 | REV D01