


DRAWING NUMBER: MD-216-3360-EG-CV-GAD-1230 REV D01

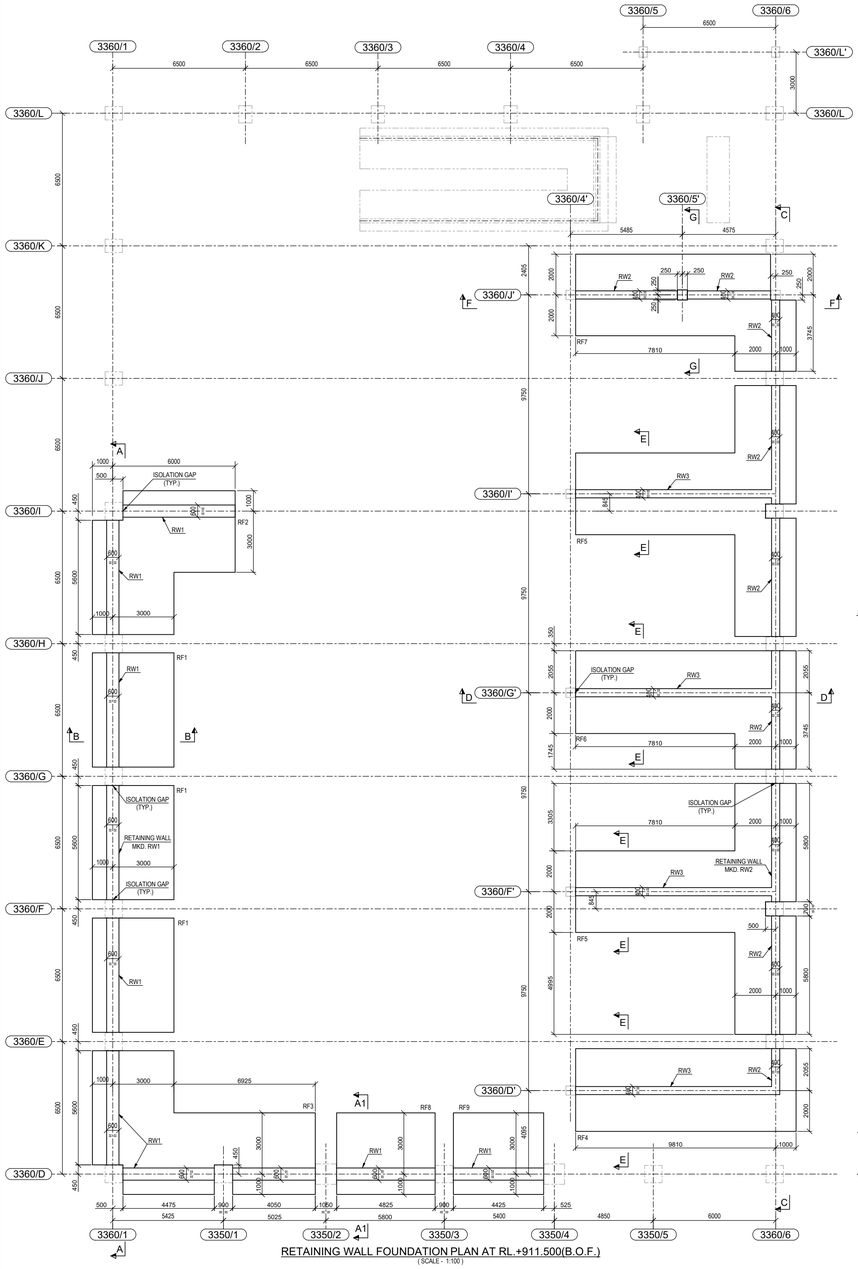


RETAINING WALL FOUNDATION PLAN AT RL.+911.500(B.O.F.)
(SCALE - 1:100)

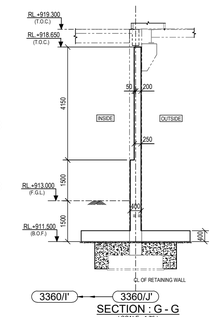


SECTION : G - G
(SCALE - 1:75)

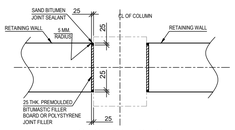


SECTION : X - X
TYP. DET. OF ISOLATION GAP
(SCALE - 1: 25)

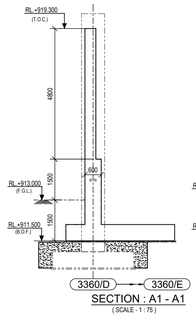


SECTION : A1 - A1
(SCALE - 1:75)

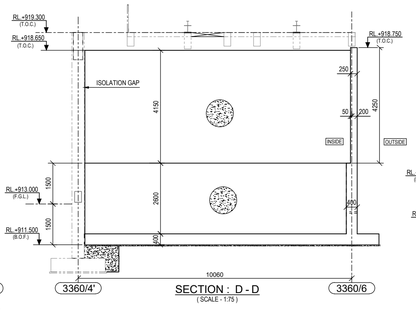


SECTION : D - D
(SCALE - 1:75)

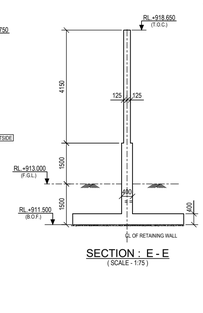


SECTION : E - E
(SCALE - 1:75)

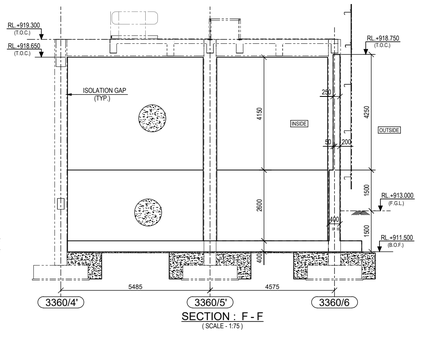


SECTION : F - F
(SCALE - 1:75)

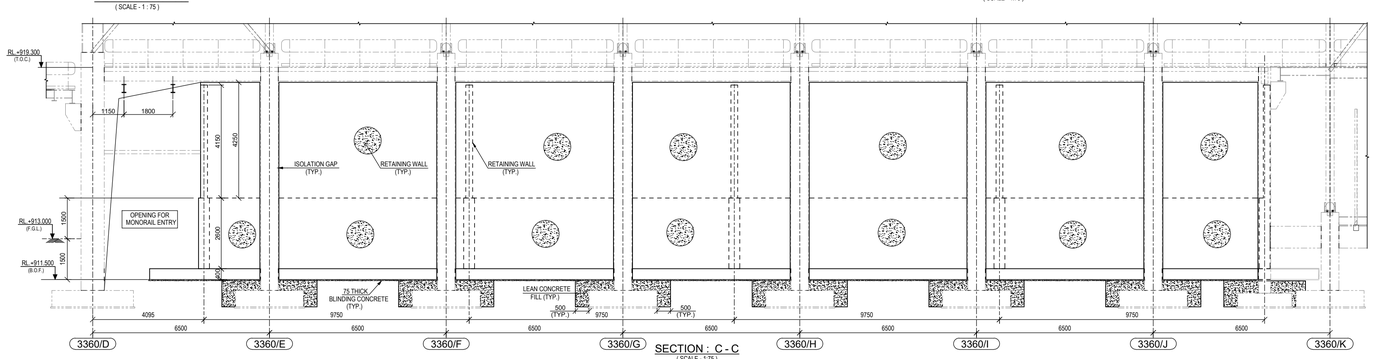

SECTION : C - C
(SCALE - 1:75)

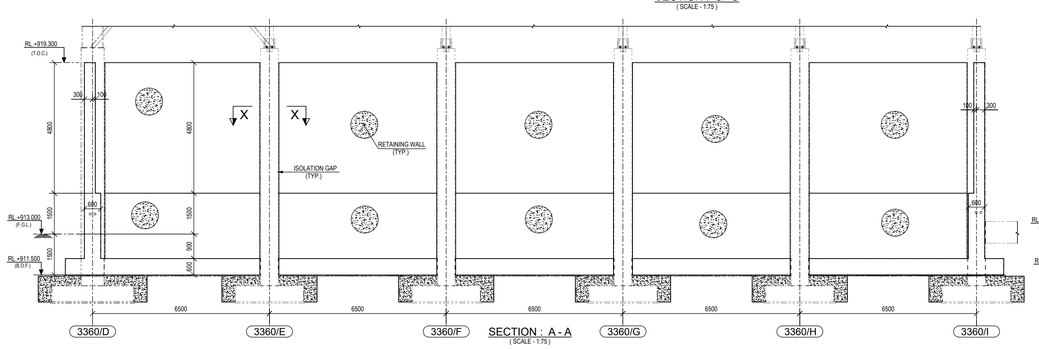

SECTION : A - A
(SCALE - 1:75)

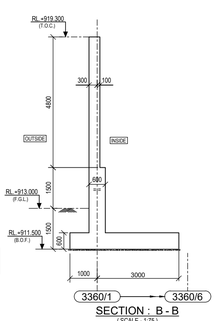

SECTION : B - B
(SCALE - 1:75)

LEGEND :-

RL - REDUCED LEVEL.
T.O.C. - TOP OF CONCRETE.
F.G.L. - FINISHED GROUND LEVEL.
B.O.F. - BOTTOM OF FOOTING.
CL - CENTRE LINE.
THK. - THICK.
TYP. - TYPICAL.
MKD. - MARKED.
G.A. - GENERAL ARRANGEMENT.

NOTES :-

1. ALL DIMENSIONS ARE IN MILLIMETERS AND LEVELS AND CO-ORDINATES ARE IN METERS. UNLESS OTHERWISE STATED.
2. GRADE OF CONCRETE SHALL BE 35 MPa FOR FOUNDATION & 15 MPa FOR BLINDING CONCRETE.
3. GRADE OF REINFORCEMENT SHALL BE DEFORMED BAR 420 MPa (GRADE 60) - ASTM A615/A615M.
4. NET SAFE BEARING CAPACITY OF SOIL AT BOTTOM OF FOUNDATION CONSIDER 450KN/ SQ. M.
5. CLEAR COVER TO MAIN REINFORCEMENT SHALL BE 75 mm FOR RAFT & 50 mm FOR WALL.
6. IF ANY PART OF FOUNDATION COMES ON BACKFILL ZONE OF ADJACENT FOUNDATION OR ANY LOOSE SOIL ARE ENCOUNTERED BELOW FOUNDATION LEVEL THE SAME SHALL BE REMOVED AND FILLED WITH PCC.
7. THIS DRAWING SHALL BE READ IN CONJUNCTION WITH DRAWING NO. MD-216-3360-EG-CV-GAD-1229 & 1231.
8. R.C. DETAIL REFER DRAWING NO. MD-216-3360-EG-CV-DED-1231.
9. ALL OTHER NOTES REFER DRAWING NO. MD-101-SMEM-EG-ST-DST-0001 TO 0008.

DOCUMENT NUMBER	REFERENCE DOCUMENTS	REV	DATE	REVISION DESCRIPTION	DRN	CHK	ENG	APP	EMP
		D01	15/03/2023	AS-BUILT	PDK	SGC	SHD	PRI	
		C02	04/05/2020	ISSUED FOR CONSTRUCTION & REVISED AS MKD. 02	PDK	SGC	SHD	PRI	
MD-216-1000-EG-ST-CRT-1001	CIVIL, STRUCTURAL AND ARCHITECTURAL DESIGN CRITERIA	C01	27/04/2020	ISSUED FOR CONSTRUCTION	PDK	SGC	SHD	PRI	
MD-216-3360-EG-ST-GAD-2223	CONCENTRATE STORAGE & REPULP PLAN, ELEVATION & DET.	A02	03/04/2020	REVISED AS PER EMPLOYER COMMENTS	PDK	SGC	SHD	PRI	
MD-216-3360-EG-ST-GAD-2222	CONCENTRATE STORAGE & REPULP PLAN, ELEVATION & DET.			ON DATED 20/03/2020 & REVISED AS MKD. A02					
MD-216-3360-EG-ST-GAD-2225	CONCENTRATE STORAGE & REPULP PLAN, ELEVATION & DET.	A01	28/01/2020	ISSUED FOR REFERENCE	PDK	SGC	SHD	PRI	

RESERVED FOR VENDOR LOGO AND DRAWING NUMBER

LARSEN & TOUBRO

This drawing is the property of LARSEN & TOUBRO and must not be passed on to any person or body not authorized by us to receive it nor be copied or otherwise made use either in full or in part by such person or body without our prior permission in writing.

Outotec

The content of these documents are the sole property of Outotec Oyj. Any rights not expressly granted herein are reserved. Reproduction, transfer or distribution of part or all of the contents in any form without prior written permission of Outotec is prohibited.

MA'ADEN معادن
Saudi Arabian Mining Company شركة معادن العربية السعودية

This document and the information contained herein is Ma'aden proprietary know-how. This document or any part thereof should not be reproduced, stored in a retrieval system or transmitted by any means, electronic or otherwise, or divulged without prior written permission of Ma'aden.

LARSEN & TOUBRO DRAWING NUMBER	REVISION 4
019045_450_C_G_24098_002	
OUTOTEC DRAWING NUMBER	DOCUMENT ID / REVISION 4
900707__GAU01__US02__MTL01__33606	OU100670714

DRAWN	PDK	06/01/2020
CHECKED	SGC	15/01/2020
ENGINEER	SHD	04/01/2020
APPROVED	PRI	28/01/2020
EMPLOYER		
SCALE	1:100	A0

MANSOURAH - MASSARAH GOLD PROJECT
GENERAL ARRANGEMENT DRAWING
CONCENTRATE STORAGE AND REPULP
G.A. & DETAILS OF RETAINING WALL

DRAWING NUMBER: MD - 216 - 3360 - EG - CV - GAD - 1230 REV: D01