


DRAWING NUMBER: MD-216-3360-EG-CV-GAD-1231 | REV: D01

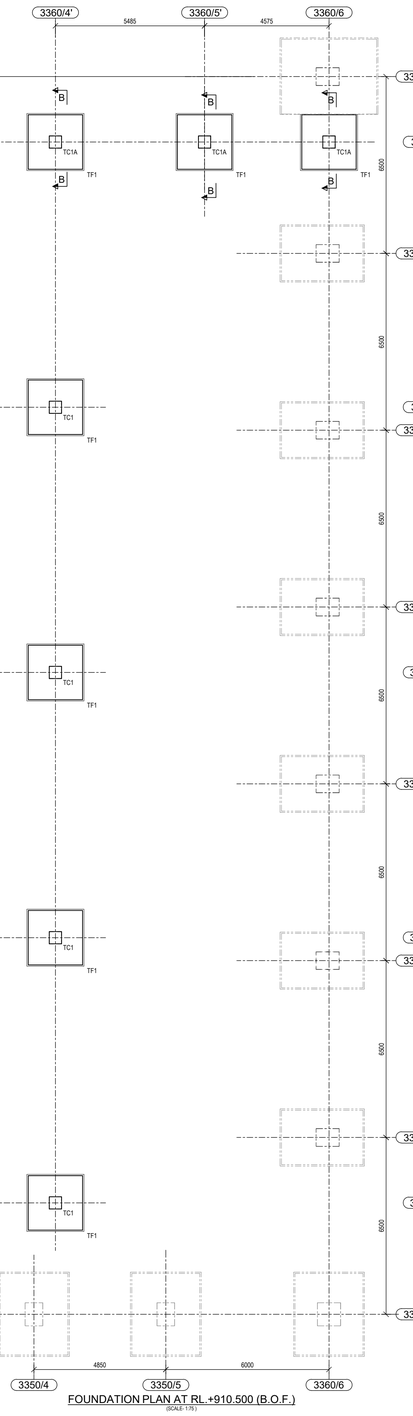


FOUNDATION PLAN AT RL.+910.500 (B.O.F.)
(SCALE-1:75)

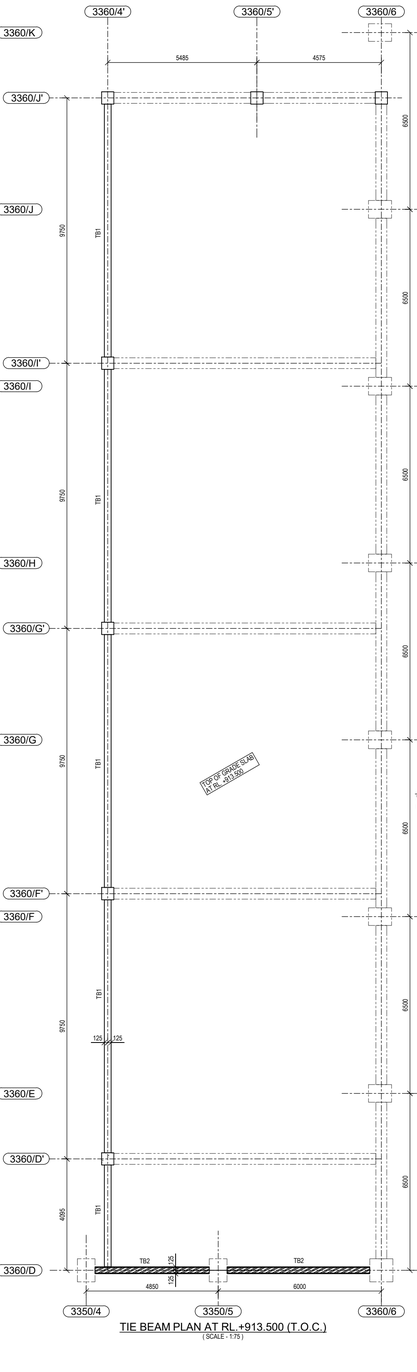

TIE BEAM PLAN AT RL.+913.500 (T.O.C.)
(SCALE - 1:75)

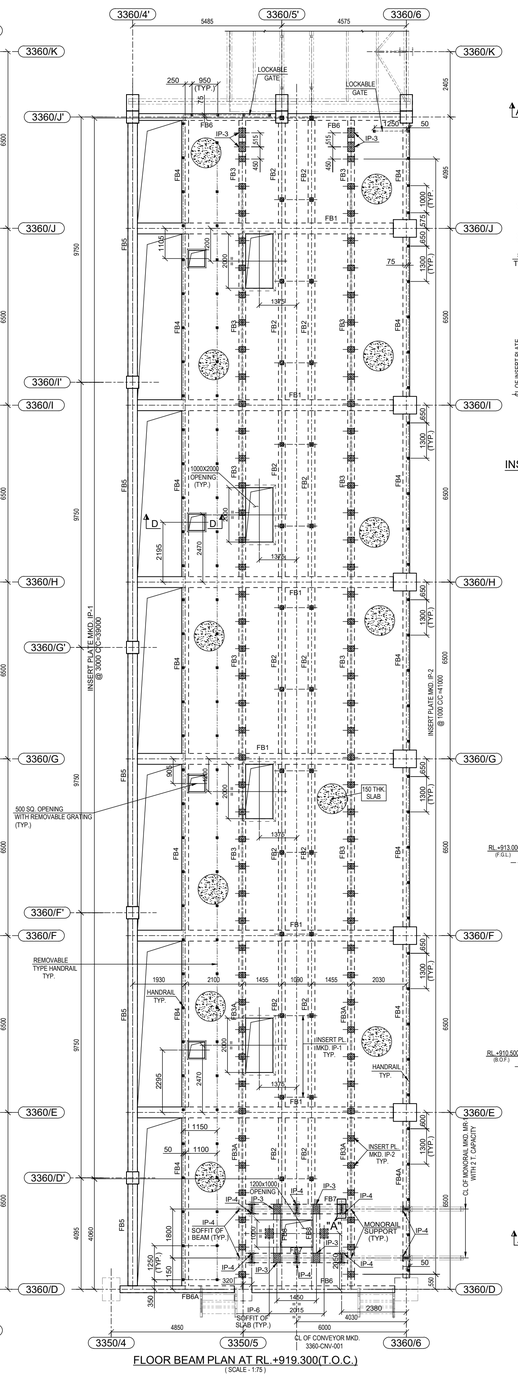


FLOOR BEAM PLAN AT RL.+919.300(T.O.C.)
(SCALE - 1:75)

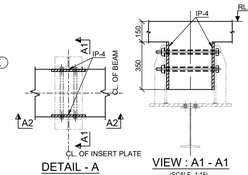


DETAIL - A
(SCALE- 1:15)


VIEW : A1 - A1
(SCALE- 1:15)

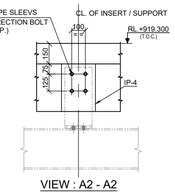

VIEW : A2 - A2
(SCALE- 1:15)

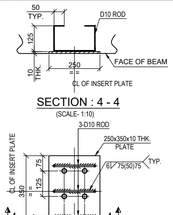


SECTION : 4 - 4
(SCALE- 1:10)

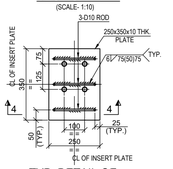


TYP. DETAIL OF
INSERT PLATE MKD. IP-4
(SCALE- 1:10)


SCHEDULE OF BEAM			
BEAM MKD.	SIZE WIDTH (mm.)	SIZE DEPTH (mm.)	LEVEL
TB1	250	400	RL.+913.500 (T.O.C.)
TB2	250	500	
FB1	400	1000	RL.+919.300 (T.O.C.)
FB2	250	500	
FB3	250	600	
FB3A	250	600	
FB4	250	500	
FB4A	250	500	
FB5	350	1000	
FB6	250	600	
FB6A	250	1000	
FB7	350	500	
FB8	250	400	

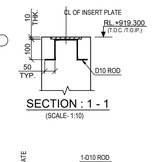


SECTION : 1 - 1
(SCALE- 1:10)

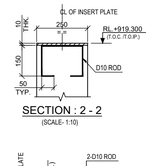


SECTION : 2 - 2
(SCALE- 1:10)

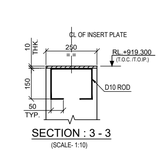


SECTION : 3 - 3
(SCALE- 1:10)

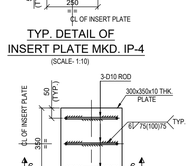


TYP. DETAIL OF
INSERT PLATE MKD. IP-6
(SCALE- 1:10)

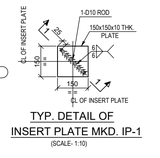


TYP. DETAIL OF
INSERT PLATE MKD. IP-1
(SCALE- 1:10)

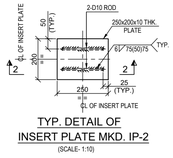


TYP. DETAIL OF
INSERT PLATE MKD. IP-2
(SCALE- 1:10)

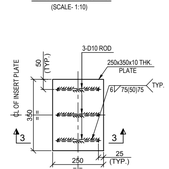

TYP. DETAIL OF
INSERT PLATE MKD. IP-3
(SCALE- 1:10)

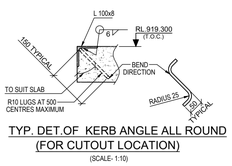


TYP. DET.OF KERB ANGLE ALL ROUND
(FOR CUTOUT LOCATION)
(SCALE- 1:10)

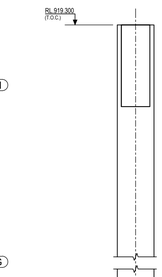


SECTION : A - A
(SCALE - 1:25)


TYP. DETAIL OF FOUNDATION MKD. TF1
(SCALE - 1:25)

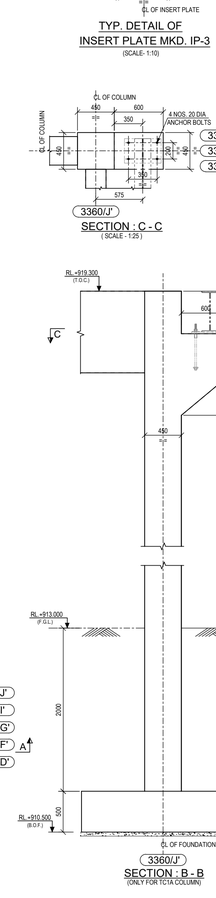

SECTION : C - C
(SCALE - 1:25)

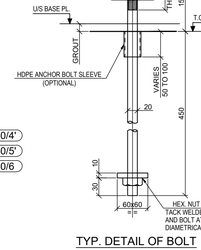

TYP. DETAIL OF BOLT

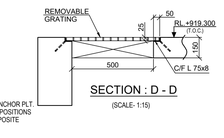

SECTION : D - D
(SCALE- 1:15)

SECTION : B - B
(ONLY FOR TC1A COLUMN)

LEGEND :-

RL - REDUCED LEVEL.
T.O.C. - TOP OF CONCRETE.
F.G.L. - FINISHED GROUND LEVEL.
B.O.F. - BOTTOM OF FOOTING.
B.O.C. - BOTTOM OF CONCRETE.
CL - CENTRE LINE.
TYP. - TYPICAL.
IP - INSERT PLATE.
MKD. - MARKED.
G.A. - GENERAL ARRANGEMENT.
R.C.C. - REINFORCED CEMENT CONRETE.
THK. - THICKNESS.
U/S BASE PL. - UNDERSIDE OF BASE PLATE.

NOTES :-

1. ALL DIMENSIONS ARE IN MILLIMETRE AND LEVELS AND CO-ORDINATES ARE IN METRE, UNLESS OTHERWISE STATED.
2. GRADE OF CONCRETE SHALL BE 35 MPa FOR FOUNDATION & 15 MPa FOR BLINDING CONCRETE.
3. GRADE OF REINFORCEMENT SHALL BE DEFORMED BAR 420 MPa (GRADE 60) - ASTM A615/A615M.
4. NET SAFE BEARING CAPACITY OF SOIL AT BOTTOM OF FOUNDATION CONSIDER 450KN/ SQ. M.
5. CLEAR COVER TO MAIN REINFORCEMENT SHALL BE 75 mm FOR RAFT & 50 mm FOR COLUMN.
6. IF ANY PART OF FOUNDATION COMES ON BACKFILL ZONE OF ADJACENT FOUNDATION OR ANY LOOSE SOIL ARE ENCOUNTERED BELOW FOUNDATION LEVEL THE SAME SHALL BE REMOVED AND FILLED WITH PCC.
7. THIS DRAWING SHALL BE READ IN CONJUNCTION WITH DRAWING NO. MD-216-3360-EG-CV-GAD-1229 & 1230.
8. R.C.C. DETAIL REFER DRAWING NO. MD-216-3360-EG-CV-DED-1232.
9. ALL OTHER NOTES REFER DRAWING NO. MD-101-SMEM-EG-ST-DST-0001 TO 0008.

DOCUMENT NUMBER	REFERENCE DOCUMENTS	REV	DATE	REVISION DESCRIPTION	DRN	CHK	ENG	APP	EMP
		D01	15/03/2023	AS-BUILT	PDK	SGC	SHD	PRI	
		C03	20/11/2020	ISSUED FOR CONSTRUCTION & REVISED AS MKD. C02	PDK	SGC	SHD	PRI	
MD-216-1000-EG-CV-DED-1003	ANCHOR BOLTS STANDARD DETAILS	C02	28/07/2020	ISSUED FOR CONSTRUCTION & REVISED AS MKD. C02	PDK	SGC	SHD	PRI	
MD-216-1000-EG-ST-CRT-1001	CIVIL, STRUCTURAL AND ARCHITECTURAL DESIGN CRITERIA	C01	27/04/2020	ISSUED FOR CONSTRUCTION	PDK	SGC	SHD	PRI	
MD-216-3360-EG-ST-GAD-2223	CONCENTRATE STORAGE & REPULP PLAN, ELEVATION & DET	A02	03/04/2020	REVISED AS PER EMPLOYER COMMENTS ON	PDK	SGC	SHD	PRI	
MD-216-3360-EG-ST-GAD-2222	CONCENTRATE STORAGE & REPULP PLAN, ELEVATION & DET			DATED 20/03/2020 & REVISED AS MKD. A02					
MD-216-3360-EG-ST-GAD-2215	CONCENTRATE STORAGE & REPULP PLAN, ELEVATION & DET	A01	28/01/2020	ISSUED FOR REFERENCE	PDK	SGC	SHD	PRI	

RESERVED FOR VENDOR LOGO AND DRAWING NUMBER

LARSEN & TOUBRO
This drawing is the property of LARSEN & TOUBRO and must not be passed on to any person or body not authorized by us to receive it nor be copied or otherwise made use either in full or in part by such person or body without our prior permission in writing.

Outotec
The content of these documents are the sole property of Outotec Oyj. Any rights not expressly granted herein are reserved. Reproduction, transfer or distribution of part or all of the contents in any form without prior written permission of Outotec is prohibited.

MA'ADEN معادن Saudi Arabian Mining Company
This document and the information contained herein is Ma'aden proprietary know-how. This document or any part thereof should not be reproduced, stored in a retrieval system or transmitted by any means, electronic or otherwise, or divulged without prior written permission of Ma'aden.

LARSEN & TOUBRO DRAWING NUMBER	REVISION
019045_450_C_G_24098_003	5
OUTOTEC DRAWING NUMBER	DOCUMENT ID / REVISION
900707_GAU01_US02_MTL01_33607	OU100670715 / 5

DRAWN	PDK	09/01/2020
CHECKED	SGC	17/01/2020
ENGINEER	SHD	07/01/2020
APPROVED	PRI	28/01/2020
EMPLOYER		
SCALE	1:100	A0

MANSOURAH - MASSARAH GOLD PROJECT
GENERAL ARRANGEMENT DRAWING
CONCENTRATE STORAGE AND REPULP
G.A. & DETAILS OF TRIPPER SUPPORTING STR.

DRAWING NUMBER: MD-216-3360-EG-CV-GAD-1231 | REV: D01