MA'ADEN معادن
Saudi Arabian Mining Company شركة التعدين العربية السعودية

Project **Mansourah Massarah Gold Project**
Customer: **MA'ADEN GOLD AND BASE METALS (MA'ADEN)**

Title: **GENERAL ARRANGEMENT DRAWING**
3360 CONCENTRATE STORAGE AND REPULP
G.A. & DETAILS OF GRADE SLAB


Document Number: **MD-216-3360-EG-CV-GAD-1233**
Revision: **D01**
Revision Date: **13.10.2023**
Status: **ISSUED FOR CONSTRUCTION**

Outotec Document Number:	900707	GAU01	US02	MTL01	33609	OU100670717	4
L&T Document Number:	O19045	450	C	G	24098	005	4


REVISION HISTORY

Rev	Date	Revision Text	Prepared By	Reviewed By	Approved By	Employer
A01	02.09..2020	ISSUED FOR REFERENCE	PDK	SGC	PRI	
C01	13.10..2020	ISSUED FOR CONSTRUCTION & REVISED AS MKD. C01	PDK	SGC	PRI	
C02	07.11..2020	ISSUED FOR CONSTRUCTION & REVISED AS MKD. C02	PDK	SGC	PRI	
C03	08.03..2021	ISSUED FOR CONSTRUCTION & REVISED AS MKD. C03	PDK	SGC	PRI	
D01	13.10. 2023	AS BUILT	PDK	SGC	PRI	


DRAWING NUMBER: MD-216-3360-EG-CV-GAD-1233 | REV: D01

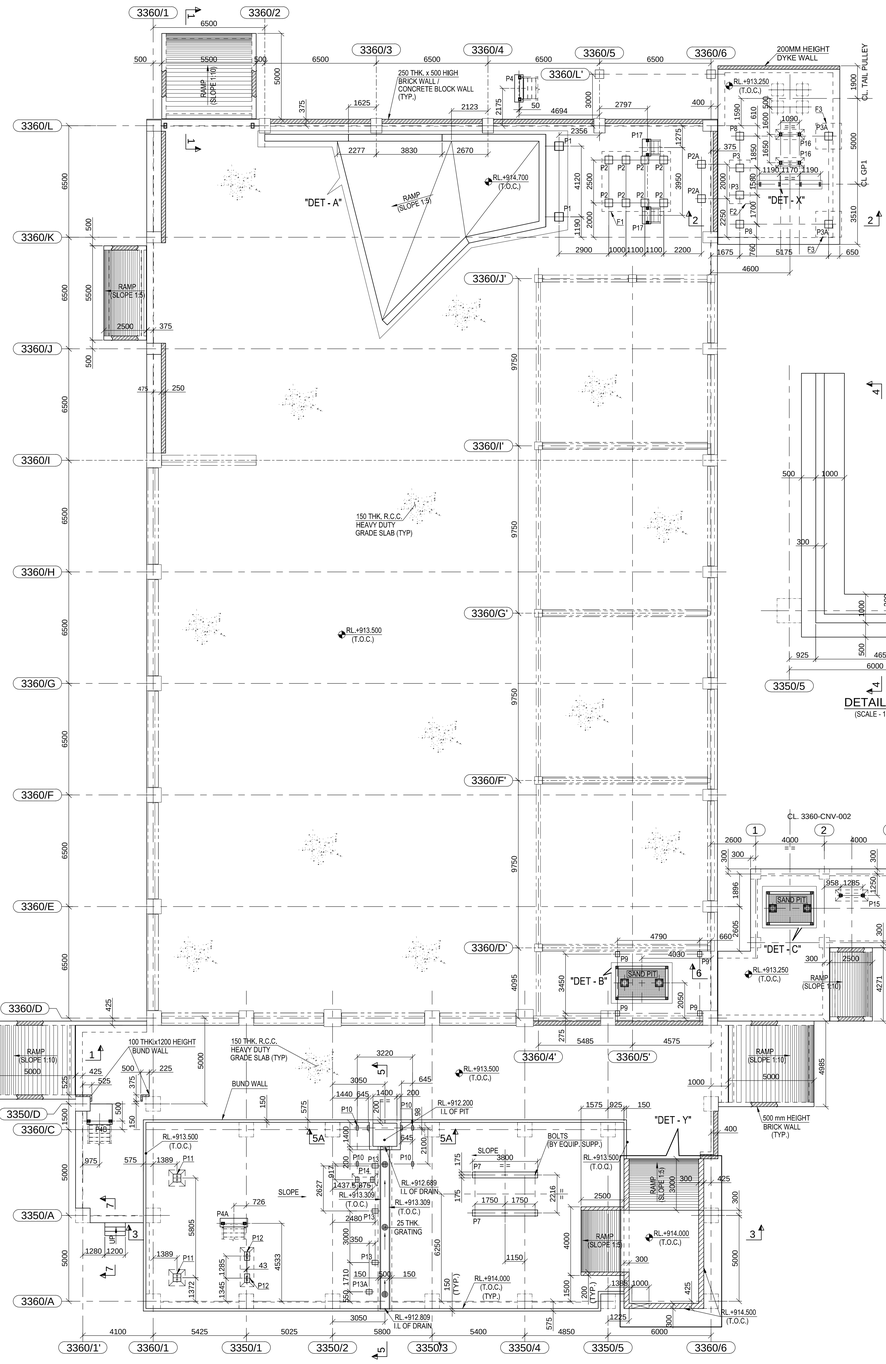

PLAN AT GRADE SLAB LEVEL AT RL.+913.500 (T.O.C.)
(SCALE - 1:125)

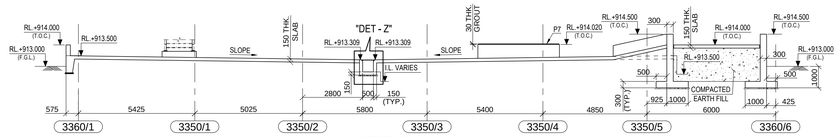


SECTION : 3 - 3
(SCALE - 1:100)

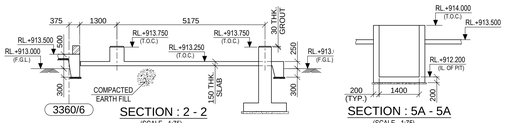


SECTION : 2 - 2
(SCALE - 1:75)


SECTION : 5A- 5A
(SCALE - 1:75)

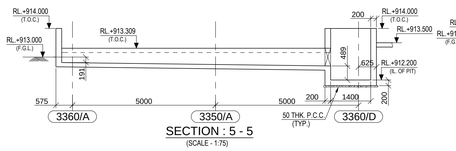


SECTION : 5 - 5
(SCALE - 1:75)

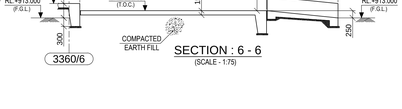

SECTION : 6 - 6
(SCALE - 1:75)

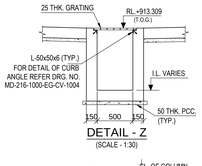


DETAIL - Z
(SCALE - 1:30)

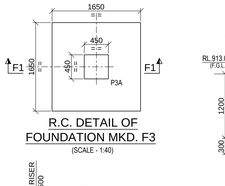


R.C. DETAIL OF FOUNDATION MKD. F3
(SCALE - 1:40)


SECTION : F1 - F1
(SCALE - 1:40)

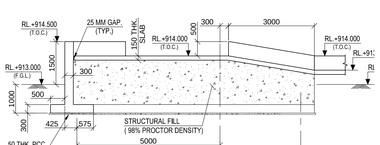


SECTION : 4 - 4
(SCALE - 1:75)

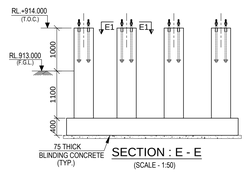


SECTION : E - E
(SCALE - 1:50)

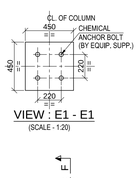


VIEW : E1 - E1
(SCALE - 1:20)

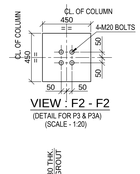


VIEW : F2 - F2
(DETAIL FOR P3 & P3A)
(SCALE - 1:20)

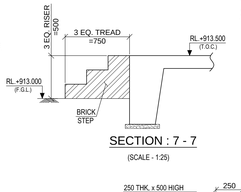


SECTION : 7 - 7
(SCALE - 1:25)

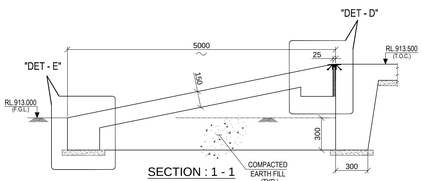


SECTION : 1 - 1
(SCALE - 1 : 20)

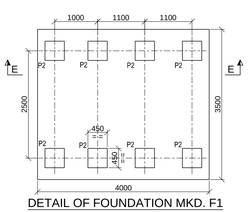


DETAIL OF FOUNDATION MKD. F1
(SCALE - 1:50)

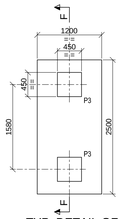


TYP. DETAIL OF FOUNDATION MKD. F2
(SCALE - 1:40)

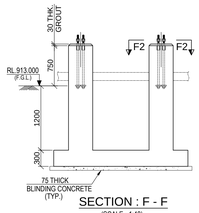


SECTION : F - F
(SCALE - 1:40)

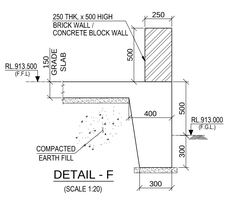


DETAIL - F
(SCALE 1:20)

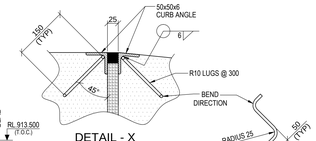


DETAIL - X
(SCALE 1:5)

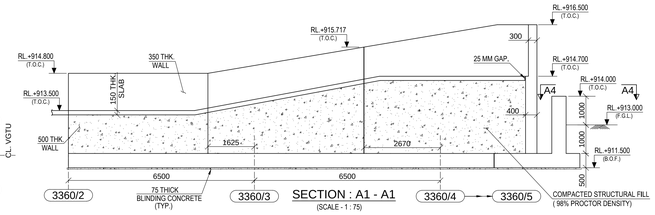


SECTION : A1 - A1
(SCALE - 1 : 75)

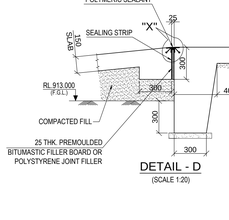


DETAIL - D
(SCALE 1:20)

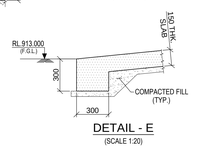


DETAIL - E
(SCALE 1:20)

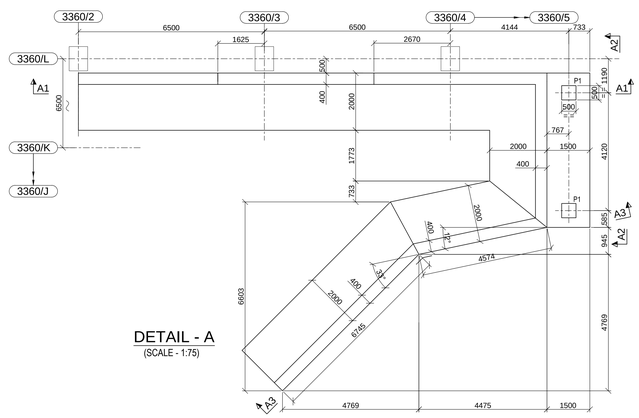


DETAIL - A
(SCALE - 1:75)

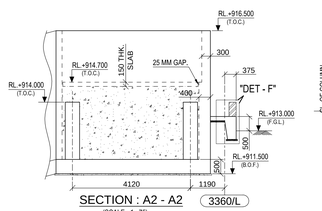

SECTION : A2 - A2
(SCALE - 1 : 75)
3360/L

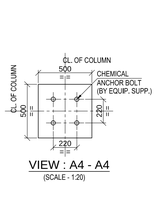

VIEW : A4 - A4
(SCALE - 1:20)

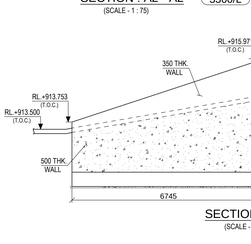

SECTION : A3 - A3
(SCALE - 1 : 75)

LEGEND :-

RL. - REDUCED LEVEL.	
T.O.C. - TOP OF CONCRETE.	
F.G.L. - FINISHED GROUND LEVEL.	
B.O.F. - BOTTOM OF FOOTING.	
CL - CENTRE LINE.	
TYP. - TYPICAL.	
THK. - THICK.	
MKD. - MARKED.	
C/C - CENTER TO CENTER.	
DIA. - DIAMETER.	
OS. - OILY WATER DRAINAGE PIPE	

NOTES :-

1. ALL DIMENSIONS ARE IN MILLIMETERS AND LEVELS AND CO-ORDINATES ARE IN METERS. UNLESS OTHERWISE STATED.
2. GRADE OF CONCRETE SHALL BE 35 MPa FOR FOUNDATION & 15 MPa FOR BLINDING CONCRETE.
3. GRADE OF REINFORCEMENT SHALL BE DEFORMED BAR 420 MPa (GRADE 60) - ASTM A615/A615M.
4. NET SAFE BEARING CAPACITY OF SOIL AT BOTTOM OF FOUNDATION CONSIDER 500 KN/ SQ. M.
5. CLEAR COVER TO MAIN REINFORCEMENT SHALL BE 75 mm FOR RAFT & 50 mm FOR COLUMN.
6. IF ANY PART OF FOUNDATION COMES ON BACKFILL ZONE OF ADJACENT FOUNDATION OR ANY LOOSE SOIL ARE ENCOUNTERED BELOW FOUNDATION LEVEL THE SAME SHALL BE REMOVED AND FILLED WITH PCC.
7. FOR DETAILS OF GRADE SLAB REFER DRG. NO. MD-216-1000-EG-CV-DED-1002.
8. THE CONTENT OF THIS DRAWING SHALL CONFORM TO THE PROVISIONS OF CIVIL, STRUCTURAL AND ARCHITECTURAL DESIGN CRITERIA DOC NO. MD-216-1000-EG-ST-CRT-1001.
9. THIS DRAWING SHALL BE READ IN CONJUNCTION WITH DRAWING NO. MD-216-3360-EG-CV-GAD-1230 & MD-216-3360-EG-CV-GAD-1233 (SHEET 2 OF 2).
10. FOR R.C. DETAILS REFER DRG. NO. MD-216-3360-EG-CV-DED-1233.
11. ALL OTHER NOTES REFER DRAWING NO. MD-101-SMEM-EG-ST-DST-0001 TO 0008.
12. GENERAL NOTES FOR CIVIL WORKS & STANDARD REINFORCEMENT DETAIL REFER DRAWING NO. MD-216-1000-EG-CV-DED-1001 & 1005.
13. FOR DETAIL OF BOLTS REFER DRG. NO. MD-216-1000-EG-CV-DED-1003.

DOCUMENT NUMBER	REFERENCE DOCUMENTS	REV	DATE	REVISION DESCRIPTION	DRN	CHK	ENG	APP	EMP
		D01	13/10/2023	AS - BUILT	PDK	SGC	SHD	PRI	
		C03	08/03/2021	ISSUED FOR CONSTRUCTION & REVISED AS MKD. C03.	PDK	SGC	SHD	PRI	
MD-216-1000-EG-ST-CRT-1001	CIVIL, STRUCTURAL AND ARCHITECTURAL DESIGN CRITERIA	C02	11/11/2020	ISSUED FOR CONSTRUCTION & REVISED AS MKD. C02.	PDK	SGC	SHD	PRI	
MD-216-3360-EG-CV-GAD-1001	CONCENTRATE STORAGE & REPULP, PLAN AT 913.500	C01	13/10/2020	ISSUED FOR CONSTRUCTION & REVISED AS MKD. C01	PDK	SGC	SHD	PRI	
MD-216-3350-EG-ME-GAD-1053	CONCENTRATE FILTRATION, PLAN AT 913.500	A01	02/09/2020	ISSUED FOR REFERENCE	PDK	SGC	SHD	PRI	

RESERVED FOR VENDOR LOGO AND DRAWING NUMBER

LARSEN & TOUBRO

This drawing is the property of LARSEN & TOUBRO and must not be passed on to any person or body not authorized by us to receive it nor be copied or otherwise made use either in full or in part by such person or body without our prior permission in writing.

Outotec

The content of these documents are the sole property of Outotec Oyj. Any rights not expressly granted herein are reserved. Reproduction, transfer or distribution of part or all of the contents in any form without prior written permission of Outotec is prohibited.


MA'ADEN معادن
Saudi Arabian Mining Company شركة معادن العربية السعودية

This document and the information contained herein is Ma'aden proprietary know-how. This document or any part thereof should not be reproduced, stored in a retrieval system or transmitted by any means, electronic or otherwise, or divulged without prior written permission of Ma'aden.


LARSEN & TOUBRO DRAWING NUMBER	REVISION 4
019045_450_C_G_24098_005	
OUTOTEC DRAWING NUMBER	DOCUMENT ID / REVISION 4
900707 __ GAU01 __ US02 __ MTL01 __ 33609	OU100670717

DRAWN	PDK	15/07/2020	MANSOURAH - MASSARAH GOLD PROJECT
CHECKED	SGC	16/08/2020	GENERAL ARRANGEMENT DRAWING
ENGINEER	SHD	13/07/2020	CONCENTRATE STORAGE AND REPULP
APPROVED	PRI	02/09/2020	G.A. & DETAILS OF GRADE SLAB (SHEET 1 OF 2)
EMPLOYER			
SCALE 1:100		A0	DRAWING NUMBER: MD - 216 - 3360 - EG - CV - GAD - 1233 / REV: D01


DRAWING NUMBER: MD-216-3360-EG-CV-GAD-1233 | REV: D01

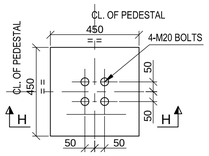


DETAIL OF PEDESTAL
MKD. P8
(SCALE - 1:15)

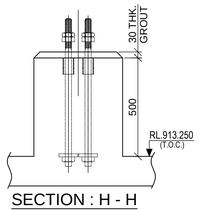


SECTION : H - H
(SCALE - 1:15)

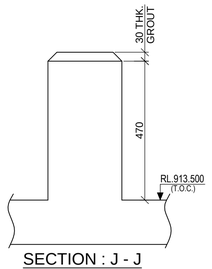


SECTION : J - J
(SCALE - 1:10)

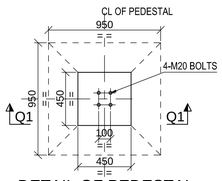


DETAIL OF PEDESTAL
MKD. P11
(SCALE - 1:25)

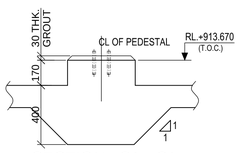


SECTION : Q1 - Q1
(SCALE - 1 : 20)

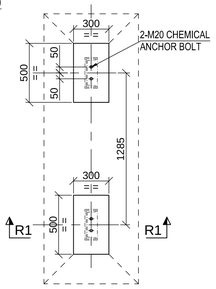


DETAIL OF PEDESTAL
MKD. P12
(SCALE - 1:25)

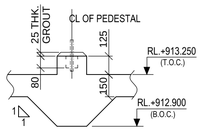


SECTION : N1 - N1
(SCALE - 1 : 20)

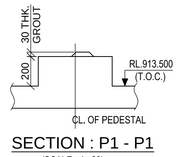


SECTION : P1 - P1
(SCALE - 1 : 20)

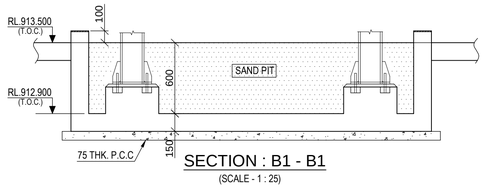


SECTION : B1 - B1
(SCALE - 1 : 25)

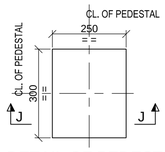


DETAIL OF PEDESTAL
MKD. P9
(SCALE - 1:10)

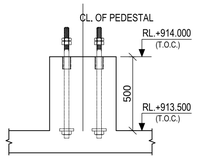


SECTION : E1 - E1
(SCALE - 1 : 20)

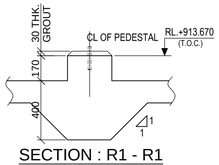


SECTION : R1 - R1
(SCALE - 1 : 20)

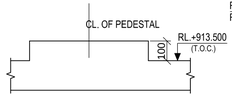


SECTION : J1 - J1
(SCALE - 1 : 15)

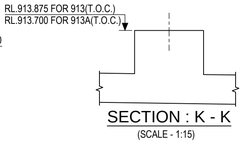


SECTION : K - K
(SCALE - 1:15)

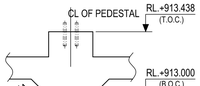


SECTION : L1 - L1
(SCALE - 1 : 20)

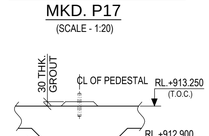


SECTION : M1 - M1
(SCALE - 1 : 20)

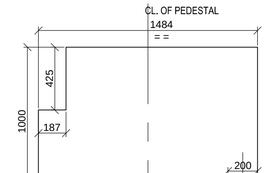


DETAIL OF PEDESTAL
MKD. P4B
(SCALE - 1:20)

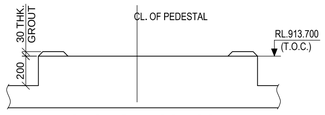


SECTION : G3 - G3
(FOR PEDESTAL MKD. P4B)
(SCALE - 1 : 20)

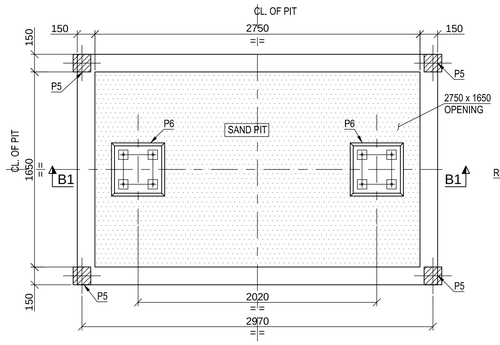

DETAIL - B
(SCALE 1:25)

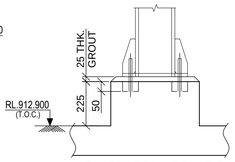


SECTION : B3 - B3
(SCALE - 1:15)

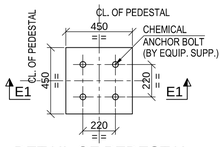


DETAIL OF PEDESTAL
MKD. P2A
(SCALE - 1:20)




DETAIL OF PEDESTAL
MKD. P10
(SCALE - 1:15)

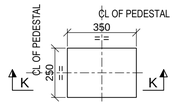


DETAIL OF PEDESTAL
MKD. P13 & P13A
(SCALE - 1:15)

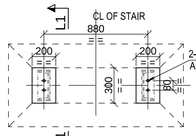


DETAIL OF PEDESTAL
MKD. P14
(SCALE - 1:25)

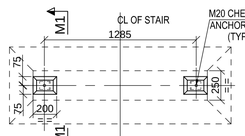


DETAIL OF PEDESTAL
MKD. P15
(SCALE - 1:25)

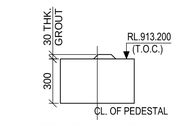


SECTION : G - G
(FOR PEDESTAL MKD. P4)
(SCALE - 1 : 20)

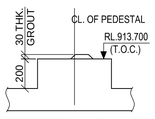


SECTION : G1 - G1
(FOR PEDESTAL MKD. P4A)
(SCALE - 1 : 20)

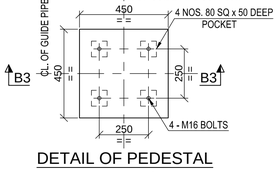


DETAIL OF PEDESTAL
MKD. P6
(SCALE - 1:15)

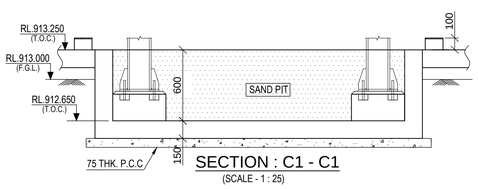


SECTION : C1 - C1
(SCALE - 1 : 25)

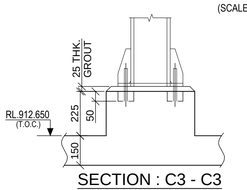


SECTION : C3 - C3
(SCALE - 1:15)

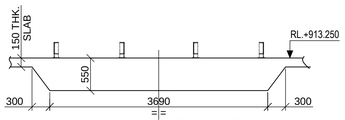


SECTION : X1 - X1
(SCALE - 1:50)

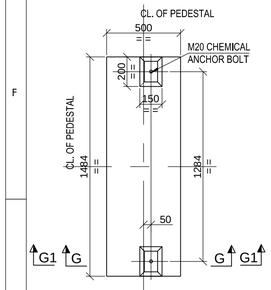


DETAIL OF PEDESTAL
MKD. P4 & P4A
(SCALE - 1:20)

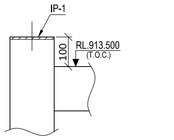


SECTION : B2 - B2
(SCALE - 1:10)

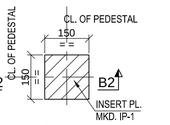


DETAIL OF PEDESTAL
MKD. P5
(SCALE - 1:10)

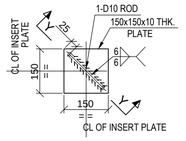


TYP. DETAIL OF
INSERT PLATE MKD. IP-1
(SCALE- 1:10)

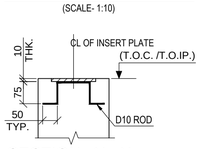


SECTION : Y - Y
(SCALE- 1:10)

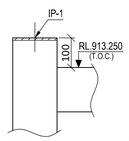


SECTION : C2 - C2
(SCALE - 1:10)

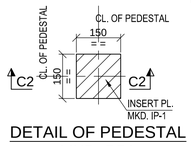


DETAIL OF PEDESTAL
MKD. P5A
(SCALE - 1:10)

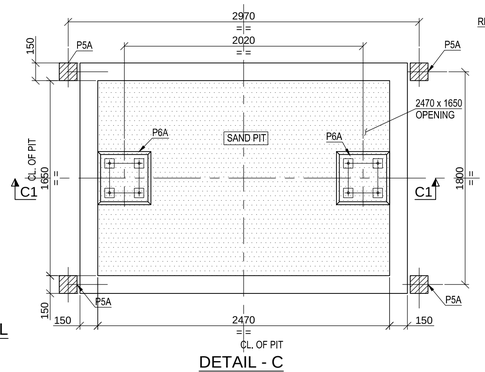

DETAIL - C
(SCALE 1:25)

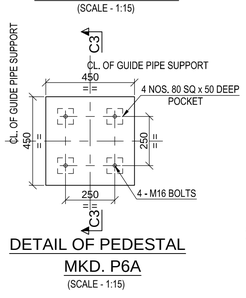

DETAIL OF PEDESTAL
MKD. P6A
(SCALE - 1:15)

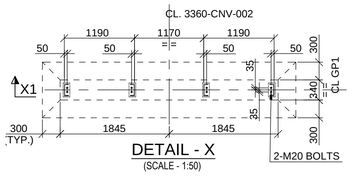

DETAIL - X
(SCALE - 1:50)

LEGEND :-

RL - REDUCED LEVEL.
T.O.C. - TOP OF CONCRETE.
F.G.L. - FINISHED GROUND LEVEL.
B.O.F. - BOTTOM OF FOOTING.
CL - CENTRE LINE.
TYP. - TYPICAL.
THK. - THICK.
MKD. - MARKED.
C/C - CENTER TO CENTER.
DIA. - DIAMETER.
OS. - OILY WATER DRAINAGE PIPE

NOTES :-

1. ALL DIMENSIONS ARE IN MILLIMETERS AND LEVELS AND CO-ORDINATES ARE IN METERS. UNLESS OTHERWISE STATED.
2. GRADE OF CONCRETE SHALL BE 35 MPa FOR FOUNDATION & 15 MPa FOR BLINDING CONCRETE.
3. GRADE OF REINFORCEMENT SHALL BE DEFORMED BAR 420 MPa (GRADE 60) - ASTM A615/A615M.
4. NET SAFE BEARING CAPACITY OF SOIL AT BOTTOM OF FOUNDATION CONSIDER 500 KN/ SQ. M.
5. CLEAR COVER TO MAIN REINFORCEMENT SHALL BE 75 mm FOR RAFT & 50 mm FOR COLUMN.
6. IF ANY PART OF FOUNDATION COMES ON BACKFILL ZONE OF ADJACENT FOUNDATION OR ANY LOOSE SOIL ARE ENCOUNTERED BELOW FOUNDATION LEVEL THE SAME SHALL BE REMOVED AND FILLED WITH PCC.
7. FOR DETAILS OF GRADE SLAB REFER DRG. NO. MD-216-1000-EG-CV-DED-1002.
8. THE CONTENT OF THIS DRAWING SHALL CONFORM TO THE PROVISIONS OF CIVIL, STRUCTURAL AND ARCHITECTURAL DESIGN CRITERIA DOC NO. MD-216-1000-EG-ST-CRT-1001.
9. THIS DRAWING SHALL BE READ IN CONJUNCTION WITH DRAWING NO. MD-216-3360-EG-CV-GAD-1230 & MD-216-3360-EG-CV-GAD-1233 (SHEET 1 OF 2).
10. FOR R.C. DETAILS REFER DRG. NO. MD-216-3360-EG-CV-DED-1233.
11. ALL OTHER NOTES REFER DRAWING NO. MD-101-SMEM-EG-ST-DST-0001 TO 0008.
12. GENERAL NOTES FOR CIVIL WORKS & STANDARD REINFORCEMENT DETAIL REFER DRAWING NO. MD-216-1000-EG-CV-DED-1001 & 1005.
13. FOR DETAIL OF BOLTS REFER DRG. NO. MD-216-1000-EG-CV-DED-1003.

DOCUMENT NUMBER	REFERENCE DOCUMENTS			REVISION DESCRIPTION	DRN	CHK	ENG	APP	EMP
		D01	13/10/2023	AS - BUILT	PDK	SGC	SHD	PRI	
		C03	08/03/2021	ISSUED FOR CONSTRUCTION	PDK	SGC	SHD	PRI	
MD-216-1000-EG-ST-CRT-1001	CIVIL, STRUCTURAL AND ARCHITECTURAL DESIGN CRITERIA	C02	11/11/2020	ISSUED FOR CONSTRUCTION & REVISED AS MKD. C02	PDK	SGC	SHD	PRI	
MD-216-3360-EG-CV-GAD-1001	CONCENTRATE STORAGE & REPULP, PLAN AT 913.500	C01	13/10/2020	ISSUED FOR CONSTRUCTION & REVISED AS MKD. C01	PDK	SGC	SHD	PRI	
MD-216-3350-EG-ME-GAD-1053	CONCENTRATE FILTRATION, PLAN AT 913.500	A01	02/09/2020	ISSUED FOR REFERENCE	PDK	SGC	SHD	PRI	

RESERVED FOR VENDOR LOGO AND DRAWING NUMBER

LARSEN & TOUBRO
This drawing is the property of LARSEN & TOUBRO and must not be passed on to any person or body not authorized by us to receive it nor be copied or otherwise made use either in full or in part by such person or body without our prior permission in writing.

Outotec
The content of these documents are the sole property of Outotec Oy). Any rights not expressly granted herein are reserved. Reproduction, transfer or distribution of part or all of the contents in any form without prior written permission of Outotec is prohibited.

MA'ADEN معادن
Saudi Arabian Mining Company شركة التعدين العربية السعودية
This document and the information contained herein is Ma'aden proprietary know-how. This document or any part thereof should not be reproduced, stored in a retrieval system or transmitted by any means, electronic or otherwise, or divulged without prior written permission of Ma'aden.

LARSEN & TOUBRO DRAWING NUMBER	019045_450_C_G_24098_005	REVISION 4
OUTOTEC DRAWING NUMBER	900707__GAU01__US02__MTL01__33609	DOCUMENT ID OU100670717 / REVISION 4

DRAWN	PDK	15/07/2020
CHECKED	SGC	16/08/2020
ENGINEER	SHD	13/07/2020
APPROVED	PRI	02/09/2020
EMPLOYER		
SCALE 1:50		A1

MANSOURAH - MASSARAH GOLD PROJECT
GENERAL ARRANGEMENT DRAWING
CONCENTRATE STORAGE AND REPULP
G.A. & DETAILS OF GRADE SLAB (SHEET 2 OF 2)

DRAWING NUMBER: MD - 216 - 3360 - EG - CV - GAD - 1233 | REV: D01