


DRAWING NUMBER: MD-216-3370-EG-CV-GAD-1232 REV D01

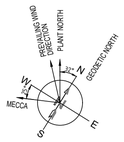


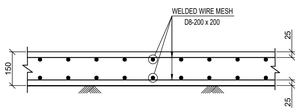


DETAIL OF GRADE SLAB
(SCALE 1:10)

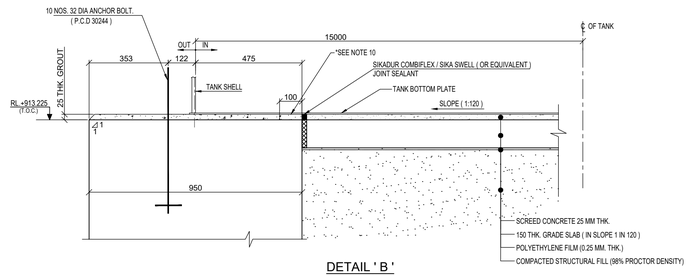


DETAIL ' B '
(SCALE 1:10)

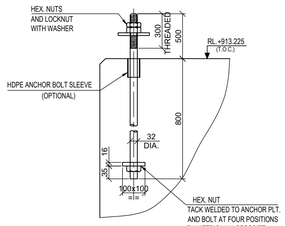


BOLT DETAIL
(SEE NOTE 11)
(SCALE 1:10)

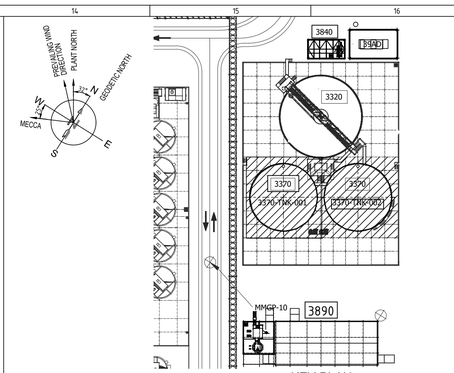


KEY PLAN
(SCALE 1:1000)

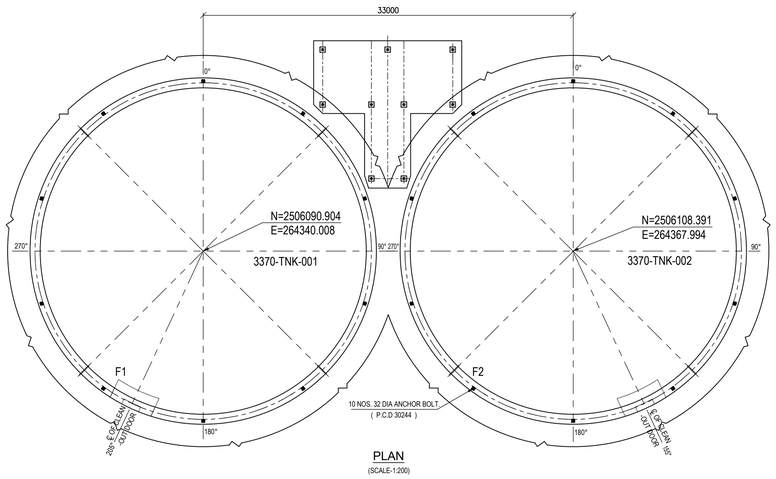


PLAN
(SCALE:-1:200)

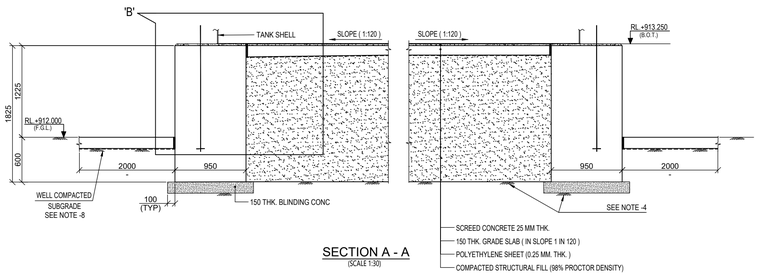


SECTION A - A
(SCALE 1:30)

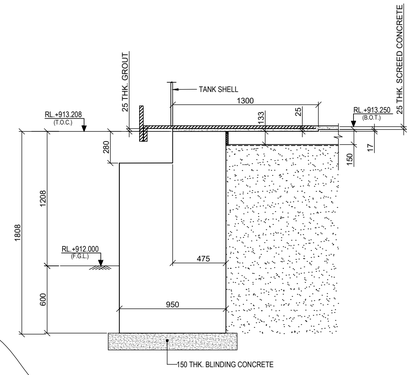


SECTION B-B
(SCALE 1:20)

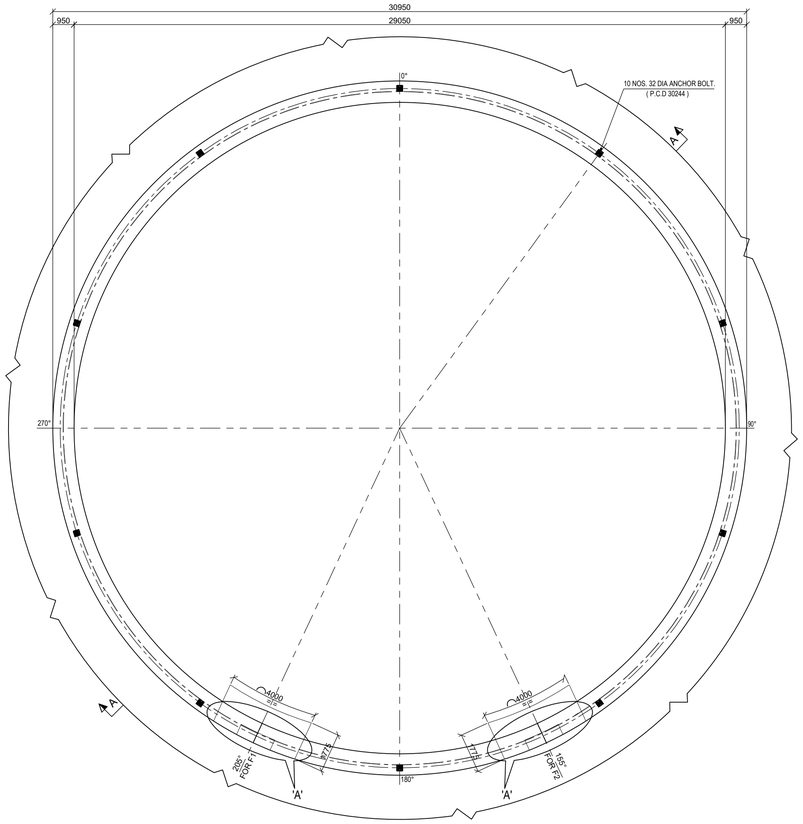


PLAN OF FDN. MKD. F1 & F2
(SCALE 1:100)

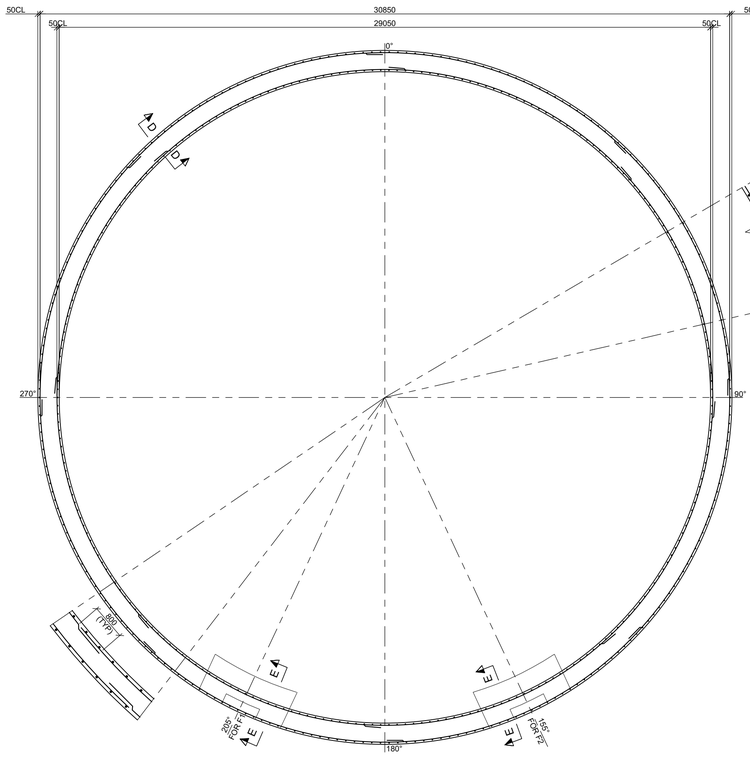


RC. PLAN OF FOUNDATION
(SCALE 1:100)

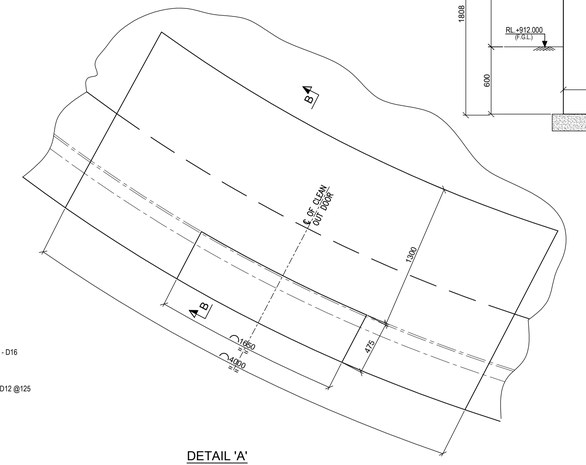

DETAIL 'A'
(SCALE 1:20)

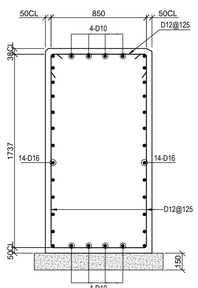

SECTION D-D
(SCALE 1:20)

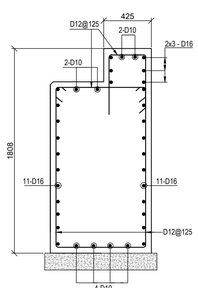

SECTION E-E
(SCALE 1:20)

LEGEND.:-

FLOT. - FLOTATION
HEX. - HEXAGONAL
PLT. - PLATE
T.O.C - TOP OF CONCRETE
F.G.L - FINISHED GROUND LEVEL
B.O.T - BOTTOM OF TANK
FDN. - FOUNDATION
TYP. - TYPICAL
RL. - REDUCED LEVEL
P.C.D - PITCHED CIRCLE DIAMETER
MKD. - MARKED
RC. - REINFORCED CONCRETE
DIA. - DIAMETER
℄ - CENTERLINE

NOTES:-

1. ALL DIMENSIONS ARE IN MILLIMETRES , LEVELS & COORDINATES ARE IN METRES UNLESS OTHERWISE STATED.
2. GRADE OF CONCRETE SHALL BE 35 MPa FOR WALL & 15 MPa FOR BLINDING CONCRETE.
3. GRADE OF REINFORCEMENT SHALL BE DEFORMED BAR 420 MPa (GRADE 60)) - ASTM A615/A615M.
4. NET SAFE BEARING CAPACITY AT THE FOUNDING LEVEL CONSIDERED 375KN / SQ. M
5. IF ANY PART OF FOUNDATION COMES ON BACKFILLED ZONE OF ADJACENT FOUNDATION OR ANY LOOSE POCKETS ARE ENCOUNTERED BELOW FOUNDATION LEVEL THE SAME SHALL BE REMOVED AND FILLED WITH PCC (15 MPa).
6. CLEAR COVER TO MAIN REINFORCEMENT SHALL BE WALLS - 50MM.
7. THE CONTENT OF THIS DRAWING SHALL CONFORM TO THE PROVISIONS OF CIVIL, STRUCTURAL AND ARCHITECTURAL DESIGN CRITERIA DOC. NO. MD-216-1000-EG-ST-CRT-1001.
8. 2M WIDE APRON OUTSIDE THE TANK FOUNDATION ABOVE COMPACTED FILLING TI BE CAST BEFORE INSIDE COMPACTION .
9. TOP OF SCREED / GRADE SLAB TOLERANCE SHALL BE WITHIN +/- 10MM OF DESIGN LEVEL.
*10. 100 MM GROUT TO BE PLACED FOR PLACEMENT OF SEALANT.
11. FOR BOLT EMBEDMENT AND PROJECTION LENGTH THIS DETAIL TO BE FOLLOWED. FOR OTHER INFORMATION REFER BOLT DRAWING NO MD-216-1000-EG-CV-DED-1003

DOCUMENT NUMBER	REFERENCE DOCUMENTS	REV	DATE	REVISION DESCRIPTION	DRN	CHK	ENG	APP	EMP
MD-216-1000-EG-CV-DED-1003	ANCHOR BOLTS STANDARD DETAILS.	D01	22/02/2023	AS-BUILT	AUD	SJM	AVG	AG	
MD-216-3370-EG-ST-GAD-1003	PLAN, ELEVATIONS & DETAILS OF ROOF	C03	17/03/2020	ISSUED FOR CONSTRUCTION & REVISED AS MKD.	AUD	SJM	AVG	AG	
MD-216-1000-EG-ST-CRT-1001	CIVIL, STRUCTURAL & ARCHITECTURAL - DESIGN CRITERIA	C02	10/03/2020	ISSUED FOR CONSTRUCTION & REVISED AS MKD. C02	AUD	SJM	AVG	AG	
MD-216-3370-EG-ME-GAD-1002	G.A. FLOTATION PROCESS WATER STORAGE TNK-002	C01	11/03/2020	ISSUED FOR CONSTRUCTION & REVISED AS MKD. C01	AUD	SJM	AVG	AG	
MD-216-3370-EG-ME-GAD-1001	G.A. FLOTATION PROCESS WATER STORAGE TNK-001	A01	13/01/2020	ISSUED FOR REFERENCE	AUD	SJM	AVG	AG	

RESERVED FOR VENDOR LOGO AND DRAWING NUMBER

LARSEN & TOUBRO

This drawing is the property of LARSEN & TOUBRO and must not be passed on to any person or body not authorised by us to receive it nor be copied or otherwise made use either in full or in part by such person or body without our prior permission in writing.

Outotec

The content of these documents are the sole property of Outotec Oyj. Any rights not expressly granted herein are reserved. Reproduction, transfer or distribution of part or all of the contents in any form without prior written permission of Outotec is prohibited.

MA'ADEN معادن
Saudi Arabian Mining Company شركة معادن السعودية للتعدين

This document and the information contained herein is Ma'aden proprietary know-how. This document or any part thereof should not be reproduced, stored in a retrieval system or transmitted by any means, electronic or otherwise, or divulged without prior written permission of Ma'aden.

LARSEN & TOUBRO DRAWING NUMBER	019045_450_C_G_24101_001		REVISION 4
OUTOTEC DRAWING NUMBER	900707__GAU01__AG01__MTL01__33703	DOCUMENT ID OU100667151	REVISION 4
DRAWN	AUD	03/01/2020	MANSOURAH - MASSARAH GOLD PROJECT
CHECKED	SJM	05/01/2020	GENERAL ARRANGEMENT DRAWING
ENGINEER	AVG	03/01/2020	FLOT. PROCESS WATER STORAGE & DISTRIBUTION
APPROVED	AG	13/01/2020	LAYOUT & DETAIL OF TANK FOUNDATIONS
EMPLOYER			
SCALE 1:100,20		A0	DRAWING NUMBER MD-216-3370-EG-CV-GAD-1232 REV D01