


DRAWING NUMBER: MD - 216 - 3380 - EG - CV - GAD - 1001 | REV: D01

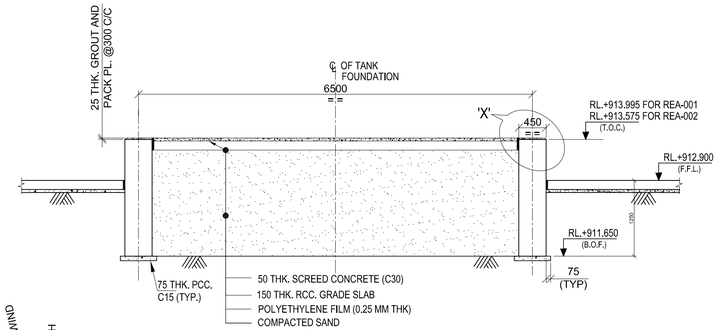


SECTION : A-A
SCALE 1:50

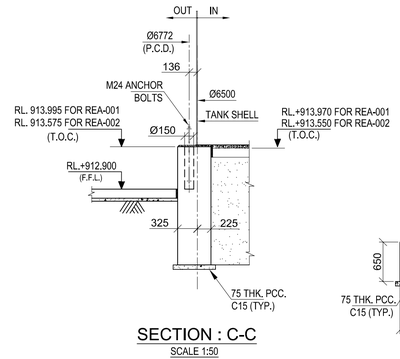


SECTION : C-C
SCALE 1:50

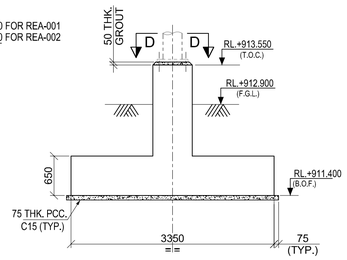


SECTION : B-B
SCALE 1:50

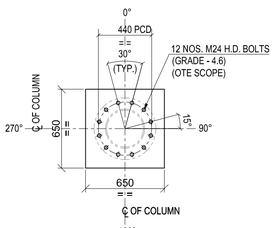


VIEW : D-D
(SCALE : 1:25)

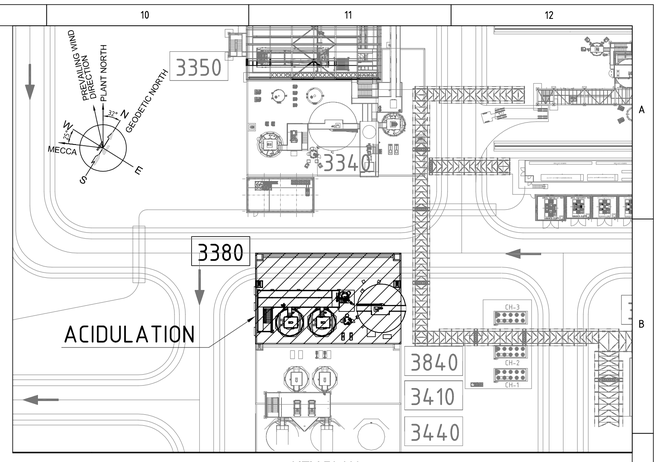


KEY PLAN
(SCALE- 1:750)

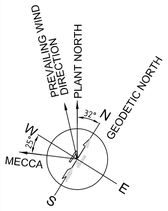


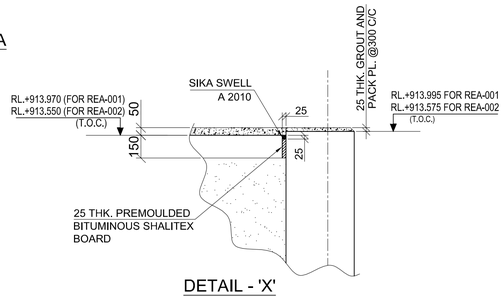


DETAIL - 'X'
SCALE 1:20

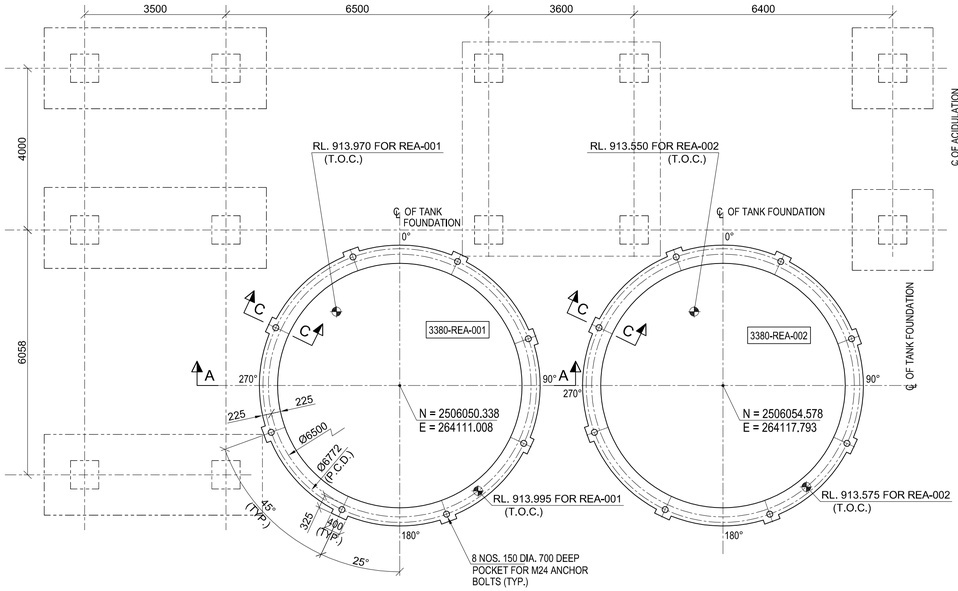

LAYOUT OF FOUNDATION
(SCALE - 1:75)

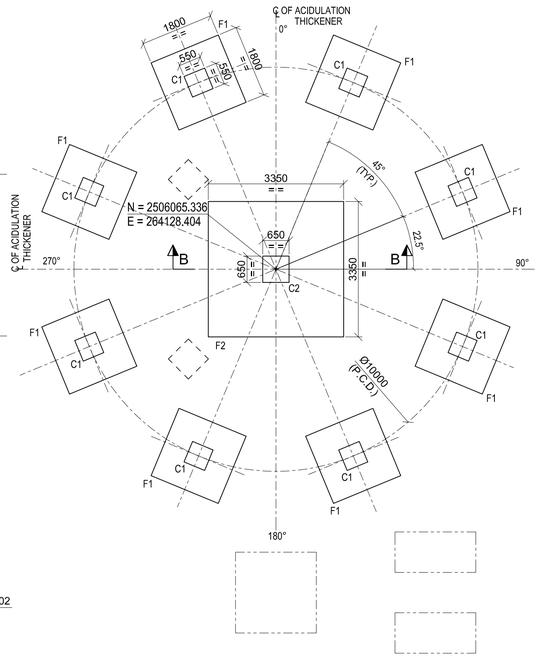

PLAN AT RL.+911.400 (B.O.F.)
(SCALE - 1:75)

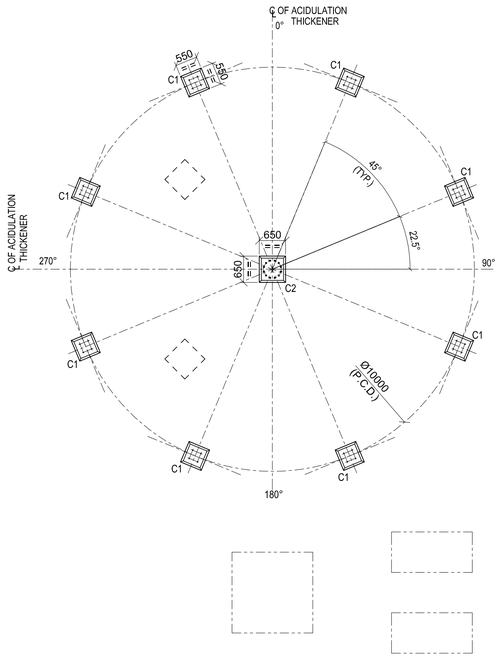

PLAN AT RL.+913.550 (T.O.C.)
(SCALE - 1:75)

LEGEND :-

R.L. - REDUCED LEVEL
T.O.C. - TOP OF CONCRETE.
F.G.L. - FINISHED GROUND LEVEL.
F.F.L. - FINISHED FLOOR LEVEL.
B.O.F. - BOTTOM OF FOUNDATION
TYP. - TYPICAL.
P.C.D. - PITCH CIRCLE DIAMETER.
P.C.C - PLAIN CEMENT CONCRETE
MKD. - MARKED.
THK. - THICK
EQV. - EQUIVALENT
PL. - PLATE
DIA - DIAMETER
℄ - CENTRE LINE
H.D. - HOLDING DOWN

NOTES :-

1. ALL DIMENSIONS ARE IN MILLIMETRES AND LEVELS AND CO-ORDINATES ARE IN METRES. UNLESS OTHERWISE STATED.
2. GRADE OF CONCRETE SHALL BE C35 FOR FOUNDATION.
3. GRADE OF REINFORCEMENT SHALL BE DEFORMED BAR ASTM A615 - GRADE 60 (fy = 420 MPa).
4. NET SAFE BEARING CAPACITY OF SOIL AT BOTTOM OF FOUNDATION CONSIDERED 400KN/SQ. M.
5. IF ANY PART OF FOUNDATION COMES ON BACKFILL ZONE OF ADJACENT FOUNDATION OR ANY LOOSE SOIL ARE ENCOUNTERED BELOW FOUNDATION LEVEL THE SAME SHALL BE REMOVED AND FILLED WITH PCC.
6. THIS DRG. SHALL BE READ IN CONJUNCTION WITH DRAWING NO. MD-216-3380-EG-CV-GAD-1002.
7. THE CONTENT OF THIS DRAWING SHALL CONFORM TO THE PROVISIONS OF CIVIL, STRUCTURAL AND ARCHITECTURAL DESIGN CRITERIA DOCUMENT NO. MD-216-1000-EG-ST-CRT-1001.

DOCUMENT NUMBER	REFERENCE DOCUMENTS			REVISION DESCRIPTION	DRN	CHK	ENG	APP	EMP
		D01	25/1/2023	AS BUILT	PML	SJM	SOR	AG	
		C04	26/09/2020	ISSUED FOR CONSTRUCTION & REVISED AS MARKED C04	PML	SJM	SOR	AG	
		C03	19/05/2020	ISSUED FOR CONSTRUCTION & REVISED AS MARKED C03	SYA	SJM	SOR	AG	
MD-216-3380-EG-ME-GAD-1014	3380-REA-002 ACIDULATION REACTOR	C02	18/03/2020	ISSUED FOR CONSTRUCTION & REVISED AS MARKED C02	SYA	SJM	SOR	AG	
MD-216-3380-EG-ME-GAD-1013	3380-REA-001 ACIDULATION REACTOR	C01	21/02/2020	ISSUED FOR CONSTRUCTION & REVISED AS PER EMPLOYER	SYA	SJM	SOR	AG	
MD-216-3380-EG-ME-GAD-1002	3380-THK-001 T40-ACIDULATION THK. 12m			COMMENTS ON 14/02/2020					
MD-216-3380-EG-ME-PLN-1001	3380-REA-001,002 ACIDULATION REACTOR	A01	04/01/2020	ISSUED FOR REFERENCE	ABS	SJM	SOR	AG	

RESERVED FOR VENDOR LOGO AND DRAWING NUMBER

LARSEN & TOUBRO

This drawing is the property of LARSEN & TOUBRO and must not be passed on to any person or body not authorized by us to receive. It nor be copied or otherwise made use either in full or in part by such person or body without our prior permission in writing.

Outotec

The content of these documents are the sole property of Outotec Oy. Any rights not expressly granted herein are reserved. Reproduction, transfer or distribution of part or all of the contents in any form without prior written permission of Outotec is prohibited.

MA'ADEN معادن
Saudi Arabian Mining Company شركة التعدين العربية السعودية

This document and the information contained herein is Ma'aden proprietary know-how. This document or any part thereof should not be reproduced, stored in a retrieval system or transmitted by any means, electronic or otherwise, or divulged without prior written permission of Ma'aden.

LARSEN & TOUBRO DRAWING NUMBER: 019045_450_C_G_24530_001 | REVISION: 5
OUTOTEC DRAWING NUMBER: 900707 __GAU01 __HL15 __MTL01 __33801 | DOCUMENT ID: OU100668032 | REVISION: 5

DRAWN	ABS	20/12/2019
CHECKED	SJM	03/01/2020
ENGINEER	SOR	02/01/2020
APPROVED	AG	04/01/2020
EMPLOYER		
SCALE	1:75, 1:50, 1:25, 1:10	A1

MANSOURAH - MASSARAH GOLD PROJECT
GENERAL ARRANGEMENT DRAWING
ACIDULATION
LAYOUT & DETAIL OF FOUNDATION

DRAWING NUMBER: MD - 216 - 3380 - EG - CV - GAD - 1001 | REV: D01