




VIEW : D-D
(SCALE: 1:25)

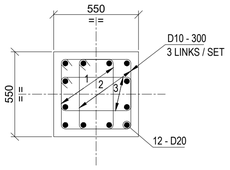


RCC. DET. OF C1
SCALE 1:20

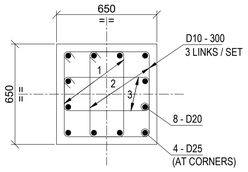


RCC. DET. OF C2
SCALE 1:20

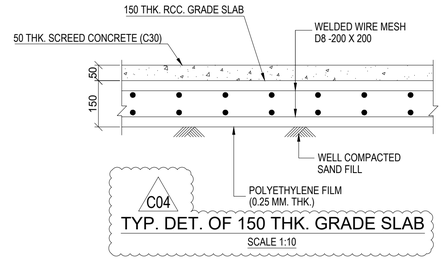


TYP. DET. OF 150 THK. GRADE SLAB
SCALE 1:10

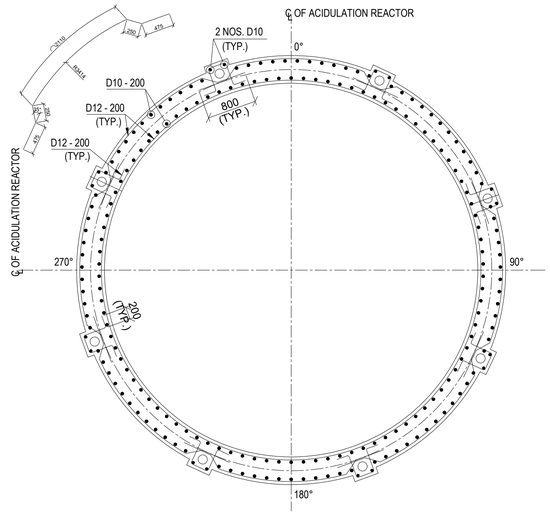


RCC. DET. OF TANK FOUNDATION AT TOP
(FOR ACIDULATION REACTOR MKD. REA-001 & REA-002)
SCALE 1:50

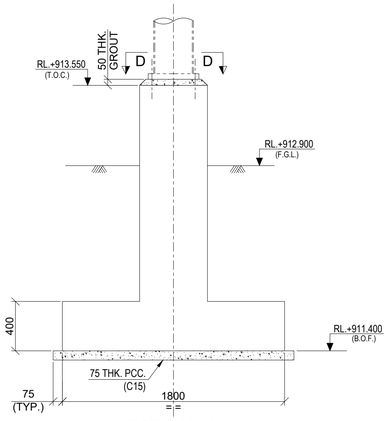


SECTION : A-A
SCALE 1:25

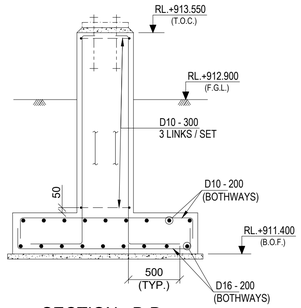


SECTION : B-B
SCALE 1:30

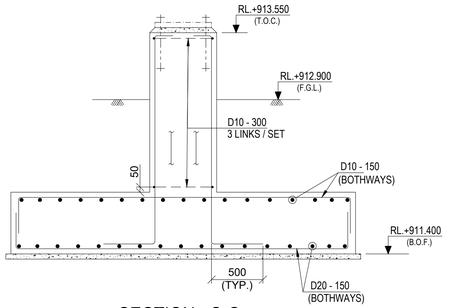


SECTION : C-C
SCALE 1:30

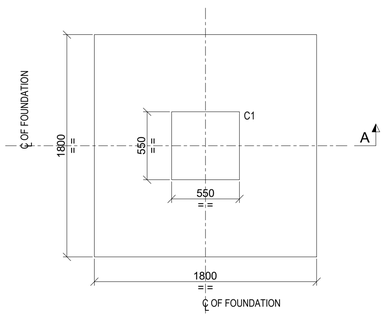


DETAIL OF FOUNDATION MKD. F1
(SCALE - 1:25)

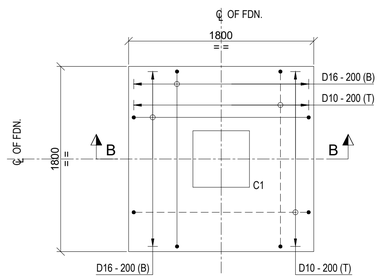


RCC. DET. OF FOUNDATION
MKD. F1
SCALE 1:30

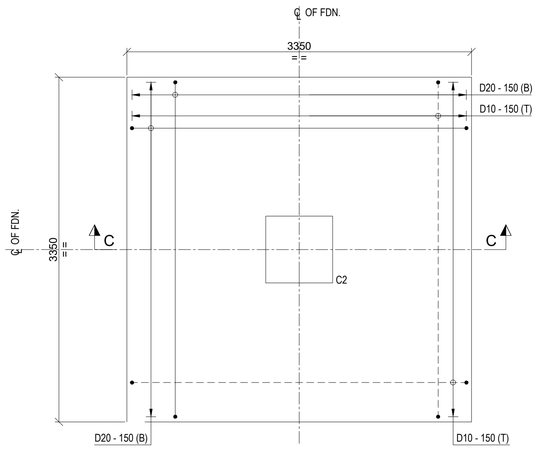

RCC. DET. OF FOUNDATION
MKD. F2
SCALE 1:30

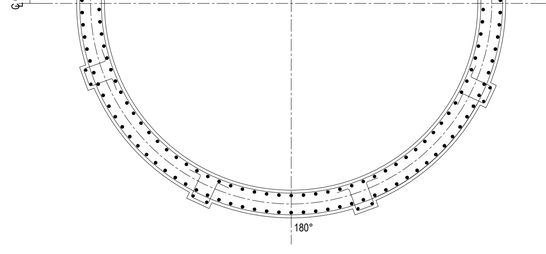

RCC. DET. OF TANK FOUNDATION AT BOTTOM
(FOR ACIDULATION REACTOR MKD. REA-001 & REA-002)
SCALE 1:50

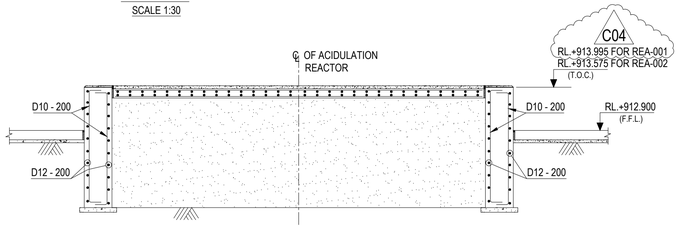

SECTION : E-E
SCALE 1:50

LEGEND :-

R.L. - REDUCED LEVEL
T.O.C. - TOP OF CONCRETE.
F.G.L. - FINISHED GROUND LEVEL.
B.O.F. - BOTTOM OF FOUNDATION
TYP. - TYPICAL.
P.C.D. - PITCH CIRCLE DIAMETER.
P.C.C. - PLAIN CEMENT CONCRETE
BOTTOM REINF.(B) - ————
TOP REINF.(T) - – – – – –
MKD. - MARKED.
THK. - THICK
PL. - PLATE
DIA - DIAMETER
℄ - CENTRE LINE
H.D. - HOLDING DOWN
FDN. - FOUNDATION
RCC - REINFORCED CEMENT CONCRETE

NOTES :-

1. ALL DIMENSIONS ARE IN MILLIMETRES AND LEVELS AND CO-ORDINATES ARE IN METRES. UNLESS OTHERWISE STATED.
2. GRADE OF CONCRETE SHALL BE C35 FOR FOUNDATION.
3. GRADE OF REINFORCEMENT SHALL BE DEFORMED BAR ASTM A615 - GRADE 60 (fy = 420 MPa).
4. NET SAFE BEARING CAPACITY OF SOIL AT BOTTOM OF FOUNDATION CONSIDERED 400KN/SQ. M.
5. CLEAR COVER TO MAIN REINFORCEMENT SHALL BE AS
   a) FOUNDATION = 75 mm (BOTTOM & SIDE) 50 mm. (TOP)
   b) COLUMN = 50mm
6. MINIMUM LAP LENGTH OF REINFORCEMENT SHALL BE 40 x DIA. OF BAR.
7. THIS DRAWING SHALL BE READ IN CONJUNCTION WITH DRAWING NO. MD-216-3380-EG-CV-GAD-1001.

DOCUMENT NUMBER	REFERENCE DOCUMENTS	REV	DATE	REVISION DESCRIPTION	DRN	CHK	ENG	APP	EMP
		D01	18/04/2023	AS-BUILT	SYA	SJM	SOR	AG	
		C04	26/09/2020	ISSUED FOR CONSTRUCTION & REVISED AS MARKED C04	PML	SJM	SOR	AG	
		C03	19/05/2020	ISSUED FOR CONSTRUCTION & REVISED AS MARKED C03	SYA	SJM	SOR	AG	
MD-216-3380-EG-ME-GAD-1014	3380-REA-002 ACIDULATION REACTOR	C02	18/03/2020	ISSUED FOR CONSTRUCTION & REVISED AS MARKED C02	SYA	SJM	SOR	AG	
MD-216-3380-EG-ME-GAD-1013	3380-REA-001 ACIDULATION REACTOR	C01	21/02/2020	ISSUED FOR CONSTRUCTION & REVISED AS PER EMPLOYER	SYA	SJM	SOR	AG	
MD-216-3380-EG-ME-GAD-1002	3380-THK-001 T40-ACIDULATION THK. 12m			COMMENTS ON 14/02/2020					
MD-216-3380-EG-ME-PLN-1001	3380-REA-001 ACIDULATION REACTOR	A01	04/01/2020	ISSUED FOR REFERENCE	ABS	SJM	SOR	AG	

RESERVED FOR VENDOR LOGO AND DRAWING NUMBER

LARSEN & TOUBRO
This drawing is the property of *LARSEN & TOUBRO* and must not be passed on to any person or body not authorized by us to receive it nor be copied or otherwise made use either in full or in part by such person or body without our prior permission in writing.

Outotec
The content of these documents are the sole property of Outotec Oyj. Any rights not expressly granted herein are reserved. Reproduction, transfer or distribution of part or all of the contents in any form without prior written permission of Outotec is prohibited.

MA'ADEN معادن
Saudi Arabian Mining Company شركة التعدين العربية السعودية
This document and the information contained herein is Ma'aden proprietary know-how. This document or any part thereof should not be reproduced, stored in a retrieval system or transmitted by any means, electronic or otherwise, or divulged without prior written permission of Ma'aden.

LARSEN & TOUBRO DRAWING NUMBER	O19045_450_C_G_24530_002		REVISION 5
OUTOTEC DRAWING NUMBER	900707 _GAU01 _HL15 _MTL01 _33802	DOCUMENT ID OU100668033	REVISION 5

DRAWN	ABS	20/12/2019
CHECKED	SJM	03/01/2020
ENGINEER	SOR	02/01/2020
APPROVED	AG	04/01/2020
EMPLOYER		
SCALE	1:50, 1:30, 1:25, 1:20	A1

MANSOURAH - MASSARAH GOLD PROJECT
GENERAL ARRANGEMENT DRAWING
ACIDULATION
G.A. & RCC. DETAIL OF FOUNDATION

DRAWING NUMBER MD-216-3380-EG-CV-GAD-1002 REV D01