MA'ADEN معادن
Saudi Arabian Mining Company شركة التعدين العربية السعودية

Project **Mansourah Massarah Gold Project**
Customer: **MA'ADEN GOLD AND BASE METALS (MA'ADEN)**

Title: **GENERAL ARRANGEMENT DRAWING**
ACIDULATION BUILDING
GA & DETAILS OF GRADE SLAB


Document Number: **MD-216-3380-EG-CV-GAD-1003**
Revision: **D01**
Revision Date: **10.03.2023**
Status: **ASBUILT**

Outotec Document Number:	900707	GAU01	HL15	MTL01	33803	OU100668034	5
L&T Document Number:	O19045	450	C	G	24530	003	5


REVISION HISTORY

Rev	Date	Revision Text	Prepared By	Reviewed By	Approved By	Employer
A01	20.10.2020	FIRST ISSUE	SOR	SJM	AG	
C01	11.12.2020	ISSUED FOR CONSTRUCTION	SOR	SJM	AG	
C02	29.01.2021	ISSUED FOR CONSTRUCTION AND REVISED AS MARKED △C02	SOR	SJM	AG	
C03	15.02.2021	ISSUED FOR CONSTRUCTION AND REVISED AS MARKED △C03	SOR	SJM	AG	
C04	11.03.2021	ISSUED FOR CONSTRUCTION AND REVISED AS MARKED △C04	SOR	SJM	AG	
D01	10.03.2023	AS BUILT	SOR	SJM	AG	


DRAWING NUMBER: MD-216-3380-EG-CV-GAD-1003 | REV: D01

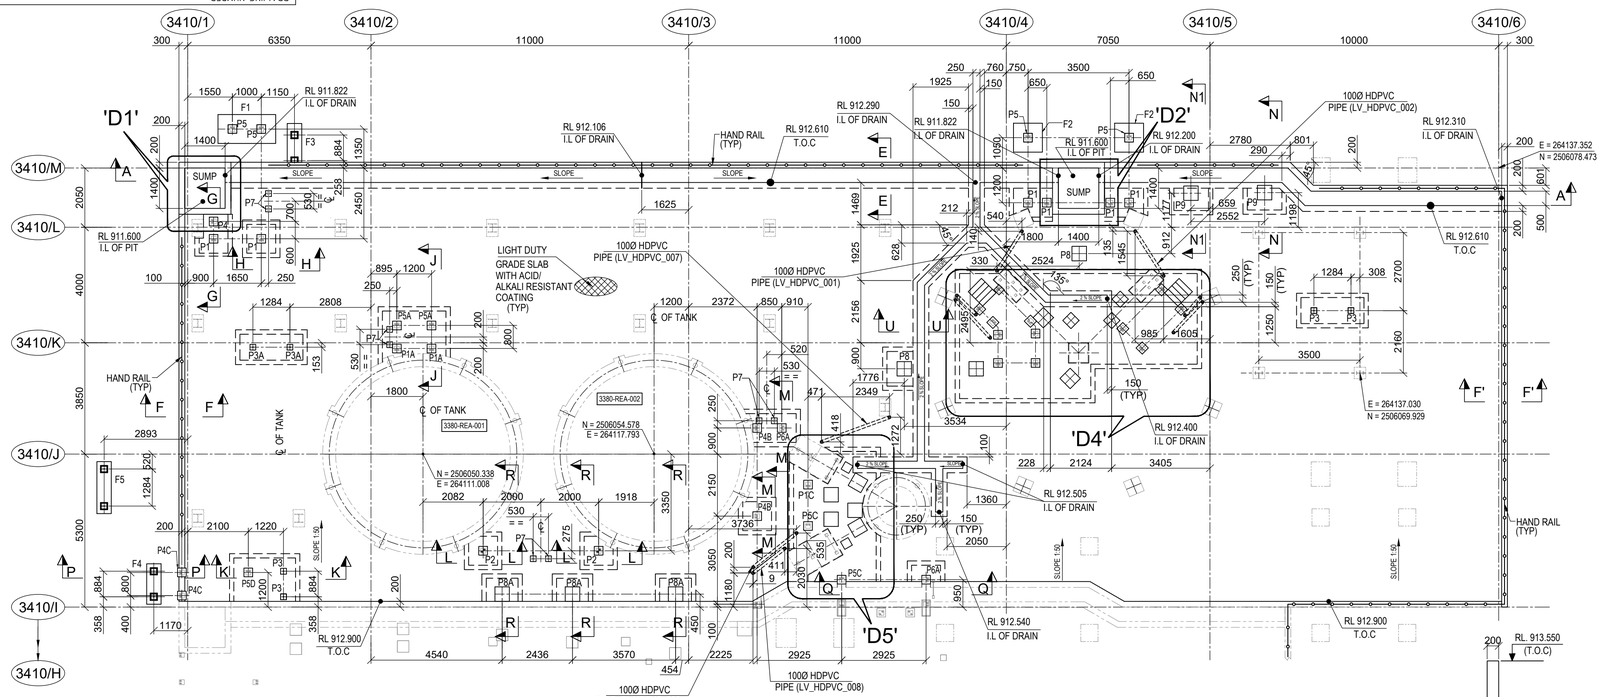


LAYOUT OF GRADE SLAB
(SCALE - 1:100)

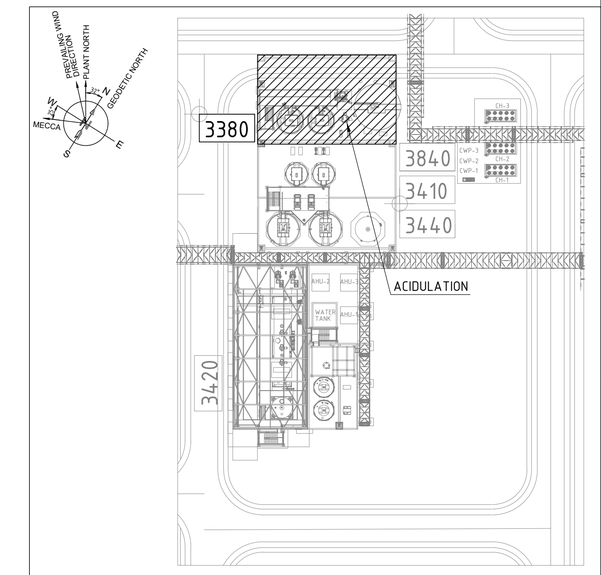


KEY PLAN
(SCALE- 1:750)

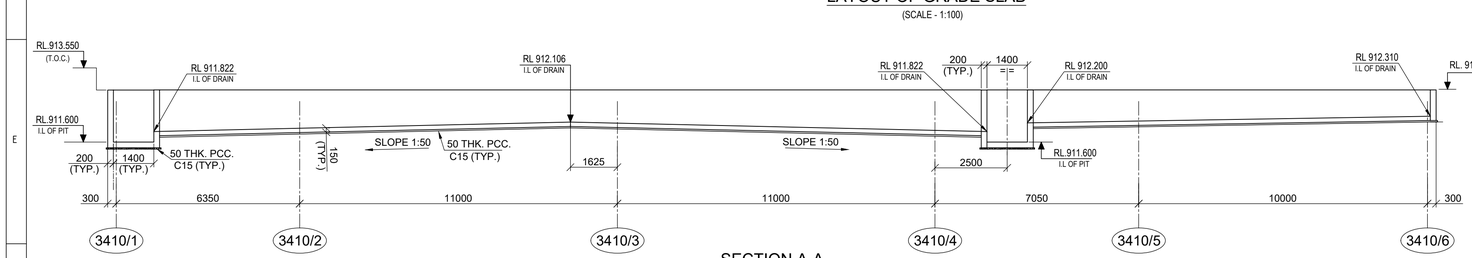


SECTION A-A
SCALE 1:100

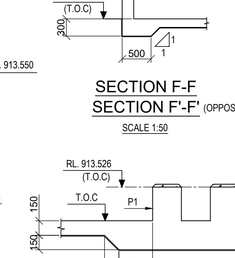

SECTION F-F
SECTION F'-F' (OPPOSITE HAND)
SCALE 1:50

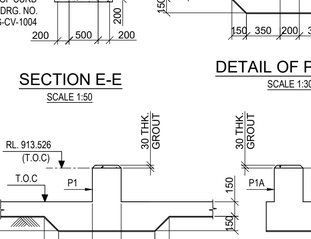


DETAIL OF P3, P3A
SCALE 1:30

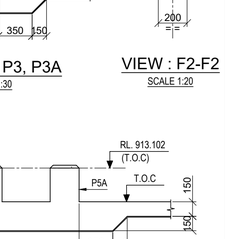


VIEW : F2-F2
SCALE 1:20

SECTION E-E
SCALE 1:50

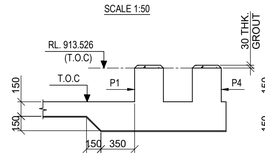


SECTION G-G
SCALE 1:30

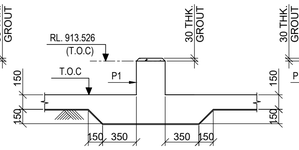


SECTION H-H
SCALE 1:30


SECTION J-J
SCALE 1:30

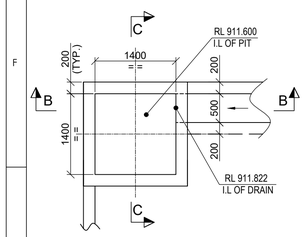


DETAIL-D1
SCALE 1:50

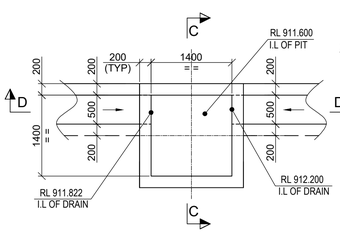


DETAIL-D2
SCALE 1:50

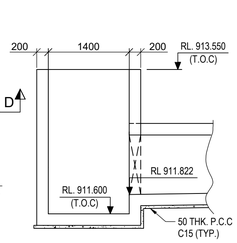


SECTION B-B
SCALE 1:50

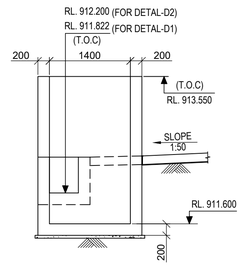


SECTION C-C
SCALE 1:50

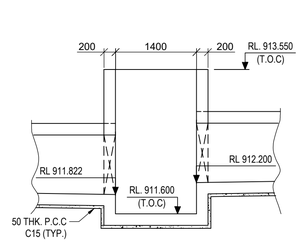

SECTION D-D
SCALE 1:50

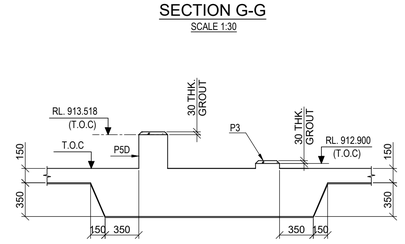

SECTION K-K
SCALE 1:30

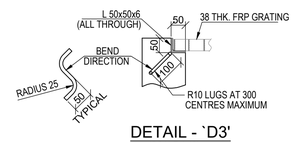

DETAIL - `D3'
(SCALE 1:10)
(TYPICAL)

LEGEND :-

R.L. - REDUCED LEVEL
I.L - INVERT LEVEL
THK. - THICK
TYP. - TYPICAL
T.O.C - TOP OF CONCRETE
℄ - CENTRE LINE
P.C.C - PLAIN CEMENT CONCRETE
DIA - DIAMETER
MKD. - MARKED
Ø - DIAMETER

NOTES:-

1. ALL DIMENSIONS ARE IN MILLIMETRES AND LEVELS AND CO-ORDINATES ARE IN METRES UNLESS OTHERWISE STATED.
2. FOR DETAILS OF GRADE SLAB REFER DRAWING NO. MD-216-1000-EG-CV-DED-1002.
3. FOR REINFORCEMENT DETAIL REFER DRAWING NO. MD-216-3380-EG-CV-DED-1001.

DOCUMENT NUMBER	REFERENCE DOCUMENTS	REV	DATE	REVISION DESCRIPTION	DRN	CHK	ENG	APP	EMP
		D01	10/03/2023	AS-BUILT	PML	SJM	SOR	AG	
		C04	11/03/2021	ISSUED FOR CONSTRUCTION AND REVISED AS MARKED C04	PML	SJM	SOR	AG	
MD-216-3400-EG-EL-LAD-1001	PRESSURE OXIDATION	C03	15/02/2021	ISSUED FOR CONSTRUCTION AND REVISED AS MARKED C03	PML	SJM	SOR	AG	
	CABLE ROUTE LAYOUT	C02	29/01/2021	ISSUED FOR CONSTRUCTION AND REVISED AS MARKED C02	PML	SJM	SOR	AG	
MD-216-3420-EG-ME-GAD-1011	PRESSURE OXIDATION - FEED STORAGE	C01	11/12/2020	ISSUED FOR CONSTRUCTION AND REVISED AS MARKED C01	PML	SJM	SOR	AG	
	PLAN AT EL. +912.900	A01	20/10/2020	ISSUED FOR REFERENCE	PML	SJM	SOR	AG	

RESERVED FOR VENDOR LOGO AND DRAWING NUMBER

LARSEN & TOUBRO DRAWING NUMBER: 019045_450_C_G_24530_003 | REVISION: 5
OUTOTEC DRAWING NUMBER: 900707__GAU01__HL15__MTL01__33803 | DOCUMENT ID: 0U100668034 | REVISION: 5


LARSEN & TOUBRO
This drawing is the property of LARSEN & TOUBRO and must not be passed on to any person or body not authorized by us to receive it nor be copied or otherwise made use either in full or in part by such person or body without our prior permission in writing.

Outotec
The content of these documents are the sole property of Outotec Oy). Any rights not expressly granted herein are reserved. Reproduction, transfer or distribution of part or all of the contents in any form without prior written permission of Outotec is prohibited.


MA'ADEN معادن
Saudi Arabian Mining Company شركة التعدين العربية السعودية
This document and the information contained herein is Ma'aden proprietary know-how. This document or any part thereof should not be reproduced, stored in a retrieval system or transmitted by any means, electronic or otherwise, or divulged without prior written permission of Ma'aden.

DRAWN	PML	14/10/2020	MANSOURAH - MASSARAH GOLD PROJECT
CHECKED	SJM	16/10/2020	GENERAL ARRANGEMENT DRAWING
ENGINEER	SOR	14/10/2020	ACCIDULATION BUILDING
APPROVED	AG	20/10/2020	GA & DETAILS OF GRADE SLAB (SHEET 1 OF 2)
EMPLOYER			
SCALE 1:100, 1:50		A1	DRAWING NUMBER: MD-216-3380-EG-CV-GAD-1003 | REV: D01


DRAWING NUMBER MD-216-3380-EG-CV-GAD-1003 REV D01

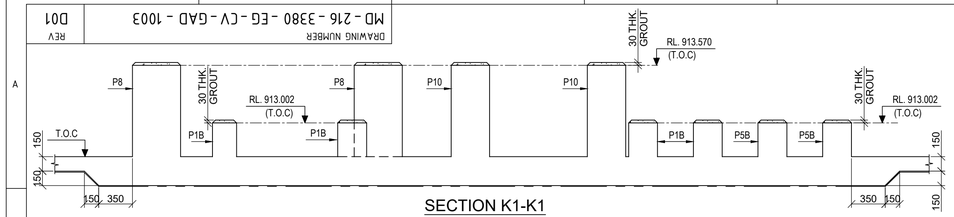


SECTION K1-K1
SCALE 1:30

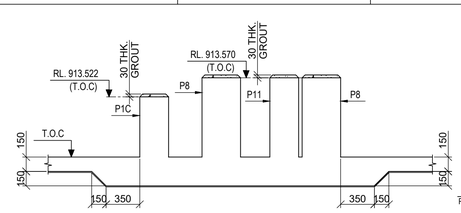


SECTION K2-K2
SCALE 1:30

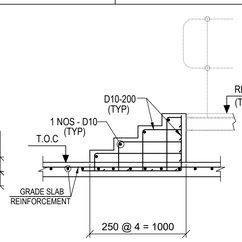


SECTION K3-K3
SCALE 1:30

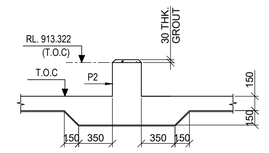


SECTION L-L
SCALE 1:30

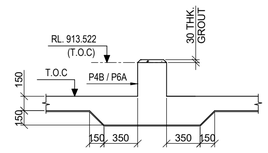

SECTION M-M
SCALE 1:30

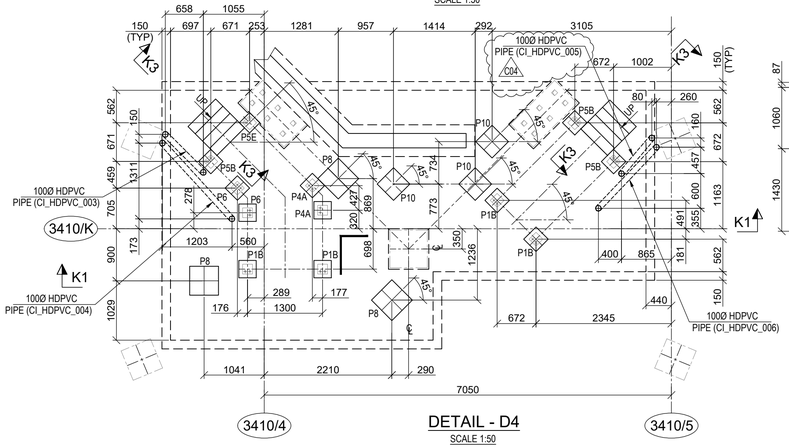


DETAIL - D4
SCALE 1:50

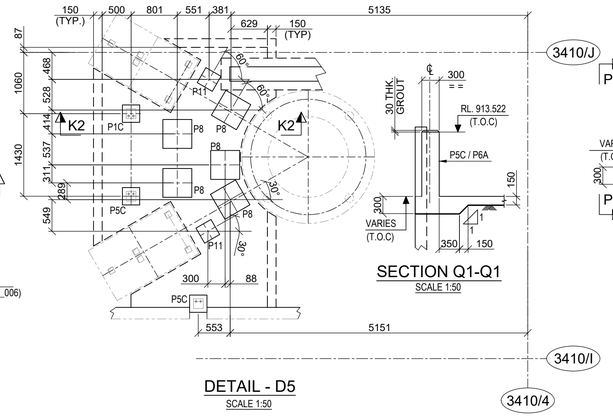


DETAIL - D5
SCALE 1:50


SECTION Q1-Q1
SCALE 1:50

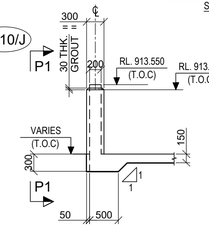


SECTION P-P
SCALE 1:50

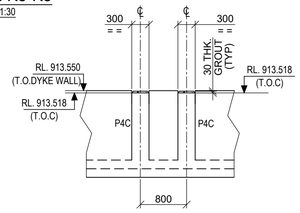


SECTION P1-P1
SCALE 1:50

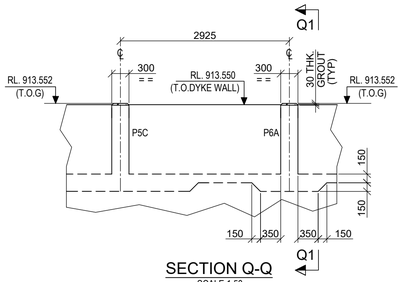


SECTION Q-Q
SCALE 1:50

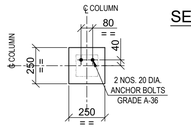


TOP PLAN OF PEDESTAL MKD. P5E
SCALE 1:20

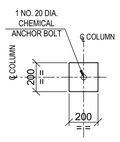


VIEW : F1-F1
SCALE 1:20

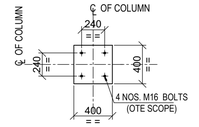


TOP PLAN OF PEDESTAL MKD. P10
SCALE 1:30

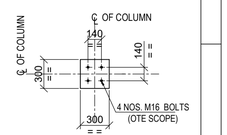


TOP PLAN OF PEDESTAL MKD. P11
SCALE 1:30

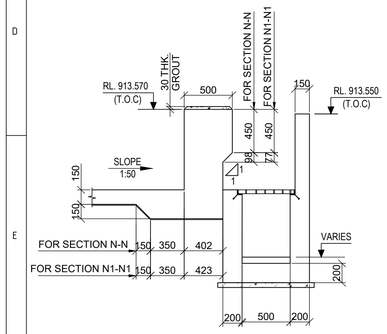


SECTION N-N & N1-N1
SCALE 1:30

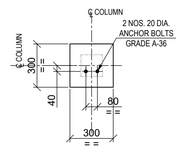


TOP PLAN OF PEDESTAL MKD. P1,P1A,P1B,P1C
SCALE 1:20

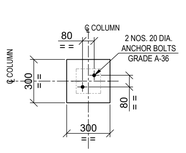


TOP PLAN OF PEDESTAL MKD. P2
SCALE 1:20

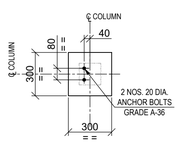


TOP PLAN OF PEDESTAL MKD. P4,P4A,P4B,P4C
SCALE 1:20

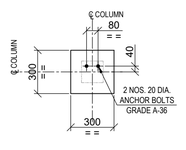


TOP PLAN OF PEDESTAL MKD. P5,P5A,P5B,P5C,P5D
SCALE 1:20

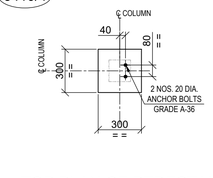


TOP PLAN OF PEDESTAL MKD. P6,P6A
SCALE 1:20

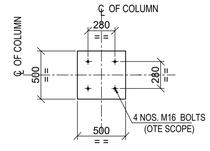


TOP PLAN OF PEDESTAL MKD. P8,P8A,P9
SCALE 1:30

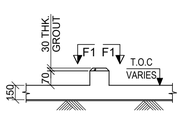


DETAIL OF P7
SCALE 1:30

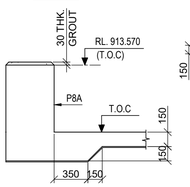


SECTION R-R
SCALE 1:30

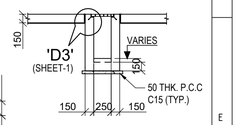


SECTION U-U
SCALE 1:50

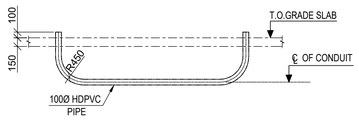


TYPICAL DETAIL OF CONDUIT
SCALE 1:50

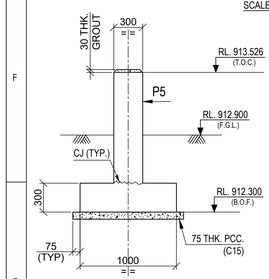


SECTION S-S
SCALE 1:30

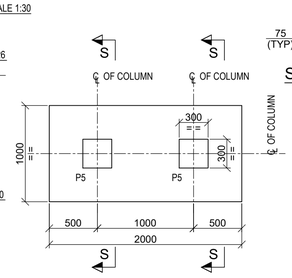


DETAIL OF FOUNDATION MKD F1
(1 NO REQUIRED)
SCALE 1:30

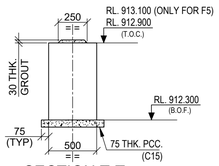


SECTION T-T
SCALE 1:30

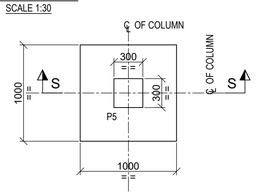


DETAIL OF FOUNDATION MKD F2
(2 NOS REQUIRED)
SCALE 1:30

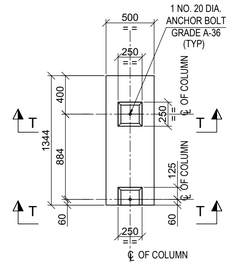

DETAIL OF FOUNDATION MKD F3
(1 NO REQUIRED)
SCALE 1:30

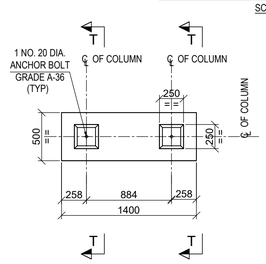

DETAIL OF FOUNDATION MKD F4
(1 NO REQUIRED)
SCALE 1:30

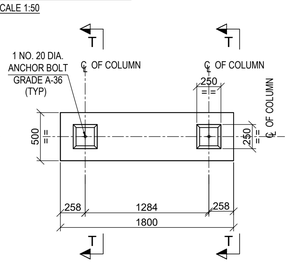

DETAIL OF FOUNDATION MKD F5
(1 NO REQUIRED)
SCALE 1:30

SCHEDULE OF CONDUIT :-

CONDUIT MKD.	ELEVATION AT ℄ OF CONDUIT
LV_HDPVC_001	RL 912.050
LV_HDPVC_002	RL 912.100
CI_HDPVC_003	RL 912.100
CI_HDPVC_004	RL 912.100
CI_HDPVC_005	RL 912.100
CI_HDPVC_006	RL 912.150
LV_HDPVC_007	RL 912.270
LV_HDPVC_008	RL 912.350
CI_HDPVC_009	RL 912.350

LEGEND :-

R.L. - REDUCED LEVEL
I.L - INVERT LEVEL
THK. - THICK
TYP. - TYPICAL.
T.O.C - TOP OF CONCRETE
℄ - CENTRE LINE
P.C.C - PLAIN CEMENT CONCRETE
DIA - DIAMETER
MM - MILLIMETRE
CJ - CONSTRUCTION JOINT
MKD. - MARKED
T.O.G - TOP OF GROUT
Ø - DIAMETER

PEDESTAL MKD.	T.O.C	GROUT THK.
P1,P4,P5	RL. 913.526	30 MM
P1A,P5A	RL. 913.102	30 MM
P1C,P5C, P4B,P6A	RL. 913.522	30 MM
P2	RL. 913.322	30 MM
P3	RL. 912.900	30 MM
P1B,P4A, P5B,P5E P6	RL. 913.002	30 MM
P5D,P4C	RL. 913.518	30 MM
P8,P8A, P9,P10 P11	RL. 913.570	30 MM

NOTES:-

1. ALL DIMENSIONS ARE IN MILLIMETRES AND LEVELS AND CO-ORDINATES ARE IN METRES UNLESS OTHERWISE STATED.
2. FOR DETAILS OF GRADE SLAB REFER DRAWING NO. MD-216-1000-EG-CV-DED-1002.
3. FOR REINFORCEMENT DETAIL REFER DRAWING NO. MD-216-3380-EG-CV-DED-1001.

DOCUMENT NUMBER	REFERENCE DOCUMENTS	REV	DATE	REVISION DESCRIPTION	DRN	CHK	ENG	APP	EMP
		D01	10/03/2023	AS-BUILT	PML	SJM	SOR	AG	
		C04	11/03/2021	ISSUED FOR CONSTRUCTION AND REVISED AS MARKED C04	PML	SJM	SOR	AG	
MD-216-3400-EG-EL-LAD-1001	PRESSURE OXIDATION	C03	15/02/2021	ISSUED FOR CONSTRUCTION AND REVISED AS MARKED C03	PML	SJM	SOR	AG	
	CABLE ROUTE LAYOUT	C02	29/01/2021	ISSUED FOR CONSTRUCTION AND REVISED AS MARKED C02	PML	SJM	SOR	AG	
MD-216-3420-EG-ME-GAD-1011	PRESSURE OXIDATION - FEED STORAGE	C01	11/12/2020	ISSUED FOR CONSTRUCTION AND REVISED AS MARKED C01	PML	SJM	SOR	AG	
	PLAN AT EL. +912.900	A01	20/10/2020	ISSUED FOR REFERENCE	PML	SJM	SOR	AG	

RESERVED FOR VENDOR LOGO AND DRAWING NUMBER

LARSEN & TOUBRO
This drawing is the property of LARSEN & TOUBRO and must not be passed on to any person or body not authorized by us to receive it nor be copied or otherwise made use either in full or in part by such person or body without our prior permission in writing.

Outotec
The content of these documents are the sole property of Outotec Oy. Any rights not expressly granted herein are reserved. Reproduction, transfer or distribution of part or all of the contents in any form without prior written permission of Outotec is prohibited.

MA'ADEN معادن
Saudi Arabian Mining Company شركة معادن العربية السعودية
This document and the information contained herein is Ma'aden proprietary know-how. This document or any part thereof should not be reproduced, stored in a retrieval system or transmitted by any means, electronic or otherwise, or divulged without prior written permission of Ma'aden.

LARSEN & TOUBRO DRAWING NUMBER 019045_450_C_G_24530_003 — REVISION 5
OUTOTEC DRAWING NUMBER 900707__GAU01__HL15__MTL01__33803 — DOCUMENT ID 0U100668034 — REVISION 5

DRAWN	PML	14/10/2020
CHECKED	SJM	16/10/2020
ENGINEER	SOR	14/10/2020
APPROVED	AG	20/10/2020
EMPLOYER		
SCALE	1:100, 1:50	A1

MANSOURAH - MASSARAH GOLD PROJECT
GENERAL ARRANGEMENT DRAWING
ACCIDULATION BUILDING
GA & DETAILS OF GRADE SLAB (SHEET 2 OF 2)

DRAWING NUMBER MD-216-3380-EG-CV-GAD-1003 — REV D01