

DRAWING NUMBER: MD - 216 - 3380 - EG - CV - GAD - 1005
REV: D01

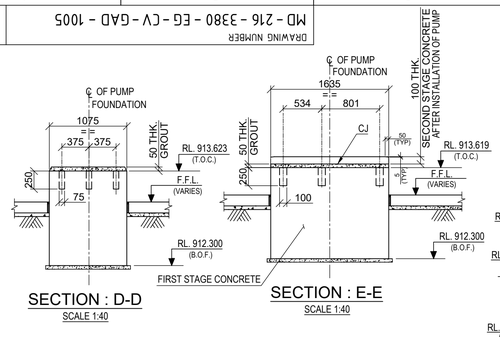


SECTION : D-D
SCALE 1:40


SECTION : E-E
SCALE 1:40

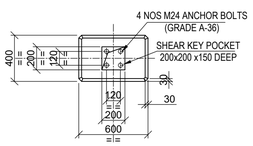


VIEW X-X
FOR COLUMN MKD. P1
SCALE 1:25

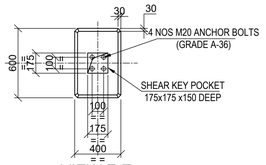


VIEW Z-Z
FOR COLUMN MKD. P2
SCALE 1:25

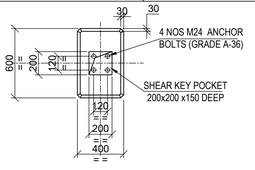


VIEW Y-Y
FOR COLUMN MKD. P1
SCALE 1:25

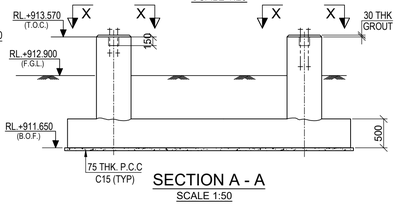


SECTION A - A
SCALE 1:50

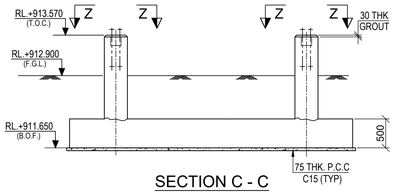


SECTION C - C
SCALE 1:50

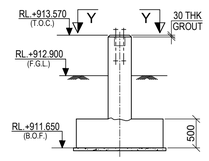


SECTION B - B
SCALE 1:50

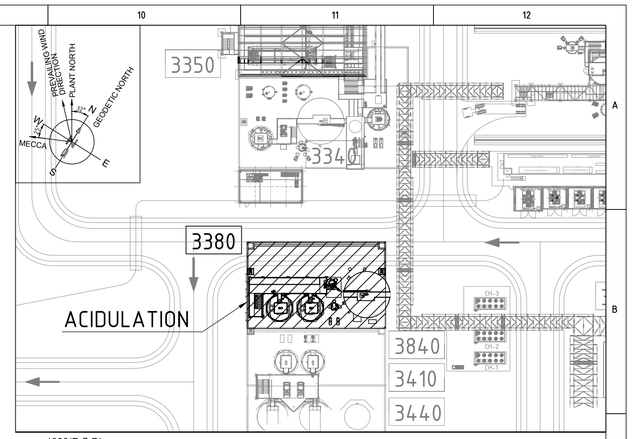


KEY PLAN
(SCALE- 1:750)

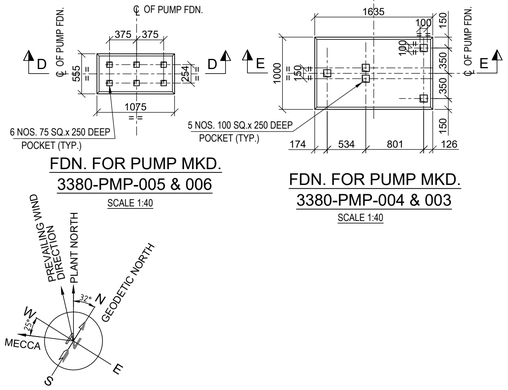


FDN. FOR PUMP MKD.
3380-PMP-005 & 006
SCALE 1:40

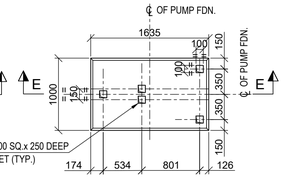


FDN. FOR PUMP MKD.
3380-PMP-004 & 003
SCALE 1:40

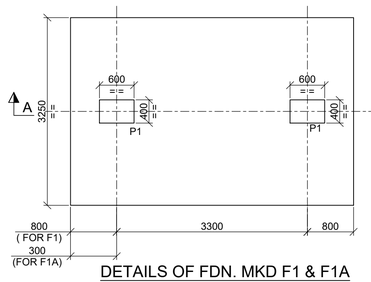


DETAILS OF FDN. MKD F1 & F1A
SCALE 1:50

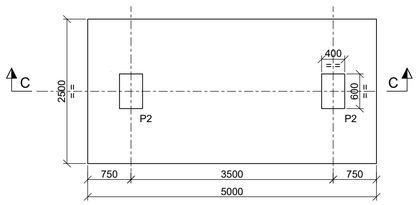


DETAILS OF FDN. MKD F3
SCALE 1:50

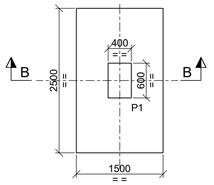


DETAILS OF FDN. MKD F2
SCALE 1:50

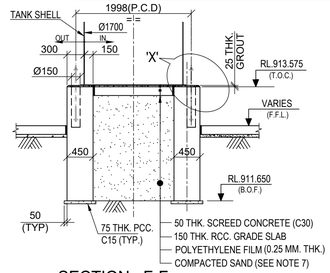

SECTION : F-F
SCALE 1:50

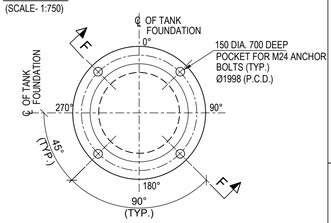

DETAIL OF FOUNDATION
FOR TANK MKD. 3380-TNK-002
SCALE 1:50

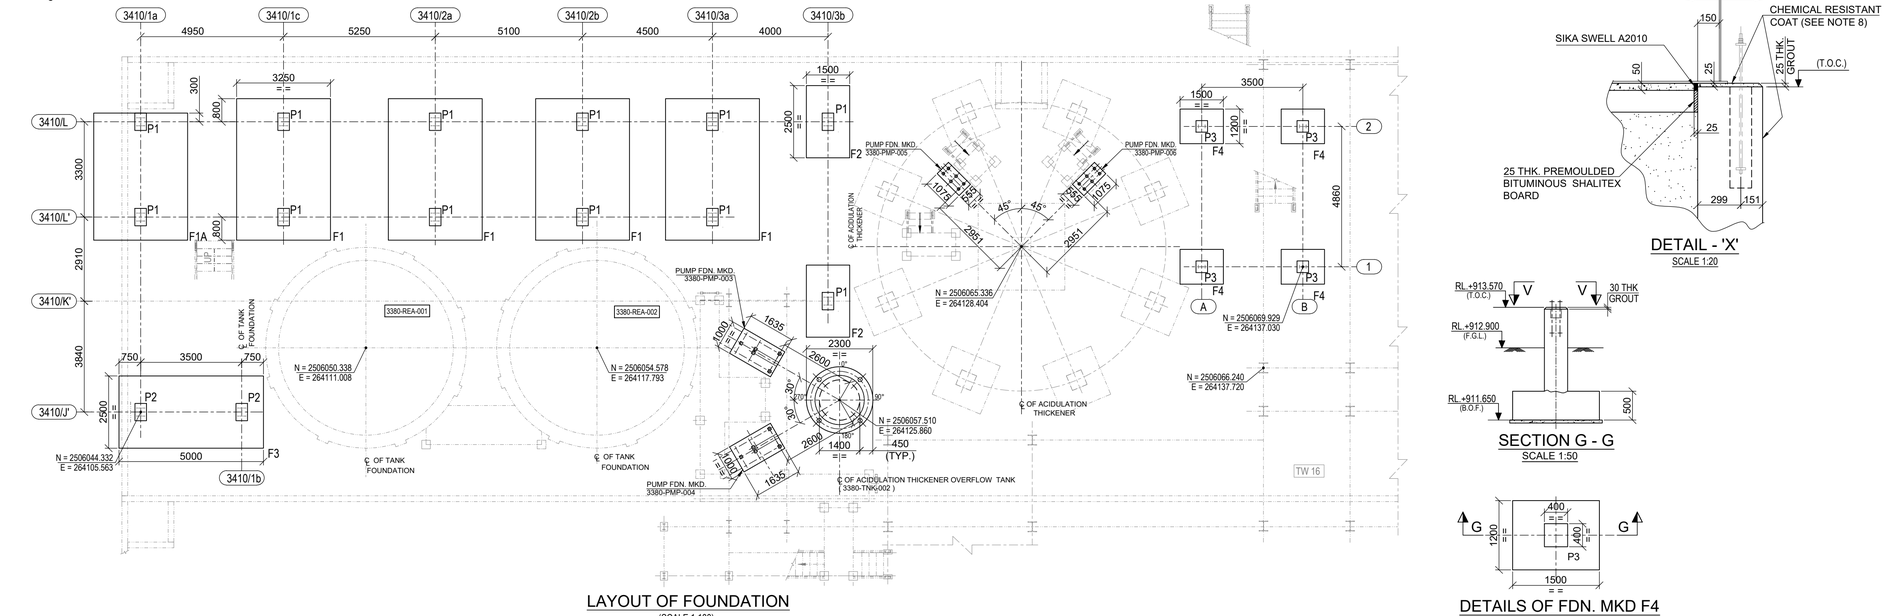

LAYOUT OF FOUNDATION
(SCALE 1:100)

DETAIL - 'X'
SCALE 1:20

SECTION G - G
SCALE 1:50

DETAILS OF FDN. MKD F4
SCALE 1:50

VIEW V-V
FOR COLUMN MKD. P4
SCALE 1:25

LEGEND :-

R.L. - REDUCED LEVEL
T.O.C. - TOP OF CONCRETE.
F.G.L. - FINISHED GROUND LEVEL.
F.F.L. - FINISHED FLOOR LEVEL.
B.O.F. - BOTTOM OF FOUNDATION
TYP. - TYPICAL.
P.C.D. - PITCH CIRCLE DIAMETER.
P.C.C - PLAIN CEMENT CONCRETE
MKD. - MARKED.
THK. - THICK
EQV. - EQUIVALENT
Ø - DIAMETER
CJ - CONSTRUCTION JOINT
SQ - SQUARE
RCC. - REINFORCED CEMENT CONCRETE
DIA - DIAMETER
DRG. - DRAWING
℄ - CENTRE LINE

NOTES :-

1. ALL DIMENSIONS ARE IN MILLIMETERS AND LEVELS AND CO-ORDINATES ARE IN METERS. UNLESS OTHERWISE STATED.
2. GRADE OF CONCRETE SHALL BE C35 FOR FOUNDATION.
3. GRADE OF REINFORCEMENT SHALL BE DEFORMED BAR ASTM A615 - GRADE 60 (fy = 420 MPa).
4. NET SAFE BEARING CAPACITY OF SOIL AT BOTTOM OF FOUNDATION IS CONSIDERED 400KN/SQ. M.
5. IF ANY PART OF FOUNDATION COMES ON BACKFILL ZONE OF ADJACENT FOUNDATION OR ANY LOOSE SOIL ARE ENCOUNTERED BELOW FOUNDATION LEVEL THE SAME SHALL BE REMOVED AND FILLED WITH PCC.
6. THIS DRG. SHALL BE READ IN CONJUNCTION WITH DRG. NO. MD-216-3380-EG-CV-DED-1002.
7. SAND SHALL BE COMPACTED TO A MAXIMUM DEPTH OF 300MM AND SHALL BE COMPACTED TO 80% RELATIVE DENSITY AS DETERMINED BY ASTM D4253 AND ASTM D4254.
8. CHEMICAL RESISTANT COATING SHALL BE APPLIED FOR PROTECTING CONCRETE AGAINST ACID & ALKALI .

DOCUMENT NUMBER	REFERENCE DOCUMENTS			REVISION DESCRIPTION	DRN	CHK	ENG	APP	EMP
MD-216-3420-EG-ME-GAD-1011	POX - FEED STORAGE PLAN AT EL. +912.900	D01	10/03/2023	AS-BUILT	SYA	SJM	SOR	AG	
MD-216-3380-EG-ST-GAD-1002	ACIDULATION BUILDING	C02	30/12/2020	ISSUED FOR CONSTRUCTION & REVISED AS MARKED C02	SYA	SJM	SOR	AG	
MD-216-3380-EG-ST-GAD-1001	ACIDULATION BUILDING	C01	12/11/2020	ISSUED FOR CONSTRUCTION & REVISED AS MARKED C01	SYA	SJM	SOR	AG	
MD-216-3380-EG-ST-GAD-1003	ACIDULATION AREA - ON GROUND PLATFORMS	A01	07/10/2020	ISSUED FOR REFERENCE	AUD	SJM	SOR	AG	

RESERVED FOR VENDOR LOGO AND DRAWING NUMBER

LARSEN & TOUBRO
This drawing is the property of LARSEN & TOUBRO and must not be passed on to any person or body not authorized by us to receive it nor be copied or otherwise made use either in full or in part by such person or body without our prior permission in writing.

Outotec
The content of these documents are the sole property of Outotec Oyj. Any rights not expressly granted herein are reserved. Reproduction, transfer or distribution of part or all of the contents in any form without prior written permission of Outotec is prohibited.

MA'ADEN معادن
Saudi Arabian Mining Company شركة معادن العربية السعودية
This document and the information contained herein is Ma'aden proprietary know-how. This document or any part thereof should not be reproduced, stored in a retrieval system or transmitted by any means, electronic or otherwise, or divulged without prior written permission of Ma'aden.

LARSEN & TOUBRO DRAWING NUMBER	019045_450_C_G_24533_001		REVISION 3
OUTOTEC DRAWING NUMBER	900707 __GAU01 __HL15 __MTL01 __33812	DOCUMENT ID OU100698122	REVISION 3

DRAWN	AUD	24/09/2020
CHECKED	SJM	26/09/2020
ENGINEER	SOR	23/09/2020
APPROVED	AG	07/10/2020
EMPLOYER		

SCALE 1:75, 1:50, 1:25, 1:10 — A1

MANSOURAH - MASSARAH GOLD PROJECT
GENERAL ARRANGEMENT DRAWING
ACIDULATION
GA & DETAILS OF BUILDING FOUNDATION

DRAWING NUMBER: MD - 216 - 3380 - EG - CV - GAD - 1005
REV: D01