



DRAWING NUMBER: MD-216-3610-EG-CV-GAD-1007 | REV: D01

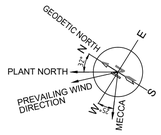

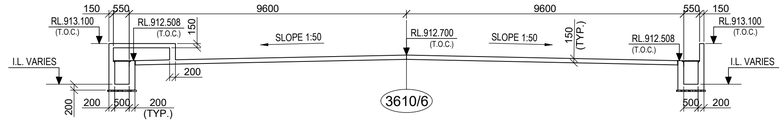


SECTION : A-A
SCALE 1:100

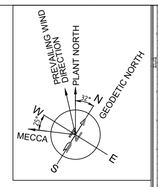

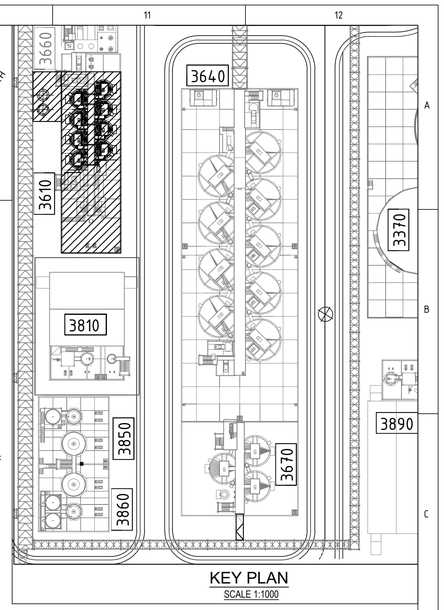

KEY PLAN
SCALE 1:1000

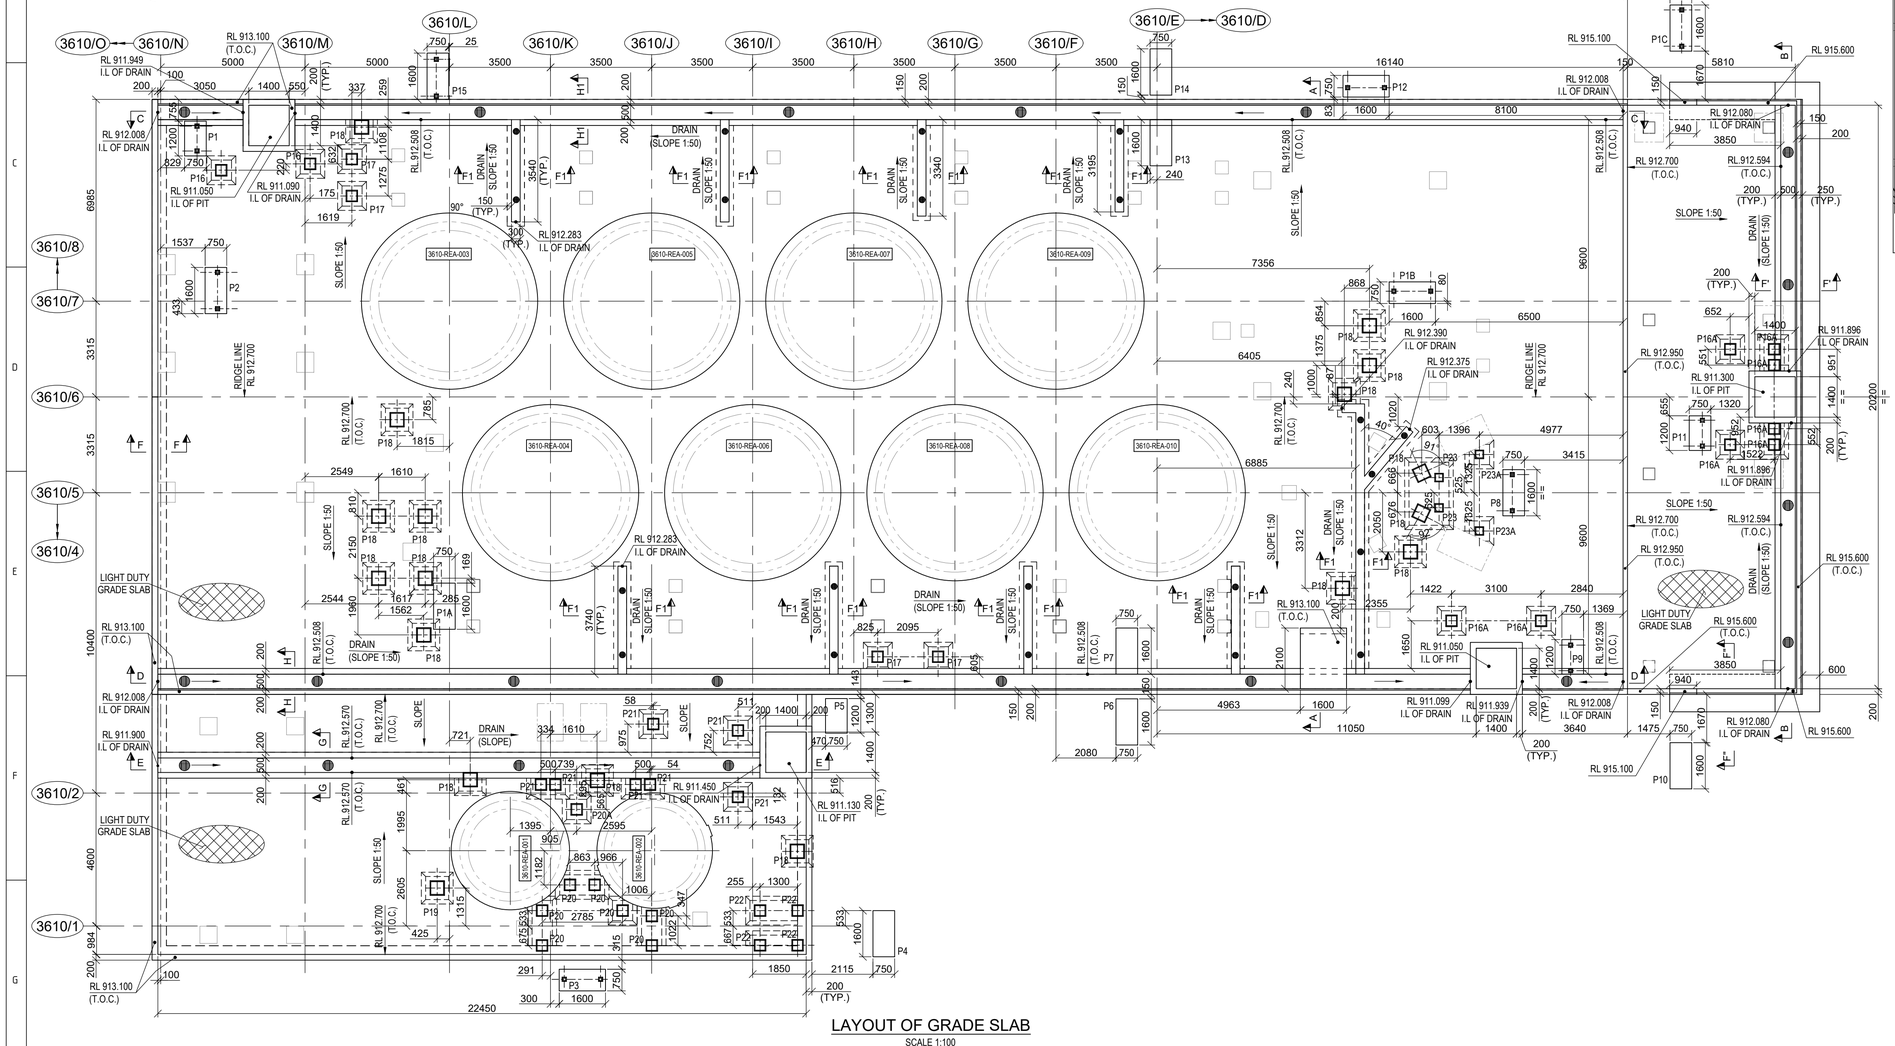

LAYOUT OF GRADE SLAB
SCALE 1:100

LEGEND :-
RL. - REDUCED LEVEL
℄ - CENTRE LINE
I.L - INVERT LEVEL
F.G.L - FINISHED GROUND LEVEL
T.O.C. - TOP OF CONCRETE

NOTES:-
1. ALL DIMENSIONS ARE IN MILLIMETRES AND LEVELS AND CO-ORDINATES ARE IN METRES UNLESS OTHERWISE STATED.
2. FOR DETAILS OF GRADE SLAB REFER DRG. NO. MD-216-1000-EG-CV-DED-1002.
3. THIS DRAWING SHOULD BE READ IN CONJUNCTION WITH DRAWING NO. MD-216-3610-EG-CV-DED-1001.
4. CHEMICAL RESISTANT COATING SHALL BE APPLIED FOR PROTECTING CONCRETE AGAINST CYANIDE, ACID & ALKALI.

DOCUMENT NUMBER	REFERENCE DOCUMENTS	REV	DATE	REVISION DESCRIPTION	DRN	CHK	ENG	APP	EMP
MD-216-3610-EG-CV-DED-1001	RC. DETAILS OF GRADE SLAB								
MD-216-3610-EG-GV-GAD-1300	LAYOUT & DETAIL OF TANK FOUNDATIONS								
MD-216-1000-EG-ST-CRT-1001	CIVIL, STRUCTURAL & ARCHITECTURAL - DESIGN CRITERIA								
MD-216-3610-EG-ME-GAD-1020	POX CONDITIONING, LEACHING & ADSORPTION PLAN AT EL.+912.700	D01	16/03/2023	AS-BUILT	ABS	SJM	AVG	AG	
MD-216-3610-EG-ME-PLN-1001	FOUNDATION AND LOAD PLAN POX CONDITIONING, LEACHING &	C01	11/12/2020	ISSUED FOR CONSTRUCTION & REVISED AS MKD. C01	ABS	SJM	AVG	AG	
	ADSORPTION 3610-REA-001 TO 002 POX CONDITIONING REACTOR	A01	20/10/2020	ISSUED FOR REFERENCE	ABS	SJM	AVG	AG	

RESERVED FOR VENDOR LOGO AND DRAWING NUMBER

LARSEN & TOUBRO

This drawing is the property of LARSEN & TOUBRO and must not be passed on to any person or body not authorized by us to receive it nor be copied or otherwise made use either in full or in part by such person or body without our prior permission in writing.

Outotec

The content of these documents are the sole property of Outotec Oyj. Any rights not expressly granted herein are reserved. Reproduction, transfer or distribution of part or all of the contents in any form without prior written permission of Outotec is prohibited.

MA'ADEN معادن
Saudi Arabian Mining Company شركة التعدين العربية السعودية

This document and the information contained herein is Ma'aden proprietary know-how. This document or any part thereof should not be reproduced, stored in a retrieval system or transmitted by any means, electronic or otherwise, or divulged without prior written permission of Ma'aden.

LARSEN & TOUBRO DRAWING NUMBER: 019045_450_C_G_24630_001 | REVISION: 2
OUTOTEC DRAWING NUMBER: 900707__GAU01__HL12__MTL01__36125 | DOCUMENT ID: OU100680997 | REVISION: 2

DRAWN	ABS	18/10/2020
CHECKED	SJM	19/10/2020
ENGINEER	AVG	18/10/2020
APPROVED	AG	20/10/2020
EMPLOYER		
SCALE	1:100, 1:50	A1

MANSOURAH - MASSARAH GOLD PROJECT
GENERAL ARRANGEMENT DRAWING
POX CONDITIONING, LEACHING AND ADSORPTION
LAYOUT & DETAIL OF GRADE SLAB

DRAWING NUMBER: MD-216-3610-EG-CV-GAD-1007 | REV: D01