



DRAWING NUMBER: MD-216-3610-EG-CV-GAD-1020
REV: D01

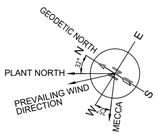

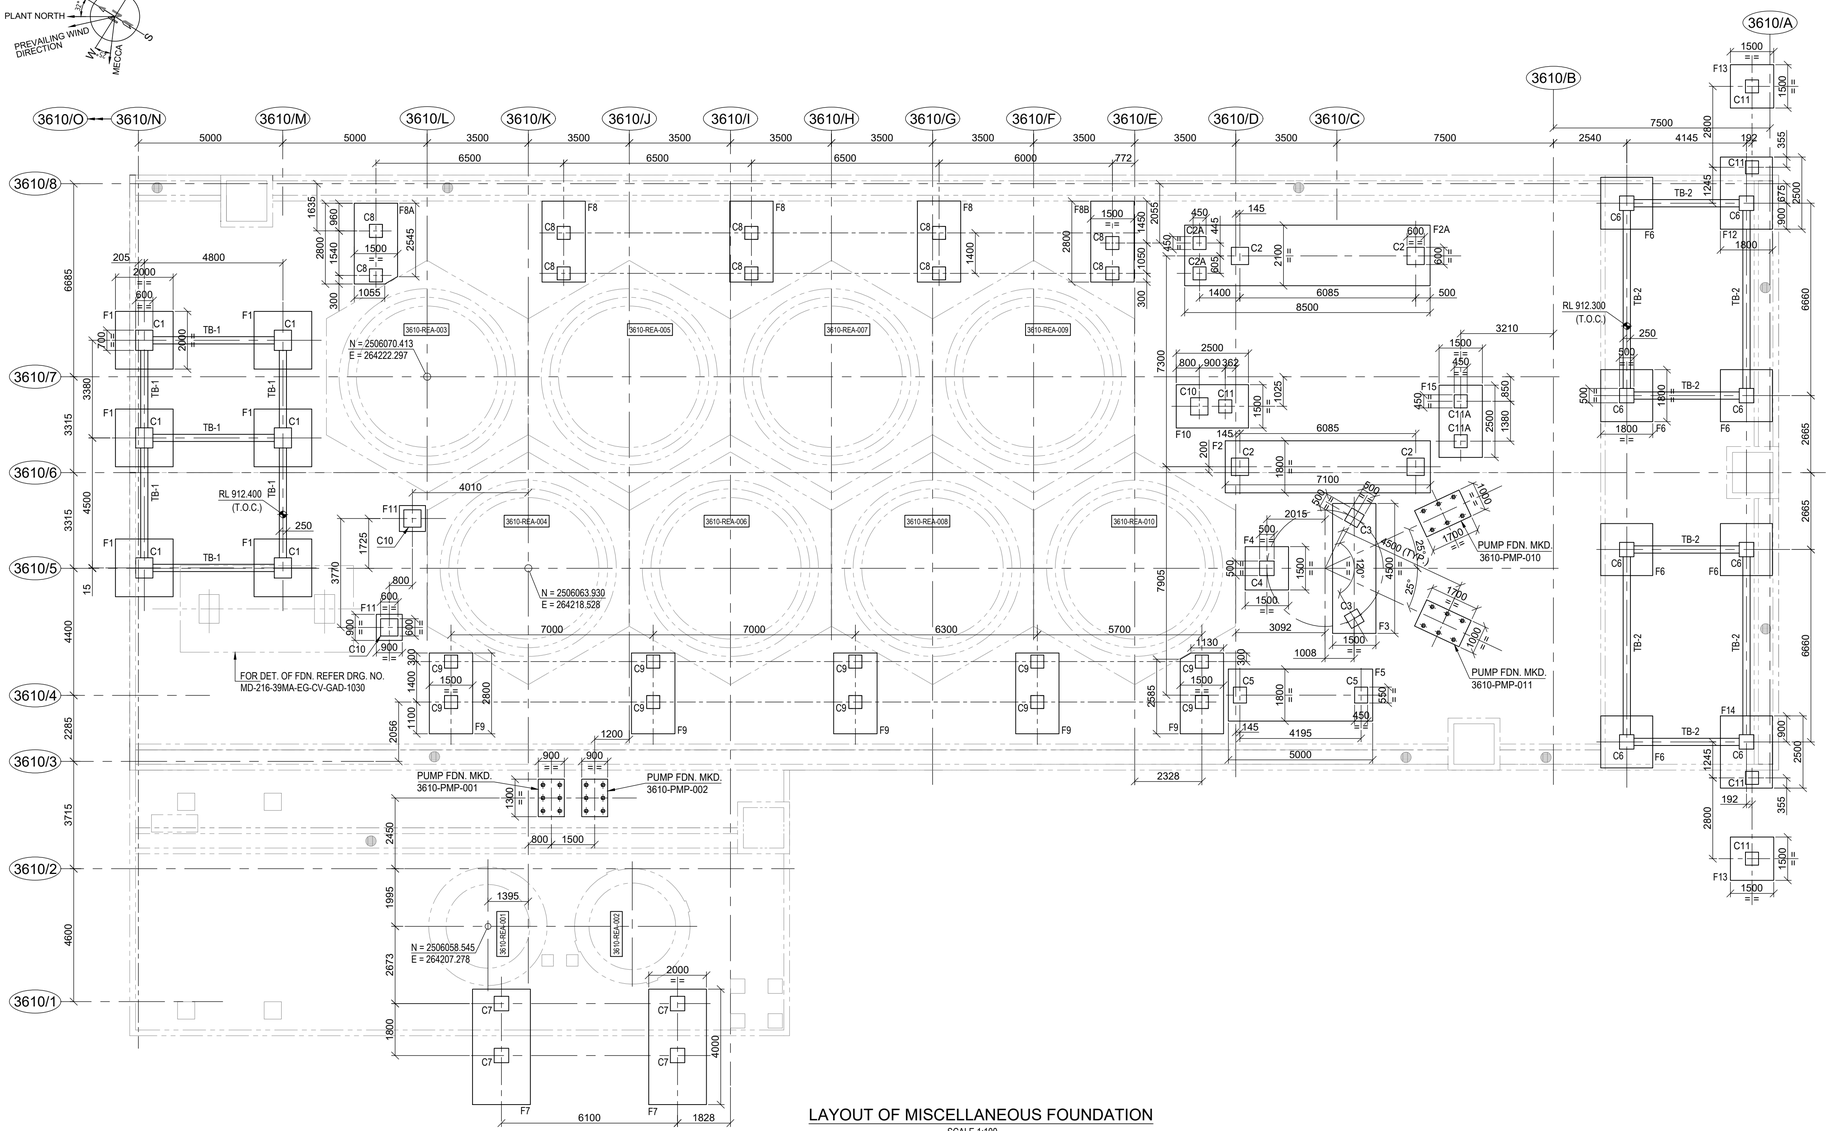

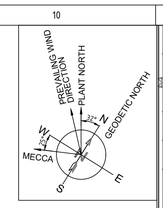

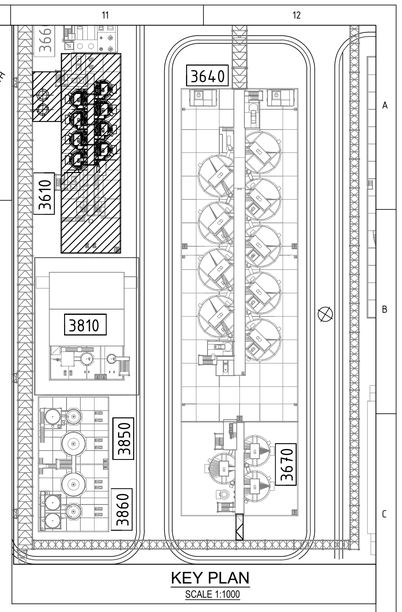

KEY PLAN
SCALE 1:1000

LAYOUT OF MISCELLANEOUS FOUNDATION

SCALE 1:100

LEGEND :-

R.L. - REDUCED LEVEL
℄ - CENTRE LINE
T.O.C. - TOP OF CONCRETE
TYP. - TYPICAL
F.G.L. - FINISHED GROUND LEVEL
F.F.L. - FINISHED FLOOR LEVEL
B.O.F. - BOTTOM OF FOUNDATION
MKD. - MARKED
P.C.C - PLAIN CEMENT CONCRETE
P.C.D. - PITCH CIRCLE DIAMETER
DIA. - EXPANSION JOINT
DET. - DETAIL
SQ. - SQUARE
FDN. - FOUNDATION
THK. - THICK
DIA. - DIAMETER
DRG. - DRAWING

NOTES:-

1. ALL DIMENSIONS ARE IN MILLIMETRES AND LEVELS AND CO-ORDINATES ARE IN METRES UNLESS OTHERWISE STATED.
2. NET SAFE BEARING CAPACITY OF SOIL AT BOTTOM OF FOUNDATION CONSIDER 450KN/ SQ. M
3. GRADE OF CONCRETE SHALL BE C35 (35MPa) FOR FOUNDATION & C15 (15MPa) FOR BLINDING CONCRETE.
4. GRADE OF REINFORCEMENT SHALL BE DEFORMED BAR 420 MPa (GRADE 60) - ASTM A615/A615M.
5. IF ANY PART OF FOUNDATION COMES ON BACKFILL ZONE OF ADJACENT FOUNDATION OR ANY LOOSE SOIL ARE ENCOUNTERED BELOW FOUNDATION LEVEL THE SAME SHALL BE REMOVED AND FILLED WITH PCC (C15).
6. THIS DRAWING SHOULD BE READ IN CONJUNCTION WITH DRAWING NO. MD-216-3610-EG-CV-GAD-1021, MD-216-3610-EG-CV-GAD-1022.
7. CHEMICAL RESISTANT COATING SHALL BE APPLIED FOR PROTECTING CONCRETE AGAINST CYANIDE, ACID AND ALKALI.

DOCUMENT NUMBER	REFERENCE DOCUMENTS	REV	DATE	REVISION DESCRIPTION	DRN	CHK	ENG	APP	EMP
MD-216-3610-EG-CV-DED-1001	RC. DETAILS OF GRADE SLAB								
MD-216-3610-EG-GV-GAD-1300	LAYOUT & DETAIL OF TANK FOUNDATIONS								
MD-216-1000-EG-ST-CRT-1001	CIVIL, STRUCTURAL & ARCHITECTURAL - DESIGN CRITERIA								
MD-216-3610-EG-ME-GAD-1020	POX CONDITIONING, LEACHING & ADSORPTION PLAN AT EL.+912.700	D01	16/03/2023	AS-BUILT	ABS	SJM	AVG	AG	
MD-216-3610-EG-ME-PLN-1001	FOUNDATION AND LOAD PLAN POX CONDITIONING, LEACHING &	C01	26/11/2020	ISSUED FOR CONSTRUCTION & REVISED AS MKD. C01	ABS	SJM	AVG	AG	
	ADSORPTION 3610-REA-001 TO 002 POX CONDITIONING REACTOR	A01	20/10/2020	ISSUED FOR REFERENCE	ABS	SJM	AVG	AG	

RESERVED FOR VENDOR LOGO AND DRAWING NUMBER

LARSEN & TOUBRO

This drawing is the property of LARSEN & TOUBRO and must not be passed on to any person or body not authorized by us to receive it nor be copied or otherwise made use either in full or in part by such person or body without our prior permission in writing.

Outotec

The content of these documents are the sole property of Outotec Oyj. Any rights not expressly granted herein are reserved. Reproduction, transfer or distribution of part or all of the contents in any form without prior written permission of Outotec is prohibited.

MA'ADEN معادن
Saudi Arabian Mining Company شركة المعادن العربية السعودية

This document and the information contained herein is Ma'aden proprietary know-how. This document or any part thereof should not be reproduced, stored in a retrieval system or transmitted by any means, electronic or otherwise, or divulged without prior written permission of Ma'aden.

LARSEN & TOUBRO DRAWING NUMBER: 019045_450_C_G_24556_001 — REVISION: 2
OUTOTEC DRAWING NUMBER: 900707 _GAU01 _HL12 _MTL01 _36146 — DOCUMENT ID: OU100703521 — REVISION: 2

DRAWN	ABS	07/10/2020
CHECKED	SJM	14/10/2020
ENGINEER	AVG	07/10/2020
APPROVED	AG	20/10/2020
EMPLOYER		
SCALE	1:100, 1:50	A1

MANSOURAH - MASSARAH GOLD PROJECT
GENERAL ARRANGEMENT DRAWING
POX CONDITIONING, LEACHING AND ADSORPTION
LAYOUT OF MISCELLANEOUS FOUNDATION

DRAWING NUMBER: MD-216-3610-EG-CV-GAD-1020 — REV: D01