


DRAWING NUMBER: MD-216-3610-EG-CV-GAD-1300
REV: D01

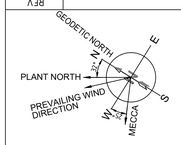

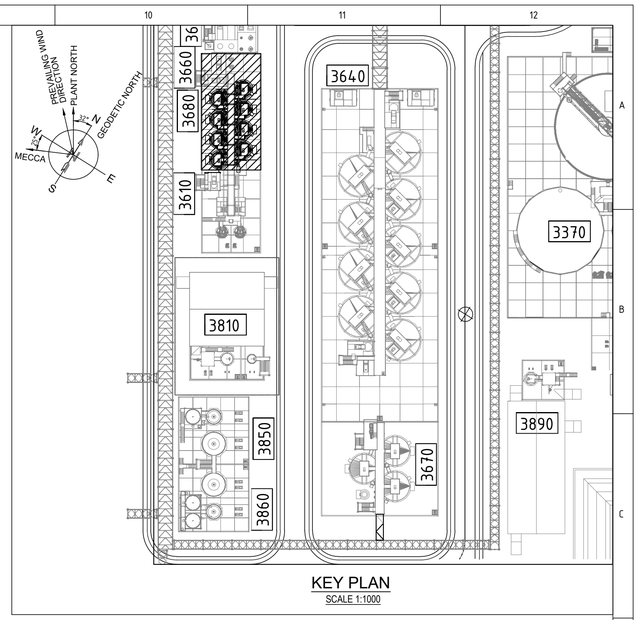

KEY PLAN
SCALE 1:1000

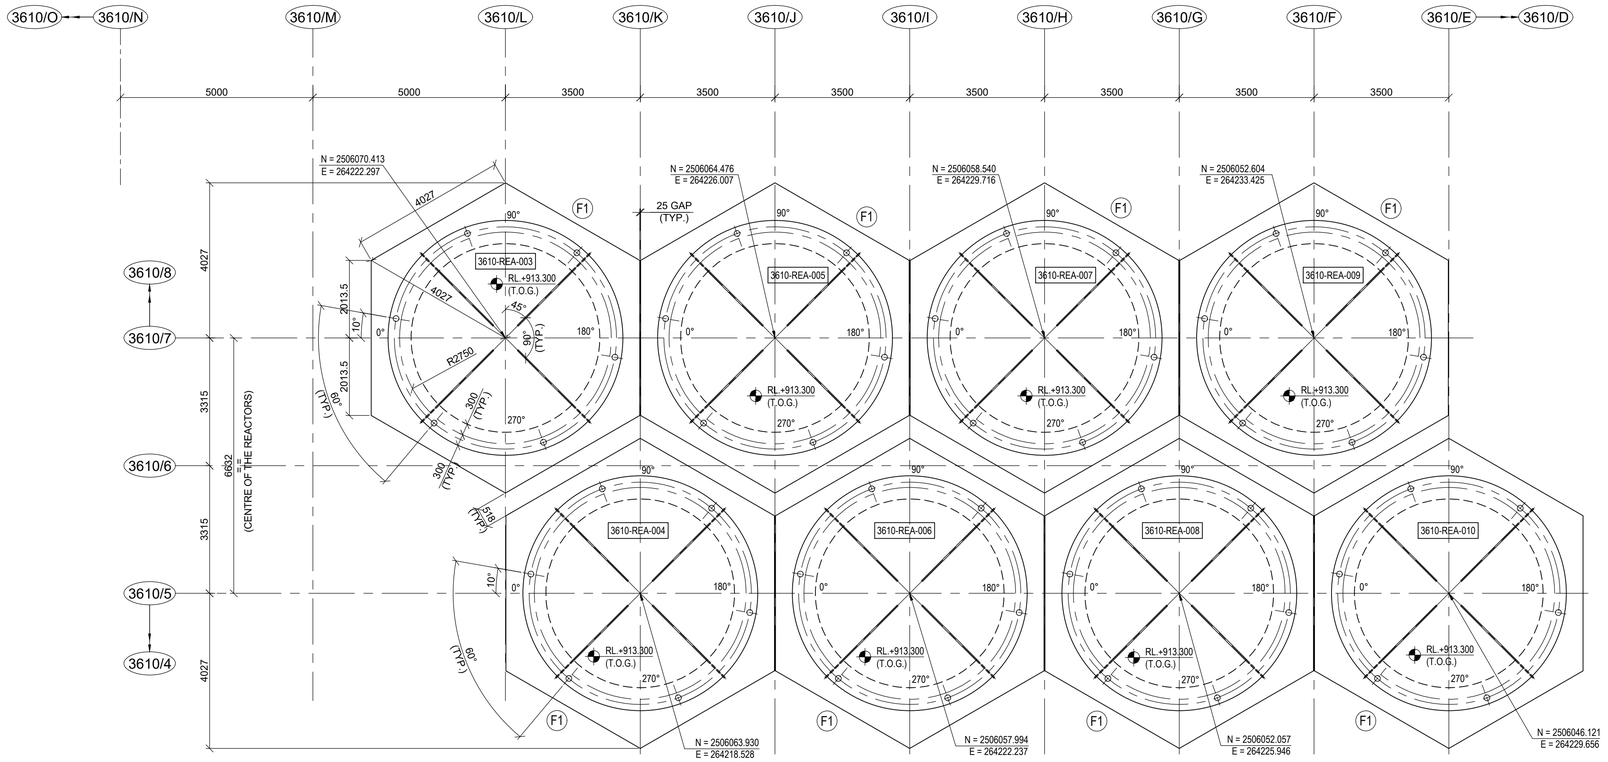

LAYOUT OF FOUNDATION
SCALE 1:75

LEGEND :-
R.L - REDUCED LEVEL
℄ - CENTRE LINE
T.O.G. - TOP OF GROUT
TYP. - TYPICAL
R - RADIUS

NOTES:-
1. ALL DIMENSIONS ARE IN MILLIMETRES AND LEVELS AND CO-ORDINATES ARE IN METRES UNLESS OTHERWISE STATED.
2. NET SAFE BEARING CAPACITY OF SOIL AT BOTTOM OF FOUNDATION CONSIDER 450KN/ SQ. M
3. IF ANY PART OF FOUNDATION COMES ON BACKFILL ZONE OF ADJACENT FOUNDATION OR ANY LOOSE SOIL ARE ENCOUNTERED BELOW FOUNDATION LEVEL THE SAME SHALL BE REMOVED AND FILLED WITH PCC.

DOCUMENT NUMBER	REFERENCE DOCUMENTS
MD-216-3610-EG-GV-DED-1302	RCC DETAILS OF TANK FOUNDATIONS
MD-216-3610-EG-GV-GAD-1301	LAYOUT & DETAIL OF TANK FOUNDATIONS
MD-216-1000-EG-ST-CRT-1001	CIVIL, STRUCTURAL & ARCHITECTURAL - DESIGN CRITERIA
MD-216-3610-EG-ME-GAD-1020	POX CONDITIONING, LEACHING & ADSORPTION PLAN AT EL.+912.700
MD-216-3610-EG-ME-PLN-1001	FOUNDATION AND LOAD PLAN POX CONDITIONING, LEACHING &
	ADSORPTION 3610-REA-001 TO 002 POX CONDITIONING REACTOR

REV	DATE	REVISION DESCRIPTION	DRN	CHK	ENG	APP	EMP
D01	16/03/2023	AS-BUILT	ABS	SJM	AVG	AG	
C02	10/05/2020	ISSUED FOR CONSTRUCTION & REVISED AS MKD. △C02	ABS	SJM	AVG	AG	
C01	10/04/2020	ISSUED FOR CONSTRUCTION	ABS	SJM	AVG	AG	
A01	25/02/2020	ISSUED FOR REFERENCE	ABS	SJM	AVG	AG	

RESERVED FOR VENDOR LOGO AND DRAWING NUMBER

LARSEN & TOUBRO

This drawing is the property of LARSEN & TOUBRO and must not be passed on to any person or body not authorized by us to receive it nor be copied or otherwise made use either in full or in part by such person or body without our prior permission in writing.

Outotec

The content of these documents are the sole property of Outotec Oyj. Any rights not expressly granted herein are reserved. Reproduction, transfer or distribution of part or all of the contents in any form without prior written permission of Outotec is prohibited.

MA'ADEN معادن
Saudi Arabian Mining Company شركة معادن العربية السعودية

This document and the information contained herein is Ma'aden proprietary know-how. This document or any part thereof should not be reproduced, stored in a retrieval system or transmitted by any means, electronic or otherwise, or divulged without prior written permission of Ma'aden.

LARSEN & TOUBRO DRAWING NUMBER: 019045_450_C_G_24129_001 — REVISION: 3
OUTOTEC DRAWING NUMBER: 900707__GAU01__HL12__MTL01__36115 — DOCUMENT ID: OU100672888 — REVISION: 3

DRAWN	ABS	04/02/2020
CHECKED	SJM	24/02/2020
ENGINEER	AVG	04/02/2020
APPROVED	AG	25/02/2020
EMPLOYER		
SCALE	1:75	A1

MANSOURAH - MASSARAH GOLD PROJECT
GENERAL ARRANGEMENT DRAWING
POX CONDITIONING, LEACHING AND ADSORPTION
LAYOUT & DETAIL OF TANK FOUNDATIONS

DRAWING NUMBER: MD-216-3610-EG-CV-GAD-1300 — REV: D01