


DRAWING NUMBER MD-216-3610-EG-CV-GAD-1301 REV D01

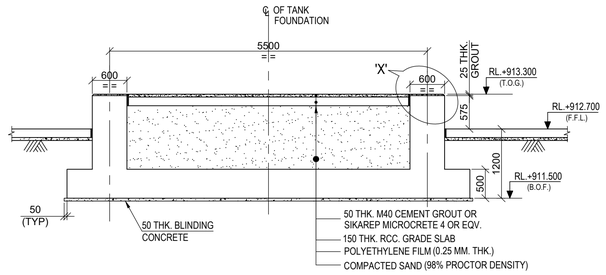


SECTION : A-A
SCALE 1:50

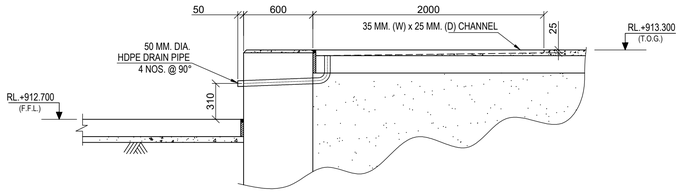


SECTION : C-C
SCALE 1:25

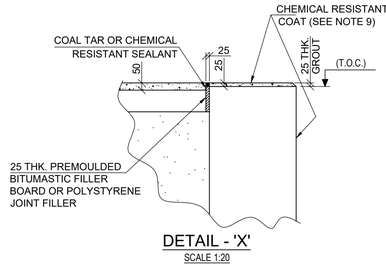


DETAIL - 'X'
SCALE 1:20

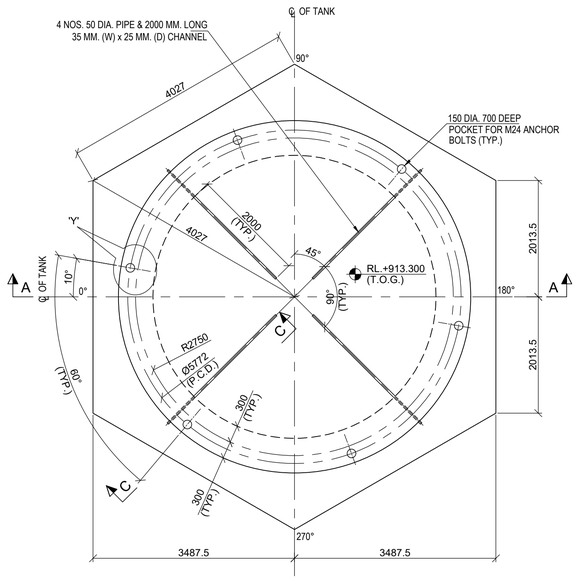

DETAIL OF TANK FOUNDATION MKD. F1
(8 NOS. REQD.)
SCALE 1:50

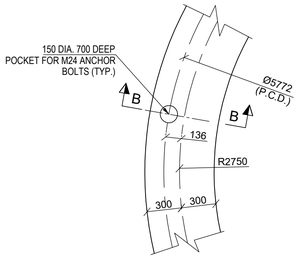

DETAIL : 'Y'
SCALE 1:25

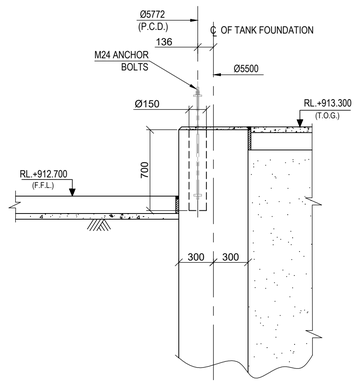

SECTION : B-B
SCALE 1:25

LEGEND :-

R.L. - REDUCED LEVEL
℄ - CENTRE LINE
T.O.C. - TOP OF CONCRETE
F.G.L. - FINISHED GROUND LEVEL
F.F.L. - FINISHED FLOOR LEVEL
B.O.F. - BOTTOM OF FOUNDATION
TYP. - TYPICAL
P.C.D. - PITCH CIRCLE DIAMETER
R.C.C - REINFORCED CEMENT CONCRETE
P.C.C - PLAIN CEMENT CONCRETE
MKD. - MARKED
I.D. - INTERNAL DIAMETER
Ø - DIAMETER
R - RADIUS
THK. - THICK
T.O.G. - TOP OF GROUT

NOTES:-

1. ALL DIMENSIONS ARE IN MILLIMETRES AND LEVELS AND CO-ORDINATES ARE IN METRES UNLESS OTHERWISE STATED.
2. GRADE OF CONCRETE SHALL BE C35 (35MPa) FOR FOUNDATION, C30 C30 (30MPa) FOR GRADE SLAB & C15 (15MPa) FOR BLINDING CONCRETE.
3. GRADE OF REINFORCEMENT SHALL BE DEFORMED BAR 420 MPa (GRADE 60) - ASTM A615/A615M.
4. GRADE OF WELDED WIRE MESH SHALL BE GRADE 60 (fy = 420 MPa) ACCORDING TO A1064.
5. NET SAFE BEARING CAPACITY OF SOIL AT BOTTOM OF FOUNDATION CONSIDER 450KN/ SQ. M
6. IF ANY PART OF FOUNDATION COMES ON BACKFILL ZONE OF ADJACENT FOUNDATION OR ANY LOOSE SOIL ARE ENCOUNTERED BELOW FOUNDATION LEVEL THE SAME SHALL BE REMOVED AND FILLED WITH PCC.
7. SAND SHALL BE COMPACTED TO A MINIMUM DEPTH OF 300MM TO ACHIEVE 98% MODIFIED MAXIMUM DRY DENSITY AS MEASURED BY ASTM D1557.
8. FOUNDATION & SUPPORT TOLERANCES
   a) THE FIRST 300MM WIDTH OF AN ANNULAR RING MEASURED FROM THE OUTSIDE OF THE TANK RADIALLY TOWARDS THE CENTRE SHALL BE WITHIN +/-3MM OF THE DESIGN LEVEL.
   b) THE REMAINDER OF THE FOUNDATION SHALL BE WITHIN +/-6MM OF THE DESIGN LEVEL.
9. CHEMICAL RESISTANT COATING SHALL BE APPLIED FOR PROTECTING CONCRETE AGAINST CYANIDE, ACID AND ALKALI.

DOCUMENT NUMBER	REFERENCE DOCUMENTS	REV	DATE	REVISION DESCRIPTION	DRN	CHK	ENG	APP	EMP
MD-216-3610-EG-GV-DED-1302	RCC DETAILS OF TANK FOUNDATIONS								
MD-216-3610-EG-GV-GAD-1300	LAYOUT & DETAIL OF TANK FOUNDATIONS								
MD-216-1000-EG-ST-CRT-1001	CIVIL, STRUCTURAL & ARCHITECTURAL - DESIGN CRITERIA								
MD-216-3610-EG-ME-GAD-1020	POX CONDITIONING, LEACHING & ADSORPTION PLAN AT EL.+912.700	D01	16/03/2023	AS-BUILT	ABS	SJM	AVG	AG	
MD-216-3610-EG-ME-PLN-1001	FOUNDATION AND LOAD PLAN POX CONDITIONING, LEACHING &	C02	10/05/2020	ISSUED FOR CONSTRUCTION & REVISED AS MKD. /C02	ABS	SJM	AVG	AG	
	ADSORPTION 3610-REA-001 TO 002 POX CONDITIONING REACTOR	C01	10/04/2020	ISSUED FOR CONSTRUCTION & REVISED AS MKD. /C01	ABS	SJM	AVG	AG	
DOCUMENT NUMBER	REFERENCE DOCUMENTS	A01	25/02/2020	ISSUED FOR REFERENCE	ABS	SJM	AVG	AG	

RESERVED FOR VENDOR LOGO AND DRAWING NUMBER

LARSEN & TOUBRO

This drawing is the property of *LARSEN & TOUBRO* and must not be passed on to any person or body not authorized by us to receive it nor be copied or otherwise made use either in full or in part by such person or body without our prior permission in writing.

Outotec

The content of these documents are the sole property of Outotec Oyj. Any rights not expressly granted herein are reserved. Reproduction, transfer or distribution of part or all of the contents in any form without prior written permission of Outotec is prohibited.

MA'ADEN معادن
Saudi Arabian Mining Company شركة معادن العربية السعودية

This document and the information contained herein is Ma'aden proprietary know-how. This document or any part thereof should not be reproduced, stored in a retrieval system or transmitted by any means, electronic or otherwise, or divulged without prior written permission of Ma'aden.

LARSEN & TOUBROW DRAWING NUMBER: 019045_450_C_G_24129_002 — REVISION: 3
OUTOTEC DRAWING NUMBER: 900707__GAU01__HL12__MTL01__36116 — DOCUMENT ID: OU100672889 — REVISION: 3

DRAWN	ABS	04/02/2020
CHECKED	SJM	24/02/2020
ENGINEER	AVG	04/02/2020
APPROVED	AG	25/02/2020
EMPLOYER		

SCALE: 1:20, 1:50, 1:25 — A1

MANSOURAH - MASSARAH GOLD PROJECT
GENERAL ARRANGEMENT DRAWING
POX CONDITIONING, LEACHING AND ADSORPTION
LAYOUT & DETAIL OF TANK FOUNDATIONS

DRAWING NUMBER: MD-216-3610-EG-CV-GAD-1301 — REV: D01