DRAWING NUMBER MD - 216 - 3890 - EG - CV - GAD - 1440
REV D01

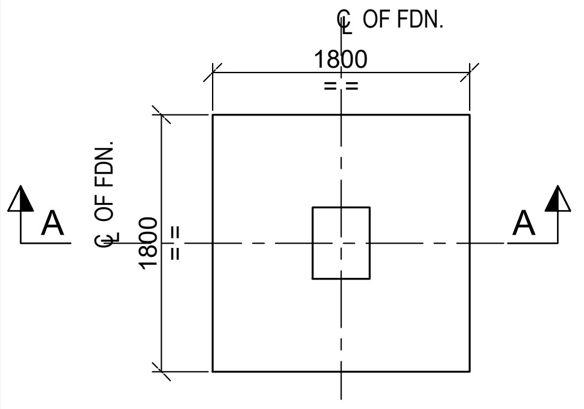

PLAN OF FOUNDATION
MKD. F1 TO F4
SCALE 1:50

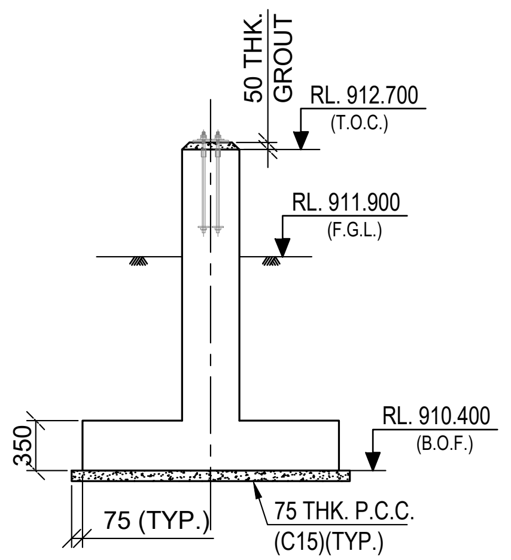

SECTION : A-A
SCALE 1:50

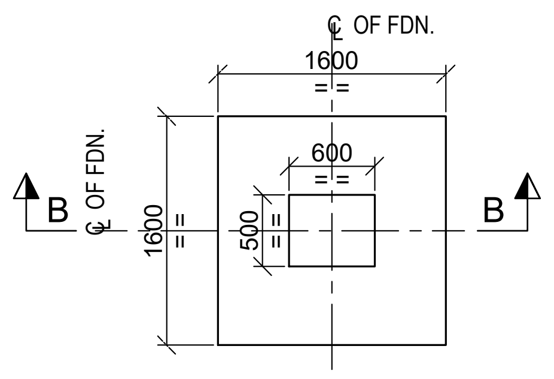

PLAN OF FOUNDATION
MKD. F5
SCALE 1:50

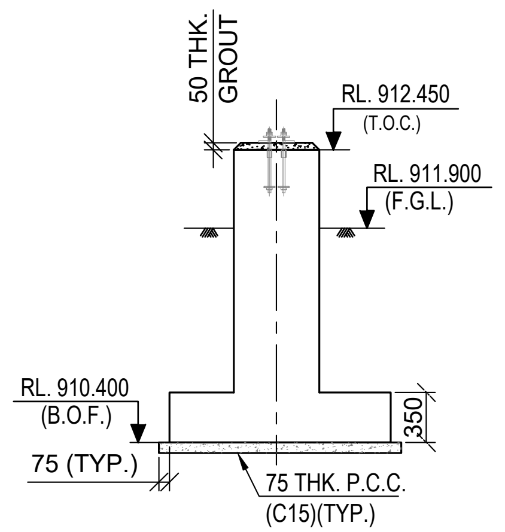

SECTION : B-B
SCALE 1:50

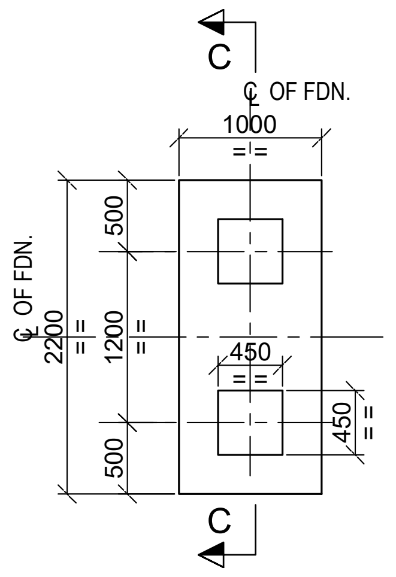

PLAN OF FOUNDATION
MKD. F6
SCALE 1:50

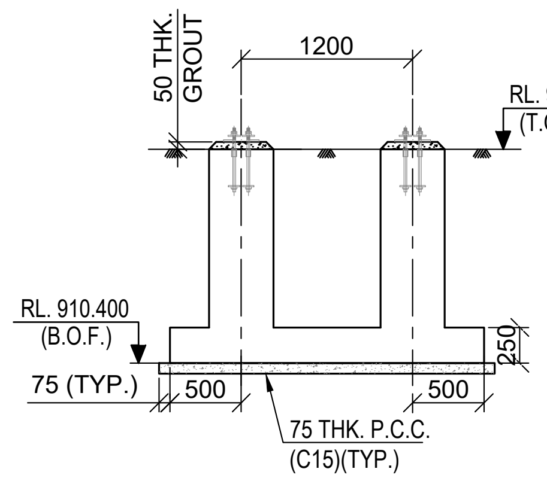

SECTION : C-C
SCALE 1:50

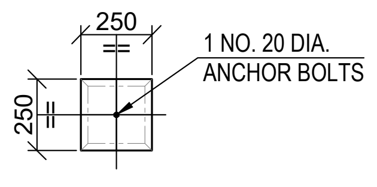

SECTION : F - F
(SCALE 1:25)

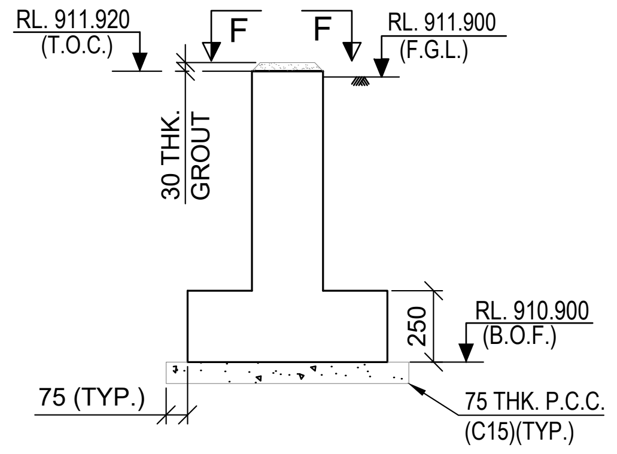

SECTION : E - E
(SCALE-1:25)

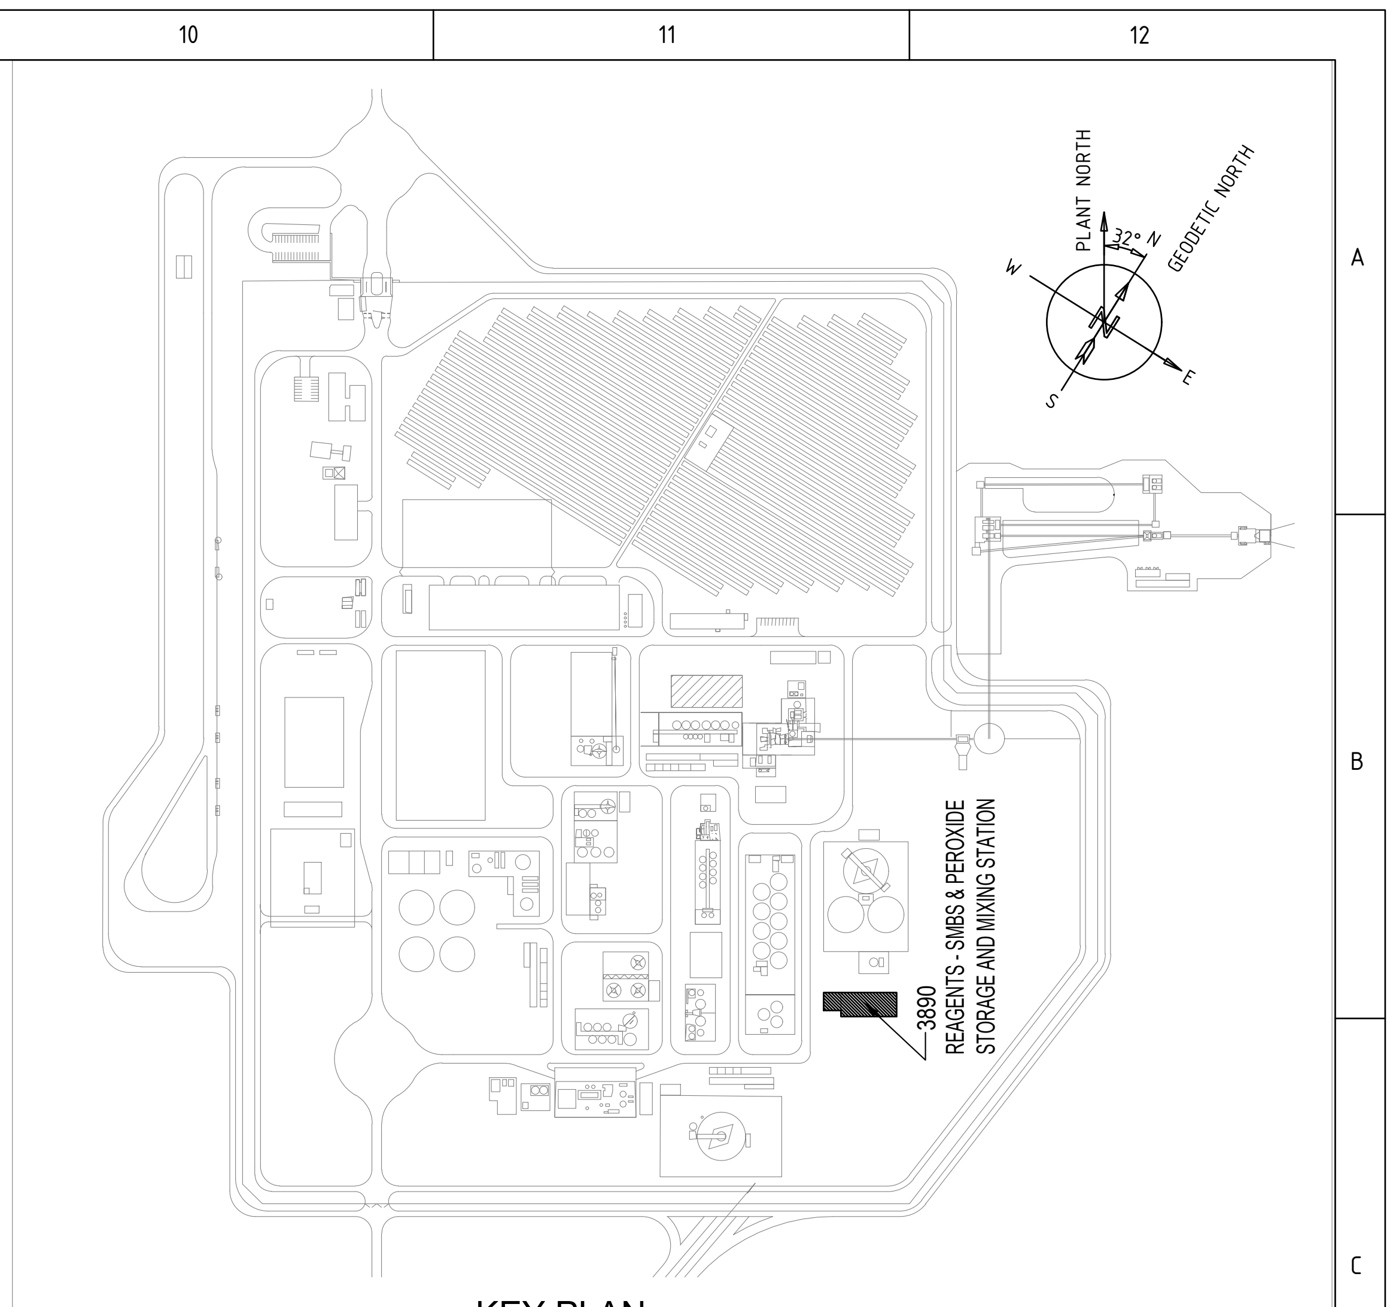

KEY PLAN
(SCALE 1:500)

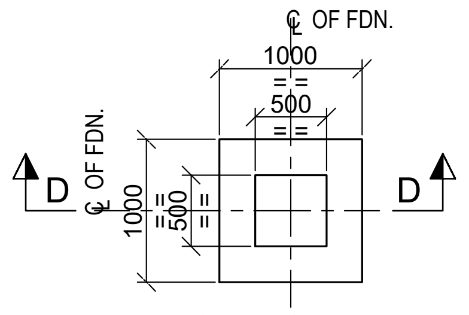

PLAN OF FOUNDATION
MKD. F7
SCALE 1:50

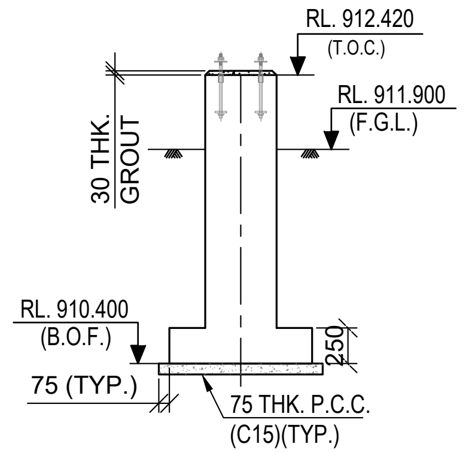

SECTION : D-D
SCALE 1:50

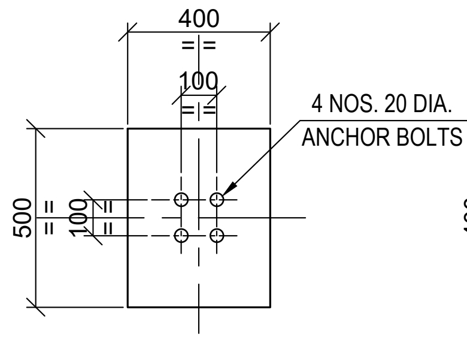

DETAIL OF COLUMN
MKD. - C1 & C3
(SCALE 1:20)

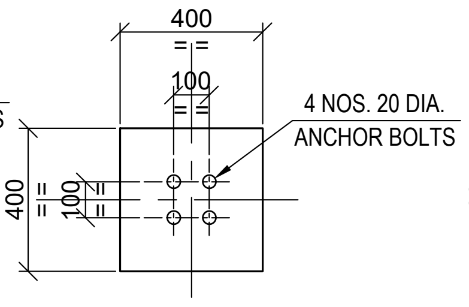

DETAIL OF COLUMN
MKD. - C2 & C4
(SCALE 1:20)

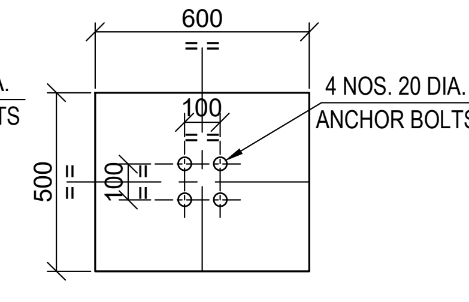

DETAIL OF COLUMN
MKD. - C5
(SCALE 1:20)

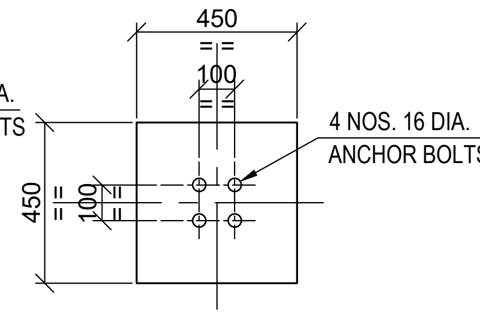

DETAIL OF COLUMN
MKD. - C6
(SCALE 1:20)

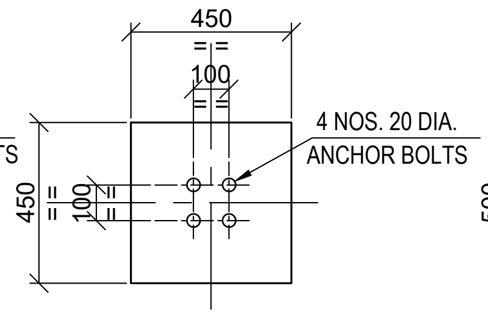

DETAIL OF COLUMN
MKD. - C7
(SCALE 1:20)

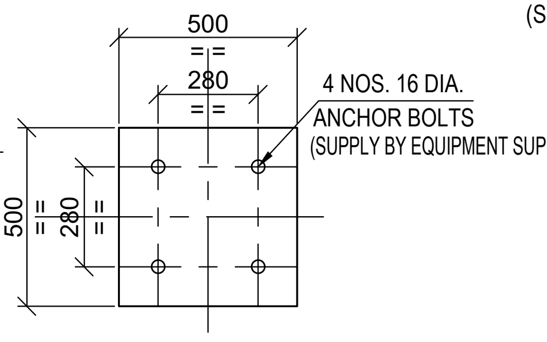

DETAIL OF COLUMN
MKD. - C8
(SCALE 1:20)

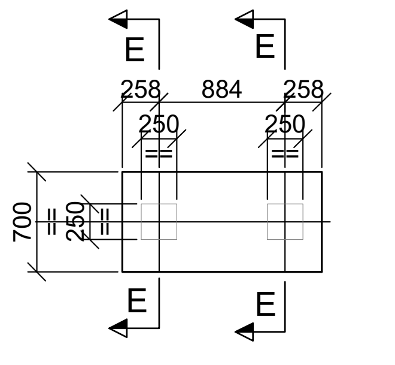

PLAN OF FOUNDATION - F8
(SCALE 1:50)

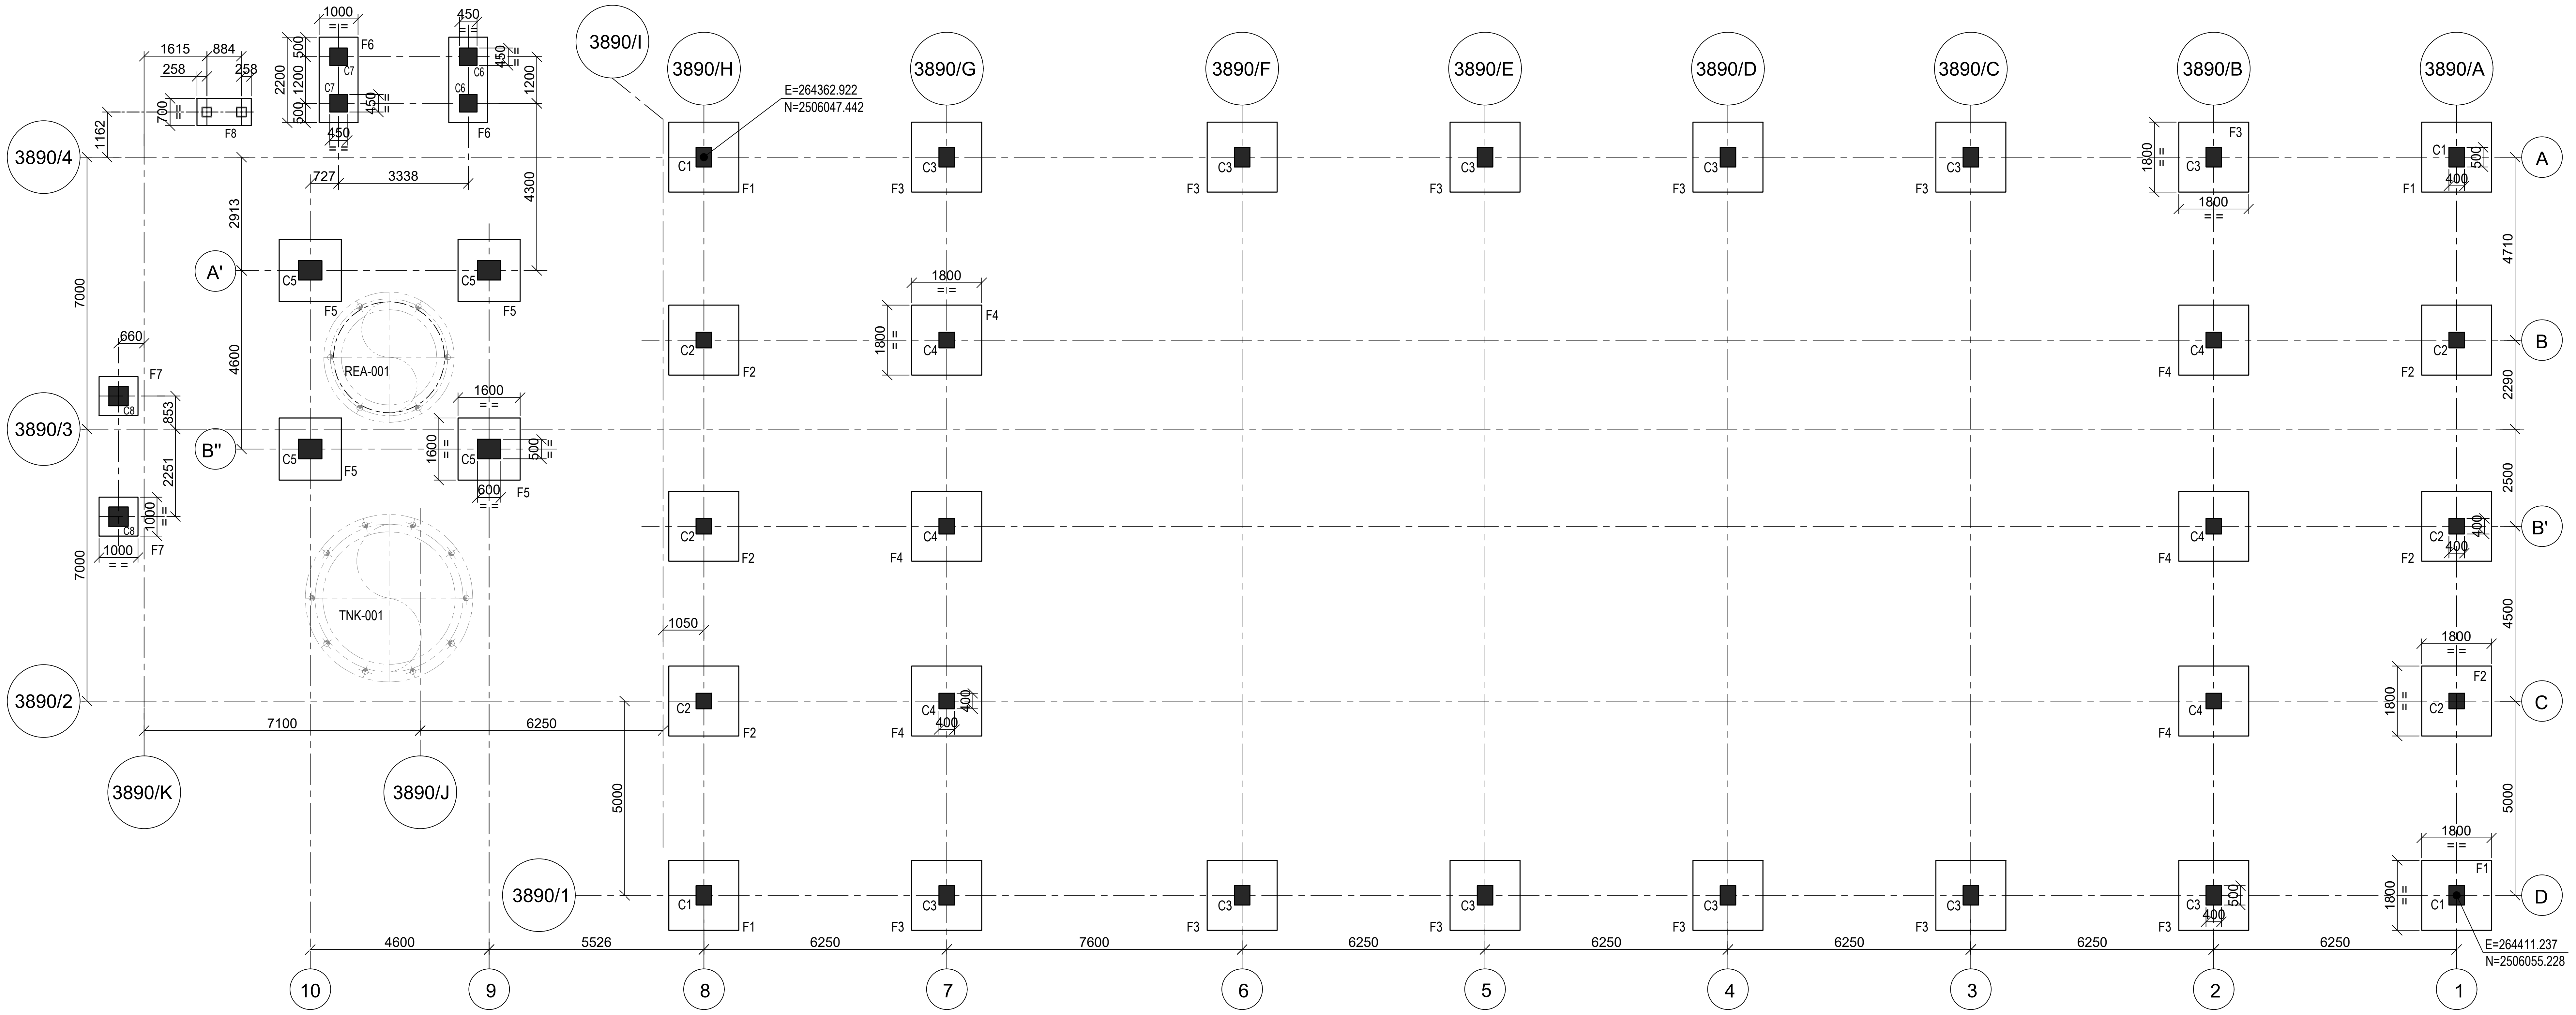

LAYOUT OF FOUNDATION
SCALE 1:100

LEGEND :-

R.L. - REDUCED LEVEL
T.O.C. - TOP OF CONCRETE.
F.G.L. - FINISHED GROUND LEVEL.
B.O.F. - BOTTOM OF FOUNDATION
TYP. - TYPICAL.
P.C.C - PLAIN CEMENT CONCRETE
MKD. - MARKED.
THK. - THICK
FDN. - FOUNDATION
DRG. - DRAWING

NOTES :-

1. ALL DIMENSIONS ARE IN MILLIMETRES AND LEVELS AND CO-ORDINATES ARE IN METRES. UNLESS OTHERWISE STATED.
2. GRADE OF CONCRETE SHALL BE C35.
3. GRADE OF REINFORCEMENT SHALL BE DEFORMED BAR ASTM A615 - GRADE 60 (fy = 420 MPa).
4. NET SAFE BEARING CAPACITY OF SOIL AT BOTTOM OF FOUNDATION CONSIDERED AS MENTION BELOW.
   (a) FOR FOUNDATION MKD. F1 TO F4 & F8 = 590 KN/SQ.M
   (b) FOR FOUNDATION MKD. F5 TO F7 = 325 KN/SQ.M
5. IF ANY PART OF FOUNDATION COMES ON BACKFILL ZONE OF ADJACENT FOUNDATION OR ANY LOOSE POCKETS ARE ENCOUNTERED BELOW FOUNDATION LEVEL THE SAME SHALL BE REMOVED AND FILLED WITH PCC.
6. FOR FOUNDATION BOLT DETAILS REFER. DRG. NO : MD-216-3890-EG-ST-GAD-2364.
7. FOR REINFORCEMENT DETAIL REFER DRG. NO : MD-216-3850-EG-CV-DED-1429.
9. GENERAL NOTE FOR CIVIL WORK REFER DRG. NO : MD-216-1000-EG-CV-DED-1001.

DOCUMENT NUMBER	REFERENCE DOCUMENTS	REV	DATE	REVISION DESCRIPTION	DRN	CHK	ENG	APP	EMP
		D01	17/03/2023	AS-BUILT	SBH	BDA	SUE	AG	
		C04	15/12/2020	ISSUED FOR CONSTRUCTION & REVISED AS MKD. C04	SBH	BDA	SUE	AG	
MD-216-3890-EG-ME-GAD-1002	SECTION A-A, B-B AND C-C	C03	21/11/2020	ISSUED FOR CONSTRUCTION & REVISED AS MKD. C03	SBH	BDA	SUE	AG	
MD-216-3890-EG-ME-GAD-1001	PLAN VIEW	C02	10/11/2020	ISSUED FOR CONSTRUCTION & REVISED AS MKD. C02	SBH	BDA	SUE	AG	
MD-216-3890-EG-CV-GAD-1001	PLAN AT EL. +912.400 AND +911.900	C01	24/07/2020	ISSUED FOR CONSTRUCTION	SBH	BDA	SUE	AG	
MD-216-3890-EG-ST-GAD-2364	COLUMN ANCHOR PLAN & DETAIL	A01	26/06/2020	ISSUED FOR REFERENCE	AMT	BDA	SUE	AG	

RESERVED FOR VENDOR LOGO AND DRAWING NUMBER

LARSEN & TOUBRO

This drawing is the property of LARSEN & TOUBRO and must not be passed on to any person or body not authorized by us to receive it nor be copied or otherwise made use either in full or in part by such person or body without our prior permission in writing.

Outotec

The content of these documents are the sole property of Outotec Oyj. Any rights not expressly granted herein are reserved. Reproduction, transfer or distribution of part or all of the contents in any form without prior written permission of Outotec is prohibited.

MA'ADEN معادن
Saudi Arabian Mining Company شركة التعدين العربية السعودية

This document and the information contained herein is Ma'aden proprietary know-how. This document or any part thereof should not be reproduced, stored in a retrieval system or transmitted by any means, electronic or otherwise, or divulged without prior written permission of Ma'aden.

LARSEN & TOUBRO DRAWING NUMBER 019045_450_C_G_24176_001 REVISION 5
OUTOTEC DRAWING NUMBER 900707 _GAU01 _AA04_MTL01 _38913
DOCUMENT ID OU100688666 REVISION 5

DRAWN	AMT	24/06/2020
CHECKED	BDA	25/06/2020
ENGINEER	SUE	24/06/2020
APPROVED	AG	26/06/2020
EMPLOYER		
SCALE	1:100,1:50,1:20	A1

MANSOURAH - MASSARAH GOLD PROJECT
GENERAL ARRANGEMENT DRAWING
REAGENTS - SMBS & PEROXIDE STORAGE AND MIXING STATION
FOUNDATION PLAN & SECTIONS

DRAWING NUMBER MD - 216 - 3890 - EG - CV - GAD - 1440
REV D01