
DRAWING NUMBER: MD-216-3890-EG-CV-GAD-1441 | REV: D01

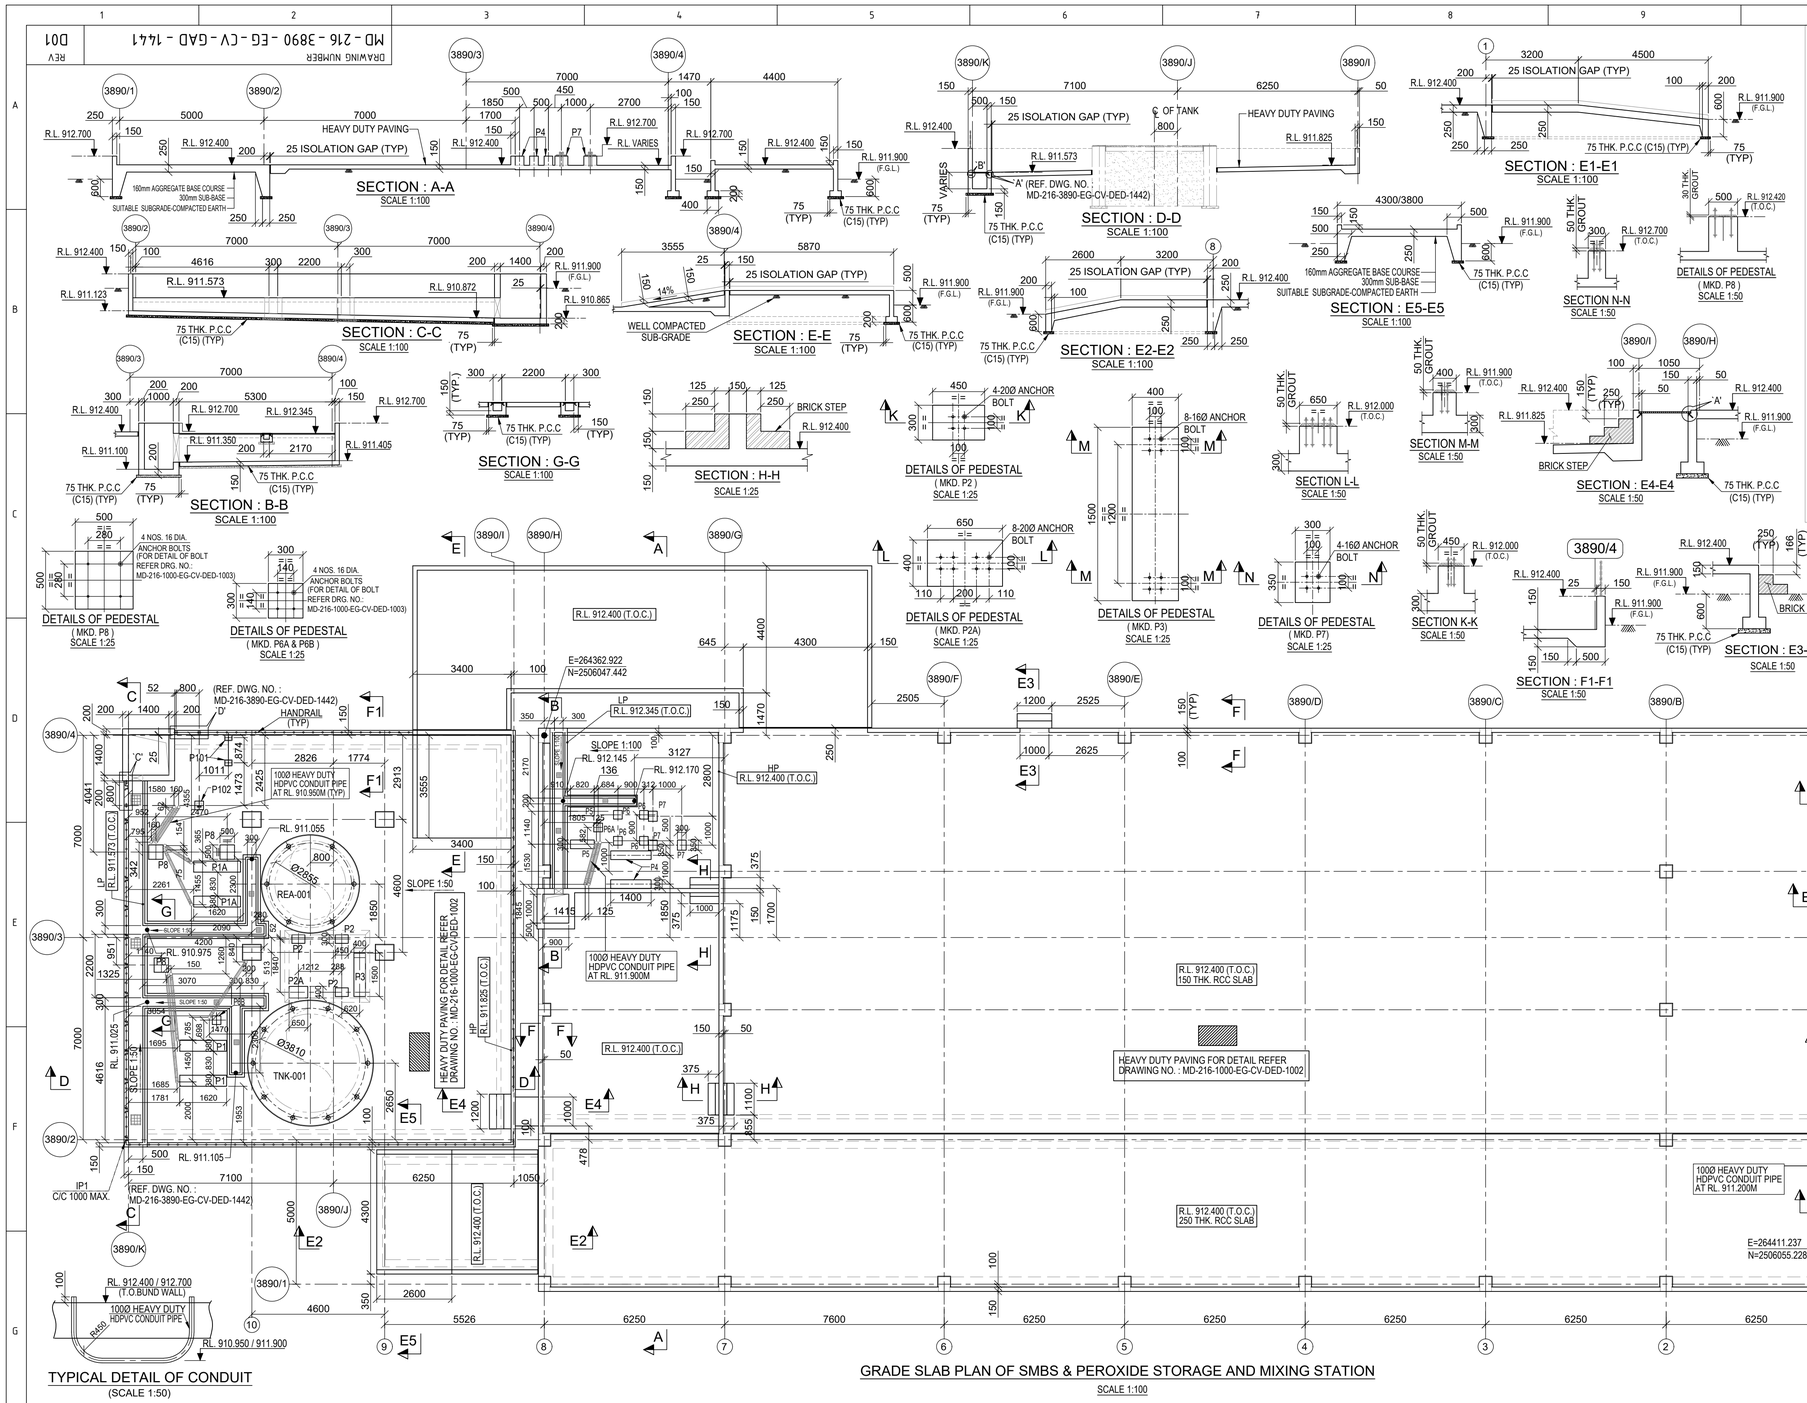

NOTES:-

1. ALL DIMENSIONS ARE IN MILLIMETRES AND LEVELS ARE IN METRES UNLESS OTHERWISE STATED.
2. GRADE OF CONCRETE SHALL BE C35 UNLESS NOTED OTHERWISE.
3. GRADE OF REINFORCEMENT SHALL BE DEFORMED BAR ASTM A615-GRADE 60 (fy=420 MPa)
4. IF ANY PART OF FOUNDATION COMES ON BACKFILL ZONE OF ADJACENT FOUNDATION OR ANY LOOSE POCKETS ARE ENCOUNTERED BELOW FOUNDATION LEVEL THE SAME SHALL BE REMOVED AND FILLED WITH PCC.
5. FOR REINFORCEMENTS DETAIL REF. DRG. NO. MD - 216 - 3890 - EG - CV - DED - 1442.
6. FOR STANDARD DETAILS FOR PAVING REF. DRG. NO : MD-216-1000-EG-CV-DED-1002.
7. FOR FOUNDATION BOLT DETAILS REF. DRG. NO : MD-216-1000-EG-CV-DED-1003.
8. FOR GENERAL NOTE FOR CIVIL WORK REF. DRG. NO : MD-216-1000-EG-CV-DED-1001.
9. CHEMICAL RESISTANT COATING SHALL BE APPLIED TO THE ALL EXPOSED SURFACE OF CONCRETE INSIDE BUND WALL TO PROTECT AGAINST ACID / ALKALI.
10. FOR ELECTRICAL CABLE ROUTE LAYOUT EMBEDDED PART REF. DRG. NO : MD-216-3890-EG-EL-LAD-1003.

LEGEND :-

R.L. - REDUCED LEVEL
T.O.C. - TOP OF CONCRETE.
F.G.L. - FINISHED GROUND LEVEL.
TYP. - TYPICAL.
P.C.C - PLAIN CEMENT CONCRETE
MKD. - MARKED.
THK. - THICK
HP. - HIGHEST POINT
LP. - LOWEST POINT
℄ - CENTRE LINE

DOCUMENT NUMBER	REFERENCE DOCUMENTS	REV	DATE	REVISION DESCRIPTION	DRN	CHK	ENG	APP	EMP
		D01	17/03/2023	AS-BUILT	SBH	BDA	SUE	AG	
		C05	06/03/2021	ISSUED FOR CONSTRUCTION & REVISED AS MKD. C05	SBH	BDA	SUE	AG	
		C04	15/02/2021	ISSUED FOR CONSTRUCTION & REVISED AS MKD. C04	SBH	BDA	SUE	AG	
MD-216-3890-EG-ST-GAD-2364	COLUMN ANCHOR PLAN AND DETAILS	C03	16/12/2020	ISSUED FOR CONSTRUCTION & REVISED AS MKD. C03	SBH	BDA	SUE	AG	
MD-216-3890-EG-ME-GAD-1007	PLAN VIEW	C02	21/11/2020	ISSUED FOR CONSTRUCTION & REVISED AS MKD. C02	AMT	BDA	SUE	AG	
MD-216-3890-EG-ME-GAD-1002	SECTION A-A,B-B & C-C	C01	30/10/2020	ISSUED FOR CONSTRUCTION	AMT	BDA	SUE	AG	
MD-216-3890-EG-ME-GAD-1001	PLAN VIEW	A02	13/10/2020	ISSUED FOR REFERENCE & REVISED AS MKD. A02	AMT	BDA	SUE	AG	
MD-216-3890-EG-CV-GAD-1001	PLAN AT EL. +912.400 AND +911.900	A01	05/09/2020	ISSUED FOR REFERENCE	AMT	BDA	SUE	AG	

RESERVED FOR VENDOR LOGO AND DRAWING NUMBER

LARSEN & TOUBRO DRAWING NUMBER: 019045_450_C_G_24176_002 | REVISION: 7
OUTOTEC DRAWING NUMBER: 900707__GAU01__AA04__MTL01__38914 | DOCUMENT ID: OU100688667 | REVISION: 7

LARSEN & TOUBRO
This drawing is the property of LARSEN & TOUBRO and must not be passed on to any person or body not authorized by us to receive it nor be copied or otherwise made use either in full or in part by such person or body without our prior permission in writing.

Outotec
The content of these documents are the sole property of Outotec Oyj. Any rights not expressly granted herein are reserved. Reproduction, transfer or distribution of part or all of the contents in any form without prior written permission of Outotec is prohibited.

MA'ADEN معادن
Saudi Arabian Mining Company شركة معادن العربية السعودية
This document and the information contained herein is Ma'aden proprietary know-how. This document or any part thereof should not be reproduced, stored in a retrieval system or transmitted by any means, electronic or otherwise, or divulged without prior written permission of Ma'aden.

DRAWN	AMT	03/09/2020	MANSOURAH - MASSARAH GOLD PROJECT
CHECKED	BDA	04/09/2020	GENERAL ARRANGEMENT DRAWING
ENGINEER	SUE	03/09/2020	REAGENTS - SMBS & PEROXIDE STORAGE AND MIXING STATION
APPROVED	AG	05/09/2020	GRADE SLAB
EMPLOYER			
SCALE 1:100,1:50,1:20	A1		DRAWING NUMBER: MD - 216 - 3890 - EG - CV - GAD - 1441 | REV: D01