


DRAWING NUMBER: MD-216-3980-EG-CV-DED-1471 | REV: D01

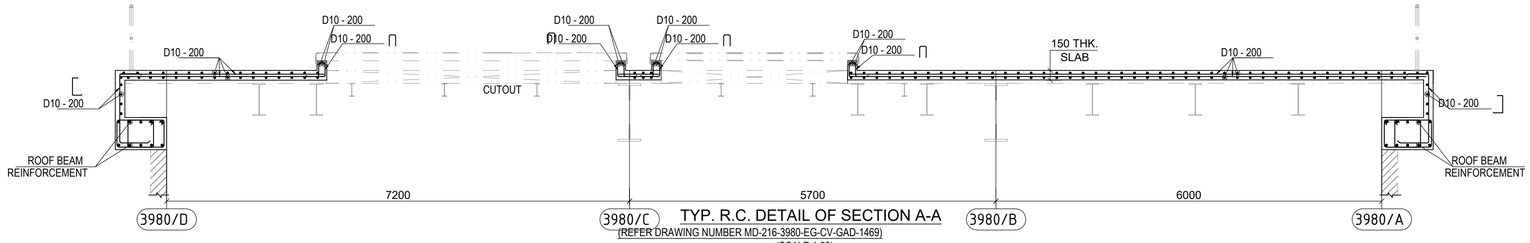


TYP. R.C. DETAIL OF SECTION A-A
(REFER DRAWING NUMBER MD-216-3980-EG-CV-GAD-1469)
(SCALE-1:50)

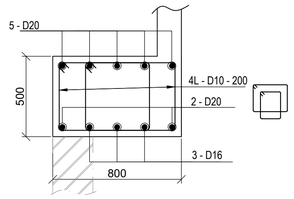


R.C DETAIL OF BEAM MKD. - RB1
(SCALE 1:20)

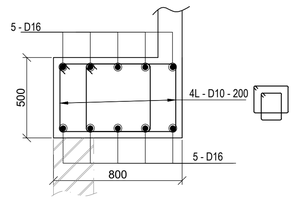


R.C DETAIL OF BEAM MKD. - RB2
(SCALE 1:20)

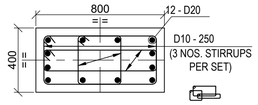


R.C DETAIL OF COLUMN - C1
(SCALE 1:20)

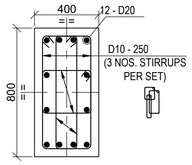


R.C DETAIL OF COLUMN - C2
(SCALE 1:20)

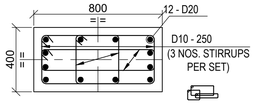


R.C DETAIL OF COLUMN - C3
(SCALE 1:20)

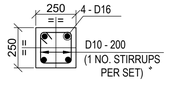


R.C DETAIL OF COLUMN - SC1
(SCALE 1:20)

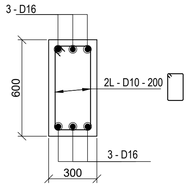


R.C DETAIL OF BEAM MKD. - LB3
(SCALE 1:20)

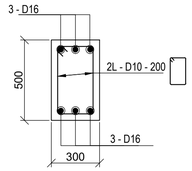


R.C DETAIL OF BEAM MKD. - LB4
(SCALE 1:20)

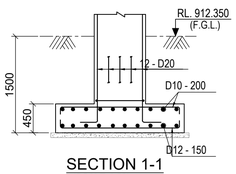


SECTION 1-1
(SCALE-1:50)

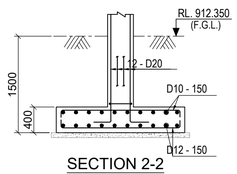


SECTION 2-2
(SCALE-1:50)

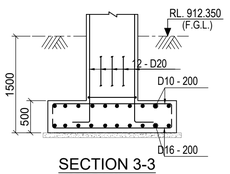


SECTION 3-3
(SCALE-1:50)

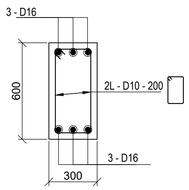


R.C DETAIL OF BEAM MKD. - LB1
(SCALE 1:20)

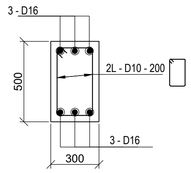


R.C DETAIL OF BEAM MKD. - LB2
(SCALE 1:20)

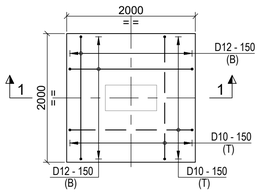


R.C DETAIL OF FOUNDATION - F1
(SCALE 1:50)

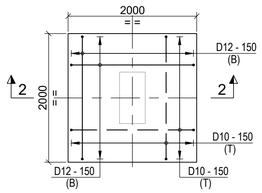


R.C DETAIL OF FOUNDATION - F2
(SCALE 1:50)

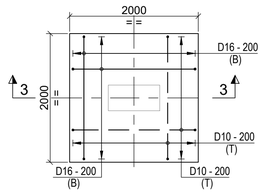

R.C DETAIL OF FOUNDATION - F3
(SCALE 1:50)

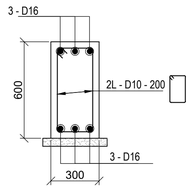

R.C DETAIL OF BEAM MKD. - PB1
(SCALE 1:20)

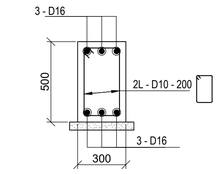

R.C DETAIL OF BEAM MKD. - PB2
(SCALE 1:20)

LEGEND :-

R.L. - REDUCED LEVEL
T.O.C. - TOP OF CONCRETE.
F.G.L. - FINISHED GROUND LEVEL.
B.O.F. - BOTTOM OF FOUNDATION
TYP. - TYPICAL.
R.C. - REINFORCED CONCRETE
P.C.C - PLAIN CEMENT CONCRETE
MKD. - MARKED.
THK. - THICK
BOTTOM REINFORCEMENT (B) - ———
TOP REINFORCEMENT (T) - – – – – –

NOTES:-

1. ALL DIMENSIONS ARE IN MILLIMETRES AND LEVELS AND CO-ORDINATES ARE IN METRES. UNLESS OTHERWISE STATED.
2. GRADE OF CONCRETE SHALL BE C35.
3. GRADE OF REINFORCEMENT SHALL BE DEFORMED BAR ASTM A615 - GRADE 60 (fy = 420 MPa).
4. CLEAR COVER TO MAIN REINFORCEMENT SHALL BE AS FOLLOWS:
   a) FOUNDATION = 70 mm.
   c) COLUMN = 50 mm.
   d) BEAM = 40mm.
   e) SLAB = 20mm.
5. FOR GA DRAWING REFER DRG. NO. MD-216-3980-EG-CV-GAD-1468 & 1469.
6. FOR SPLICE LENGTHS OF REINF. REFER. DWG. NO. MD-261-1000-EG-CV-DED-1001. - CL. NO. 5.3 & 5.4
7. GENERAL NOTE FOR CIVIL WORK REFER DRG. NO : MD-216-1000-EG-CV-DED-1001.
8. FOR STANDARD REINF. DETAIL REFER DRG. NO : MD-216-1000-EG-CV-DED-1005.
9. REINFORCEMENT MAY BE SLIGHTLY ADJUSTED AT SITE TO ACCOMMODATE EMBEDDED PART.

DOCUMENT NUMBER	REFERENCE DOCUMENTS	REV	DATE	REVISION DESCRIPTION	DRN	CHK	ENG	APP	EMP
		D01	22/02/2023	AS-BUILT	SBH	BDA	SUE	AG	
		C01	16/07/2020	ISSUED FOR CONSTRUCTION	SBH	BDA	SUE	AG	
		A01	23/06/2020	ISSUED FOR REFERENCE	SBH	BDA	SUE	AG	

RESERVED FOR VENDOR LOGO AND DRAWING NUMBER

This drawing is the property of LARSEN & TOUBRO and must not be passed on to any person or body not authorized by us to receive it nor be copied or otherwise made use either in full or in part by such person or body without our prior permission in writing.

The content of these documents are the sole property of Outotec Oyj. Any rights not expressly granted herein are reserved. Reproduction, transfer or distribution of part or all of the contents in any form without prior written permission of Outotec is prohibited.

This document and the information contained herein is Ma'aden proprietary know-how. This document or any part thereof should not be reproduced, stored in a retrieval system or transmitted by any means, electronic or otherwise, or divulged without prior written permission of Ma'aden.

LARSEN & TOUBRO DRAWING NUMBER	O19045_080_C_D_24198_001	REVISION 2
OUTOTEC DRAWING NUMBER	900707 _GAU01 _AG22_CTB17 _39841	DOCUMENT ID OU100687644 / REVISION 2

DRAWN	SBH	20/06/2020
CHECKED	BDA	22/06/2020
ENGINEER	SUE	20/06/2020
APPROVED	AG	23/06/2020
EMPLOYER		
SCALE	1:30	A1

MANSOURAH - MASSARAH GOLD PROJECT
DETAIL DRAWING
OXYGEN PLANT
COMPRESSOR ROOM RC DETAILS

DRAWING NUMBER: MD-216-3980-EG-CV-DED-1471 | REV: D01