


DRAWING NUMBER MD-216-3980-EG-CV-DED-1475 REV D01

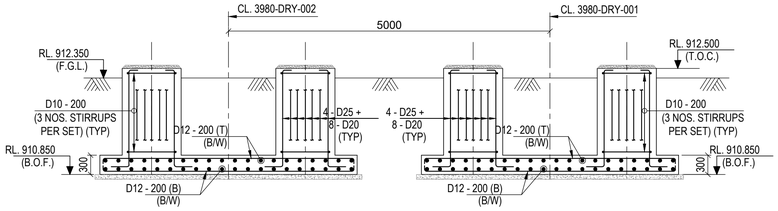

R.C DETAIL OF SECTION A-A
(SCALE - 1:50)

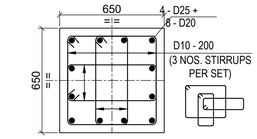

R.C DETAIL OF COLUMN - C1
(SCALE 1:20)

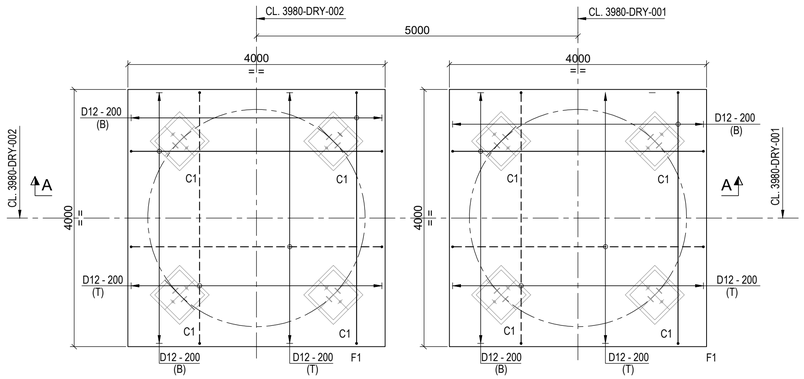

R.C DETAIL OF ADSORBER FOUNDATION
(SCALE - 1:50)

LEGEND :-

R.L. - REDUCED LEVEL
T.O.C. - TOP OF CONCRETE.
F.G.L. - FINISHED GROUND LEVEL.
B.O.F. - BOTTOM OF FOUNDATION
TYP. - TYPICAL.
R.C. - REINFORCED CONCRETE
P.C.C - PLAIN CEMENT CONCRETE
THK. - THICK
B/W - BOTH WAYS
DRG. - DRAWING
CL. - CENTRE LINE
BOTTOM REINFORCEMENT (B) -
TOP REINFORCEMENT (T) -

NOTES :-

1. ALL DIMENSIONS ARE IN MILLIMETRES AND LEVELS ARE IN METRES UNLESS OTHERWISE STATED.
2. GRADE OF CONCRETE SHALL BE C35 FOR FOUNDATION.
3. GRADE OF REINFORCEMENT SHALL BE DEFORMED BAR ASTM A615 - GRADE 60 (fy = 420 MPa).
4. CLEAR COVER TO MAIN REINFORCEMENT SHALL BE
   a) FOUNDATION = 75 mm (BOTTOM & SIDE) 50 mm. (TOP)
   b) COLUMN & PEDESTAL = 50mm
5. FOR LAP LENGTHS REFER DRG. NO. MD-216-1000-EG-CV-DED-1001.
6. READ THIS DRAWING IN CONJUNCTION WITH DRG: MD-216-3980-EG-CV-GAD-1473.

DOCUMENT NUMBER	REFERENCE DOCUMENTS	REV	DATE	REVISION DESCRIPTION	DRN	CHK	ENG	APP	EMP
		D01	22/02/2023	AS-BUILT	APM	BDA	STY	AG	
		C01	28/07/2020	ISSUED FOR CONSTRUCTION	APM	BDA	STY	AG	
MD-216-3980-EG-CV-GAD-V551-1479	FOUNDATION LOAD & ANCHORAGE- ADSORBERS	A01	29/06/2020	ISSUED FOR REFERENCE	APM	BDA	STY	AG	

RESERVED FOR VENDOR LOGO AND DRAWING NUMBER

LARSEN & TOUBRO DRAWING NUMBER: 019045_080_C_D_24198_005 — REVISION: 2
OUTOTEC DRAWING NUMBER: 900707__GAU01__AG22__CTB17__39815 — DOCUMENT ID: OU100670672 — REVISION: 2

LARSEN & TOUBRO
This drawing is the property of LARSEN & TOUBRO and must not be passed on to any person or body not authorized by us to receive it nor be copied or otherwise made use either in full or in part by such person or body without our prior permission in writing.

Outotec
The content of these documents are the sole property of Outotec Oyj. Any rights not expressly granted herein are reserved. Reproduction, transfer or distribution of part or all of the contents in any form without prior written permission of Outotec is prohibited.

MA'ADEN معادن
Saudi Arabian Mining Company شركة التعدين العربية السعودية
This document and the information contained herein is Ma'aden proprietary know-how. This document or any part thereof should not be reproduced, stored in a retrieval system or transmitted by any means, electronic or otherwise, or divulged without prior written permission of Ma'aden.

DRAWN	APM	23/06/2020
CHECKED	BDA	25/06/2020
ENGINEER	STY	23/06/2020
APPROVED	AG	29/06/2020
EMPLOYER		
SCALE	1:100, 1:50	A1

MANSOURAH - MASSARAH GOLD PROJECT
DETAIL DRAWING
OXYGEN PLANT
ADSORBERS FOUNDATION

DRAWING NUMBER: MD-216-3980-EG-CV-DED-1475 — REV: D01