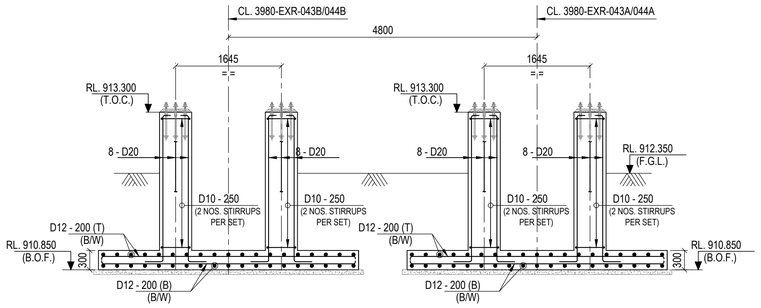
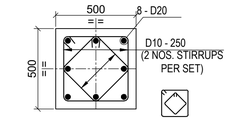
DRAWING NUMBER MD-216-3980-EG-CV-DED-1478 REV D01



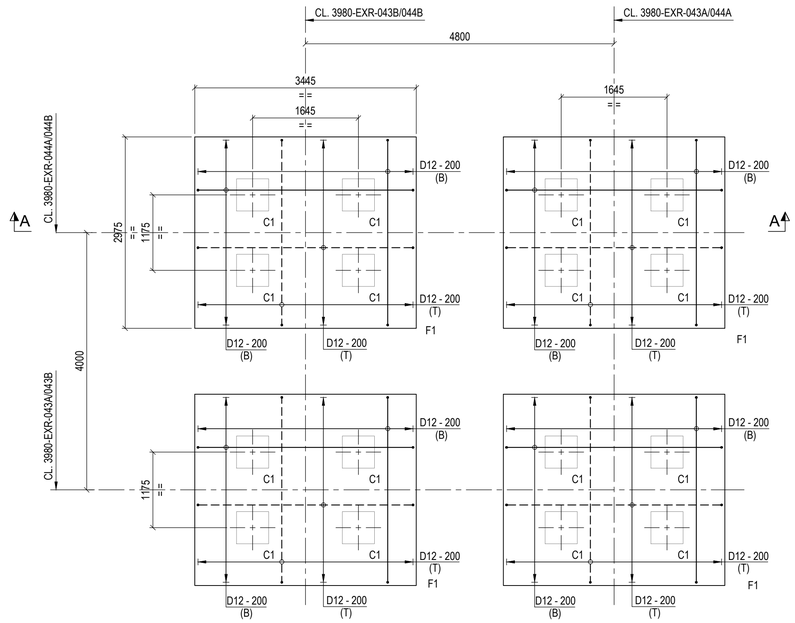

R.C. DETAIL OF SECTION A-A

(SCALE - 1:50)




R.C DETAIL OF COLUMN - C1

(SCALE 1:20)




R.C PLAN FOR OXYGEN VAPORIZER FOUNDATION

(SCALE - 1:50)

## LEGEND :-

R.L. - REDUCED LEVEL
T.O.C. - TOP OF CONCRETE.
F.G.L. - FINISHED GROUND LEVEL.
B.O.F. - BOTTOM OF FOUNDATION
R.C. - REINFORCED CONCRETE
CL. - CENTRE LINE
THK. - THICK
B/W - BOTH WAYS
DRG. - DRAWING
TYP. - TYPICAL
NOS. - NUMBER
BOTTOM REINFORCEMENT (B) - _____
TOP REINFORCEMENT (T) - - - - - - - - - -

## NOTES :-

1. ALL DIMENSIONS ARE IN MILLIMETRES AND LEVELS ARE IN METRES UNLESS OTHERWISE STATED.
2. GRADE OF CONCRETE SHALL BE C35 FOR FOUNDATION.
3. GRADE OF REINFORCEMENT SHALL BE DEFORMED BAR ASTM A615 - GRADE 60 (fy = 420 MPa).
4. CLEAR COVER TO MAIN REINFORCEMENT SHALL BE AS
   a) FOUNDATION = 75 mm (BOTTOM & SIDE) 50 mm. (TOP)
   b) COLUMN = 50mm
5. FOR LAP LENGTHS REFER DRG. NO. MD-216-1000-EG-CV-DED-1001.
6. READ THIS DRAWING IN CONJUNCTION WITH DRG: MD-216-3980-EG-CV-GAD-1476.

| DOCUMENT NUMBER | REFERENCE DOCUMENTS | REV | DATE | REVISION DESCRIPTION | DRN | CHK | ENG | APP | EMP |
|---|---|---|---|---|---|---|---|---|---|
| | | D01 | 22/02/2023 | AS-BUILT | APM | BDA | STY | AG | |
| | | C01 | 12/09/2020 | ISSUED FOR CONSTRUCTION | APM | BDA | STY | AG | |
| MD-216-3980-EG-CV-GAD-V551-1492 | FOUNDATION LOAD -LIQUID OOXGEN VAPORIZER | A01 | 12/08/2020 | ISSUED FOR REFERENCE | APM | BDA | STY | AG | |

RESERVED FOR VENDOR LOGO AND DRAWING NUMBER

LARSEN & TOUBRO

This drawing is the property of LARSEN & TOUBRO and must not be passed on to any person or body not authorized by us to receive it nor be copied or otherwise made use either in full or in part by such person or body without our prior permission in writing.

Outotec

The content of these documents are the sole property of Outotec Oyj. Any rights not expressly granted herein are reserved. Reproduction, transfer or distribution of part or all of the contents in any form without prior written permission of Outotec is prohibited.

MA'ADEN معادن
Saudi Arabian Mining Company شركة التعدين العربية السعودية

This document and the information contained herein is Ma'aden proprietary know-how. This document or any part thereof should not be reproduced, stored in a retrieval system or transmitted by any means, electronic or otherwise, or divulged without prior written permission of Ma'aden.

LARSEN & TOUBRO DRAWING NUMBER: 019045_080_C_D_24198_008 — REVISION: 2

OUTOTEC DRAWING NUMBER: 900707__GAU01__AG22__CTB17__39818 — DOCUMENT ID: OU100670675 — REVISION: 2

| | | |
|---|---|---|
| DRAWN | APM | 04/08/2020 |
| CHECKED | BDA | 05/08/2020 |
| ENGINEER | STY | 04/08/2020 |
| APPROVED | AG | 12/08/2020 |
| EMPLOYER | | |
| SCALE | 1:100, 1:50 | A1 |

MANSOURAH - MASSARAH GOLD PROJECT
DETAIL DRAWING
OXYGEN PLANT
LIQUID OXYGEN VAPORIZER FOUNDATION

DRAWING NUMBER: MD-216-3980-EG-CV-DED-1478 — REV: D01