


DRAWING NUMBER MD-216-3980-EG-CV-DED-1479 REV D01

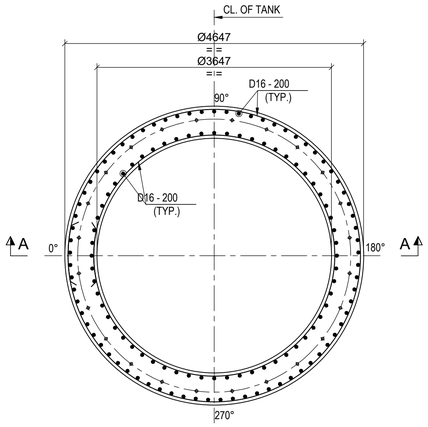


R.C.C DETAIL OF TANK WALL
(SCALE - 1:50)

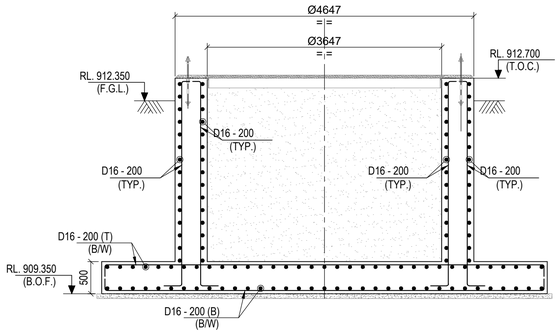


R.C.C DETAIL OF SECTION A-A
(SCALE - 1:50)

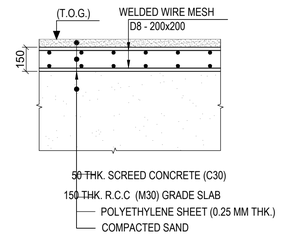

R.C.C DETAIL OF GRADE SLAB
(SCALE - 1:20)

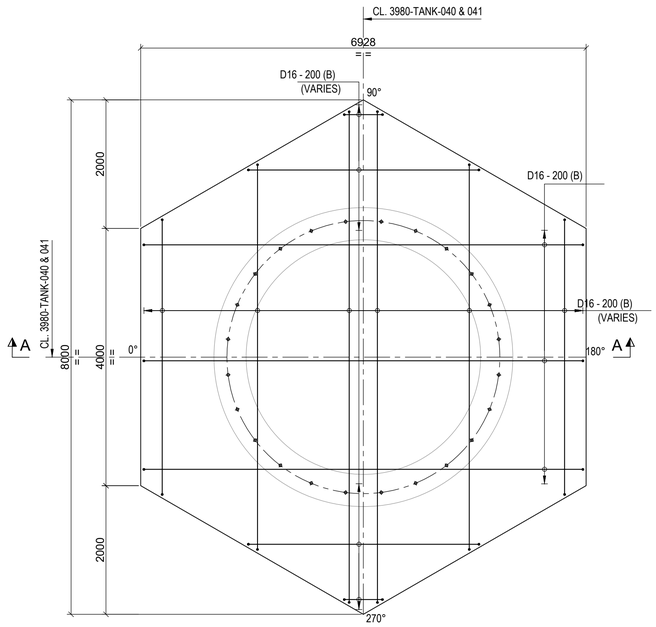

R.C.C DETAIL OF TANK FOUNDATION BOTTOM LEVEL
(SCALE - 1:50)

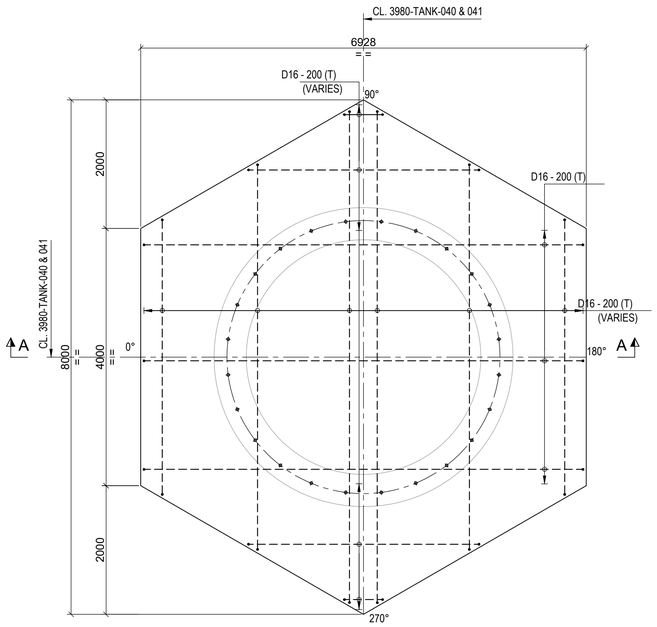

R.C.C DETAIL OF TANK FOUNDATION TOP LEVEL
(SCALE - 1:50)

LEGEND :-

R.L. - REDUCED LEVEL
T.O.C. - TOP OF CONCRETE.
T.O.G. - TOP OF GROUT.
F.G.L. - FINISHED GROUND LEVEL.
B.O.F. - BOTTOM OF FOUNDATION
TYP. - TYPICAL.
R.C.C - REINFORCED CEMENT CONCRETE
P.C.C - PLAIN CEMENT CONCRETE
THK. - THICK
B/W - BOTH WAYS
DRG. - DRAWING
CL. - CENTRE LINE
Ø - DIAMETER
NO. - NUMBER
BOTTOM REINFORCEMENT (B) -
TOP REINFORCEMENT (T) -

NOTES :-

1. ALL DIMENSIONS ARE IN MILLIMETRES AND LEVELS ARE IN METRES UNLESS OTHERWISE STATED.
2. GRADE OF CONCRETE SHALL BE C35 FOR FOUNDATION.
3. GRADE OF REINFORCEMENT SHALL BE DEFORMED BAR ASTM A615 - GRADE 60 (fy = 420 MPa).
4. CLEAR COVER TO MAIN REINFORCEMENT SHALL BE
   a) FOUNDATION = 75 mm (BOTTOM & SIDE) 50 mm. (TOP)
   b) WALL = 50mm
5. FOR LAP LENGTHS REFER DRG. NO. MD-216-1000-EG-CV-DED-1001.
6. READ THIS DRAWING IN CONJUNCTION WITH DRG NO. : MD-216-3980-EG-CV-GAD-1477.

DOCUMENT NUMBER	REFERENCE DOCUMENTS	REV	DATE	REVISION DESCRIPTION	DRN	CHK	ENG	APP	EMP
		D01	22/02/2023	AS-BUILT	APM	BDA	STY	AG	
		C02	16/09/2020	ISSUED FOR CONSTRUCTION AND REVISED AS MARKED	APM	BDA	STY	AG	
		C01	22/08/2020	ISSUED FOR CONSTRUCTION	APM	BDA	STY	AG	
MD-216-3980-EG-CV-GAD-V551-1490	FOUNDATION LOAD & ANCHORAGE- LOX TANK	A01	30/07/2020	ISSUED FOR REFERENCE	APM	BDA	STY	AG	

RESERVED FOR VENDOR LOGO AND DRAWING NUMBER

LARSEN & TOUBRO
This drawing is the property of LARSEN & TOUBRO and must not be passed on to any person or body not authorized by us to receive it nor be copied or otherwise made use either in full or in part by such person or body without our prior permission in writing.

Outotec
The content of these documents are the sole property of Outotec Oyj. Any rights not expressly granted herein are reserved. Reproduction, transfer or distribution of part or all of the contents in any form without prior written permission of Outotec is prohibited.

MA'ADEN معادن
Saudi Arabian Mining Company شركة التعدين العربية السعودية
This document and the information contained herein is Ma'aden proprietary know-how. This document or any part thereof should not be reproduced, stored in a retrieval system or transmitted by any means, electronic or otherwise, or divulged without prior written permission of Ma'aden.

LARSEN & TOUBRO DRAWING NUMBER: O19045_080_C_D_24198_009 — REVISION: 3
OUTOTEC DRAWING NUMBER: 900707__GAU01__AG22__CTB17__39819 — DOCUMENT ID: OU100670676 — REVISION: 3

DRAWN	APM	26/07/2020
CHECKED	BDA	27/07/2020
ENGINEER	STY	26/07/2020
APPROVED	AG	30/07/2020
EMPLOYER		
SCALE	1:100, 1:50	A1

MANSOURAH - MASSARAH GOLD PROJECT
DETAIL DRAWING
OXYGEN PLANT
LOX TANK FOUNDATION

DRAWING NUMBER: MD-216-3980-EG-CV-DED-1479 — REV: D01