

DRAWING NUMBER: MD-216-3980-EG-CV-DED-1480 | REV: D01

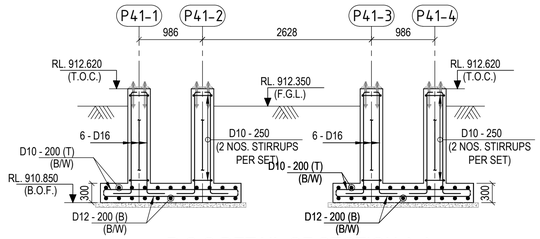


R.C.C DETAIL OF SECTION A-A

(SCALE - 1:50)

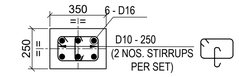

R.C.C DETAIL OF COLUMN - C1

(SCALE 1:20)

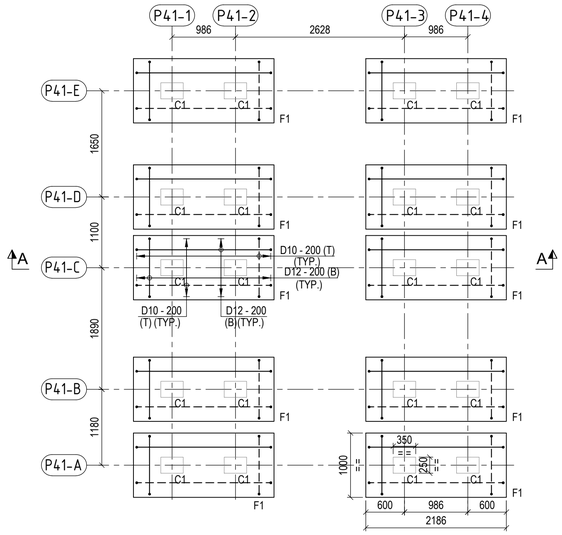

R.C.C PLAN FOR LOX BACK UP PUMP CASING

(SCALE - 1:50)

LEGEND :-

R.L. - REDUCED LEVEL
T.O.C. - TOP OF CONCRETE.
F.G.L. - FINISHED GROUND LEVEL.
B.O.F. - BOTTOM OF FOUNDATION
TYP. - TYPICAL.
R.C.C - REINFORCED CEMENT CONCRETE
THK. - THICK
B/W - BOTH WAYS
DRG. - DRAWING
NOS. - NUMBER
BOTTOM REINFORCEMENT (B) -
TOP REINFORCEMENT (T) -

NOTES :-

1. ALL DIMENSIONS ARE IN MILLIMETRES AND LEVELS ARE IN METRES UNLESS OTHERWISE STATED.
2. GRADE OF CONCRETE SHALL BE C35 FOR FOUNDATION.
3. GRADE OF REINFORCEMENT SHALL BE DEFORMED BAR ASTM A615 - GRADE 60 (fy = 420 MPa).
4. CLEAR COVER TO MAIN REINFORCEMENT SHALL BE
   a) FOUNDATION = 75 mm (BOTTOM & SIDE) 50 mm. (TOP)
   b) COLUMN = 50mm
5. FOR LAP LENGTHS REFER DRG. NO. MD-216-1000-EG-CV-DED-1001.
6. READ THIS DRAWING IN CONJUNCTION WITH DRG NO. : MD-216-3980-EG-CV-GAD-1478.

DOCUMENT NUMBER	REFERENCE DOCUMENTS	REV	DATE	REVISION DESCRIPTION	DRN	CHK	ENG	APP	EMP
		D01	22/02/2023	AS-BUILT	APM	BDA	STY	AG	
		C01	04/09/2020	ISSUED FOR CONSTRUCTION	APM	BDA	STY	AG	
MD-216-3980-EG-CV-GAD-V551-1491	FOUNDATION LOAD -LOX BACK UP PUMP CASING	A01	03/08/2020	ISSUED FOR REFERENCE	APM	BDA	STY	AG	

RESERVED FOR VENDOR LOGO AND DRAWING NUMBER

LARSEN & TOUBRO

This drawing is the property of LARSEN & TOUBRO and must not be passed on to any person or body not authorized by us to receive it nor be copied or otherwise made use either in full or in part by such person or body without our prior permission in writing.

Outotec

The content of these documents are the sole property of Outotec Oyj. Any rights not expressly granted herein are reserved. Reproduction, transfer or distribution of part or all of the contents in any form without prior written permission of Outotec is prohibited.

MA'ADEN معادن
Saudi Arabian Mining Company شركة التعدين العربية السعودية

This document and the information contained herein is Ma'aden proprietary know-how. This document or any part thereof should not be reproduced, stored in a retrieval system or transmitted by any means, electronic or otherwise, or divulged without prior written permission of Ma'aden.

LARSEN & TOUBRO DRAWING NUMBER		REVISION
019045_080_C_D_24198_010		2
OUTOTEC DRAWING NUMBER	DOCUMENT ID	REVISION
900707__GAU01__AG22__CTB17__39820	OU100670677	2

DRAWN	APM	31/07/2020
CHECKED	BDA	01/08/2020
ENGINEER	STY	31/07/2020
APPROVED	AG	03/08/2020
EMPLOYER		
SCALE	1:100, 1:50	A1

MANSOURAH - MASSARAH GOLD PROJECT
DETAIL DRAWING
OXYGEN PLANT
LOX BACK UP PUMP CASING FOUNDATION

DRAWING NUMBER: MD-216-3980-EG-CV-DED-1480 | REV: D01