


DRAWING NUMBER: MD-216-3980-EG-CV-DED-1482
REV: D01

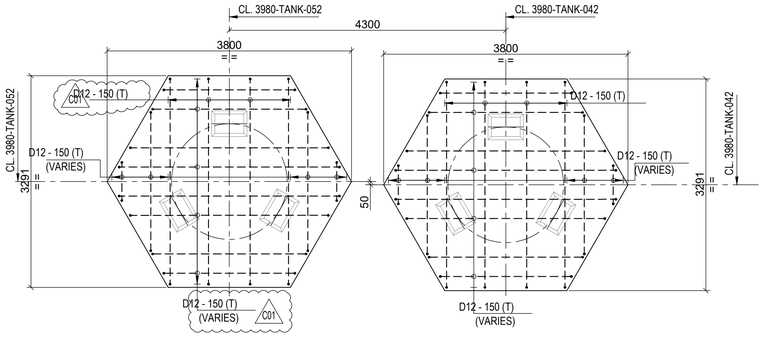


R.C DETAIL OF FOUNDATION FOR TOP LEVEL
(SCALE - 1:50)

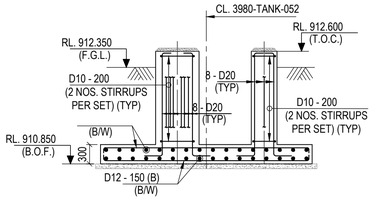


R.C DETAIL OF SECTION A-A
(SCALE - 1:50)

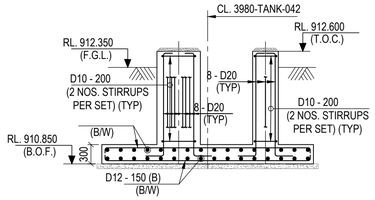

R.C DETAIL OF SECTION B-B
(SCALE - 1:50)

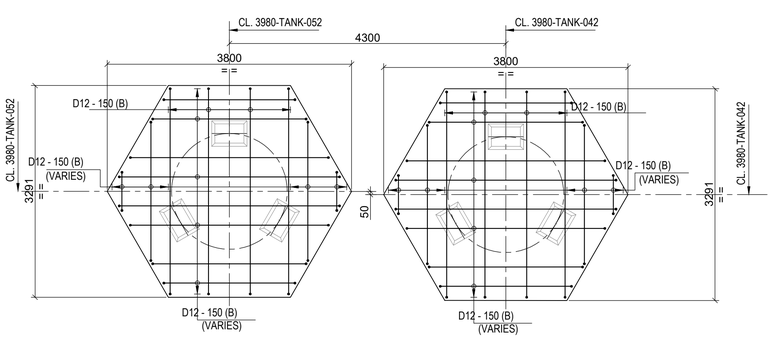

R.C DETAIL OF FOUNDATION FOR BOTTOM LEVEL
(SCALE - 1:50)

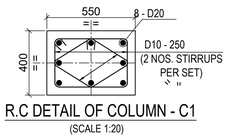

R.C DETAIL OF COLUMN - C1
(SCALE 1:20)

LEGEND :-

R.L. - REDUCED LEVEL
T.O.C. - TOP OF CONCRETE.
F.G.L. - FINISHED GROUND LEVEL.
B.O.F. - BOTTOM OF FOUNDATION
TYP. - TYPICAL.
R.C. - REINFORCED CONCRETE
P.C.C - PLAIN CEMENT CONCRETE
THK. - THICK
B/W - BOTH WAYS
DRG. - DRAWING
CL. - CENTRE LINE
BOTTOM REINFORCEMENT (B) -
TOP REINFORCEMENT (T) -

NOTES :-

1. ALL DIMENSIONS ARE IN MILLIMETRES AND LEVELS ARE IN METRES UNLESS OTHERWISE STATED.
2. GRADE OF CONCRETE SHALL BE C35 FOR FOUNDATION.
3. GRADE OF REINFORCEMENT SHALL BE DEFORMED BAR ASTM A615 - GRADE 60 (fy = 420 MPa).
4. CLEAR COVER TO MAIN REINFORCEMENT SHALL BE
   a) FOUNDATION = 75 mm (BOTTOM & SIDE) 50 mm. (TOP)
   b) COLUMN & PEDESTAL = 50mm
5. FOR LAP LENGTHS REFER DRG. NO. MD-216-1000-EG-CV-DED-1001.
6. READ THIS DRAWING IN CONJUNCTION WITH DRG: MD-216-3980-EG-CV-GAD-1480.

DOCUMENT NUMBER	REFERENCE DOCUMENTS	REV	DATE	REVISION DESCRIPTION	DRN	CHK	ENG	APP	EMP
		D01	22/02/2023	AS-BUILT	APM	BDA	STY	AG	
		C01	03/08/2020	ISSUED FOR CONSTRUCTION & REVISED AS PE EMPLOYER'S	APM	BDA	STY	AG	
MD-216-3980-EG-CV-GAD-V551-1494	FOUNDATION LOAD & ANCHORAGE- LIN TANK			COMMENT DATED 30/07/2020.					
MD-216-3980-EG-CV-GAD-V551-1493	FOUNDATION LOAD & ANCHORAGE- HP LOX TANK	A01	07/07/2020	ISSUED FOR REFERENCE	APM	BDA	STY	AG	

RESERVED FOR VENDOR LOGO AND DRAWING NUMBER

LARSEN & TOUBRO

This drawing is the property of LARSEN & TOUBRO and must not be passed on to any person or body not authorized by us to receive it nor be copied or otherwise made use either in full or in part by such person or body without our prior permission in writing.

Outotec

The content of these documents are the sole property of Outotec Oyj. Any rights not expressly granted herein are reserved. Reproduction, transfer or distribution of part or all of the contents in any form without prior written permission of Outotec is prohibited.

MA'ADEN معادن
Saudi Arabian Mining Company شركة التعدين العربية السعودية

This document and the information contained herein is Ma'aden proprietary know-how. This document or any part thereof should not be reproduced, stored in a retrieval system or transmitted by any means, electronic or otherwise, or divulged without prior written permission of Ma'aden.

LARSEN & TOUBRO DRAWING NUMBER	019045_080_C_D_24198_012	REVISION 2
OUTOTEC DRAWING NUMBER	900707__GAU01__AG22__CTB17__39822	DOCUMENT ID OU100670679 / REVISION 2

DRAWN	APM	29/06/2020
CHECKED	BDA	30/06/2020
ENGINEER	STY	29/06/2020
APPROVED	AG	07/07/2020
EMPLOYER		
SCALE	1:100, 1:50	A1

MANSOURAH - MASSARAH GOLD PROJECT
DETAIL DRAWING
OXYGEN PLANT
HP LOX TANK & LIN TANK FOUNDATION

DRAWING NUMBER: MD-216-3980-EG-CV-DED-1482
REV: D01