


DRAWING NUMBER: MD-216-3980-EG-CV-DED-1485 | REV: D01

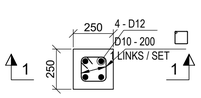


RC. DET. OF COLUMN
MKD. C1
SCALE 1:20

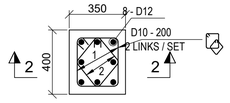


RC. DET. OF COLUMN
MKD. C2
SCALE 1:20

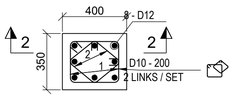


RC. DET. OF COLUMN
MKD. C3
SCALE 1:20

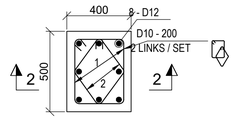


RC. DET. OF COLUMN
MKD. C4, C6 & C7
SCALE 1:20

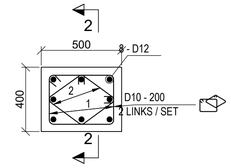


RC. DET. OF COLUMN
MKD. C5
SCALE 1:20

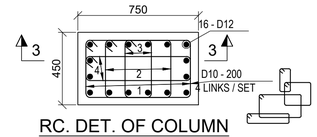


RC. DET. OF COLUMN
MKD. C8
SCALE 1:20

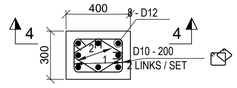


RC. DET. OF COLUMN
MKD. C9
SCALE 1:20

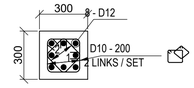


RC. DET. OF COLUMN
MKD. C10
SCALE 1:20

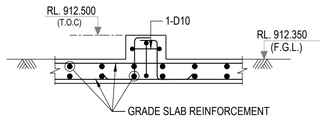


SECTION : 1-1
SCALE 1:20

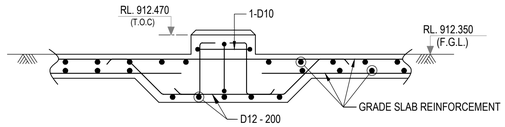


SECTION : 2-2
SCALE 1:20

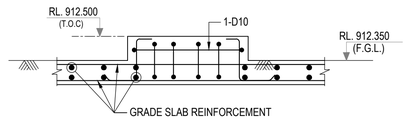


SECTION : 3-3
SCALE 1:20

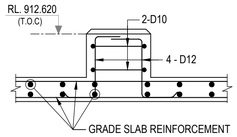


SECTION : 4-4
SCALE 1:20

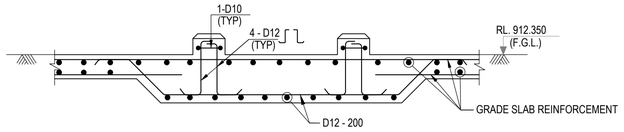


RC. DET. OF PEDESTAL
MKD. P1 TO P4
SCALE 1:20

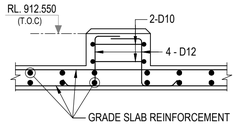


RC. DET. OF PEDESTAL
MKD. P5 & P6
SCALE 1:20

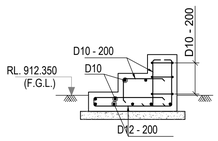

RC DETAIL OF CONCRETE STEP
MKD. - CSP1
(SCALE - 1:30)

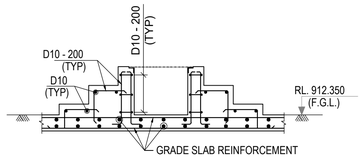

RC DETAIL OF CONCRETE CROSS OVER
MKD. - CCR1
(SCALE - 1:30)

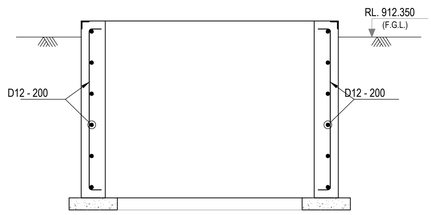

RC. DET. OF VAPORIZATION PIT
MKD. VP1 & VP2
SCALE 1:20

LEGENDS :-

R.L. - REDUCED LEVEL
℄ - CENTRE LINE
T.O.C. - TOP OF CONCRETE
T.O.G. - TOP OF GROUT
TYP. - TYPICAL
F.G.L. - FINISHED GROUND LEVEL
F.F.L. - FINISHED FLOOR LEVEL
B.O.F. - BOTTOM OF FOUNDATION
MKD. - MARKED
THK. - THICK
BOTTOM REINFORCEMENT (B) -
TOP REINFORCEMENT (T) -
R.C. - REINFORCED CONCRETE
P.C.C - PLAIN CEMENT CONCRETE
FDN. - FOUNDATION
DET. - DETAIL
COL. - COLUMN
DIA - DIAMETER
REF. - REFER
DRG. - DRAWING

NOTES :-

1. ALL DIMENSIONS ARE IN MILLIMETRES AND LEVELS AND CO-ORDINATES ARE IN METRES. UNLESS OTHERWISE STATED.
2. GRADE OF CONCRETE SHALL BE C35 .
3. GRADE OF REINFORCEMENT SHALL BE DEFORMED BAR 420 MPa (GRADE 60)
4. CLEAR COVER TO MAIN REINFORCEMENT SHALL BE COLUMNS / PEDESTALS = 50 MM.
5. GENERAL NOTES FOR CIVIL WORKS & STANDARD REINFORCEMENT DETAIL REFER DRAWING NO. MD-216-1000-EG-CV-DED-1001 & 1005.
6. FOR STANDARD DETAILS FOR PAVING REF. DRG. NO : MD-216-1000-EG-CV-DED-1002.

DOCUMENT NUMBER	REFERENCE DOCUMENTS	REV	DATE	REVISION DESCRIPTION	DRN	CHK	ENG	APP	EMP
MD-216-3980-EG-CV-GAD-V551-1503	FOUNDATION LOAD-PIPE & TRAY SUPPORT SHT-6								
MD-216-3980-EG-CV-GAD-V551-1502	FOUNDATION LOAD-PIPE & TRAY SUPPORT SHT-5								
MD-216-3980-EG-CV-GAD-V551-1501	FOUNDATION LOAD-PIPE & TRAY SUPPORT SHT-4								
MD-216-3980-EG-CV-GAD-V551-1499	FOUNDATION LOAD-PIPE & TRAY SUPPORT SHT-3	D01	22/02/2023	AS-BUILT	AMT	BDA	STY	AG	
MD-216-3980-EG-CV-GAD-V551-1498	FOUNDATION LOAD-PIPE & TRAY SUPPORT SHT-2	C01	26/03/2021	ISSUED FOR CONSTRUCTION	AMT	BDA	STY	AG	
MD-216-3980-EG-CV-GAD-V551-1487	FOUNDATION LOAD-PIPE & TRAY SUPPORT SHT-1	A01	18/02/2021	ISSUED FOR REVIEW	AMT	BDA	STY	AG	

RESERVED FOR VENDOR LOGO AND DRAWING NUMBER

LARSEN & TOUBRO
This drawing is the property of LARSEN & TOUBRO and must not be passed on to any person or body not authorized by us to receive it nor be copied or otherwise made use either in full or in part by such person or body without our prior permission in writing.

Outotec
The content of these documents are the sole property of Outotec Oyj. Any rights not expressly granted herein are reserved. Reproduction, transfer or distribution of part or all of the contents in any form without prior written permission of Outotec is prohibited.

MA'ADEN معادن
Saudi Arabian Mining Company شركة التعدين العربية السعودية
This document and the information contained herein is Ma'aden proprietary know-how. This document or any part thereof should not be reproduced, stored in a retrieval system or transmitted by any means, electronic or otherwise, or divulged without prior written permission of Ma'aden.

LARSEN & TOUBRO DRAWING NUMBER			REVISION
O19045_080_C_D_24198_015			2
OUTOTEC DRAWING NUMBER		DOCUMENT ID	REVISION
900707__GAU01__AG22__CTB17__39825		OU100670682	2
DRAWN	AMT	15/02/2021	MANSOURAH - MASSARAH GOLD PROJECT
CHECKED	BDA	16/02/2021	DETAIL DRAWING
ENGINEER	STY	15/02/2021	OXYGEN PLANT
APPROVED	AG	18/02/2021	PIPE & TRAY SUPPORT
EMPLOYER			
SCALE	1:100, 1:50	A1	DRAWING NUMBER: MD-216-3980-EG-CV-DED-1485
			REV: D01