


DRAWING NUMBER: MD - 216 - 3980 - EG - CV - GAD - 1469 | REV: D01

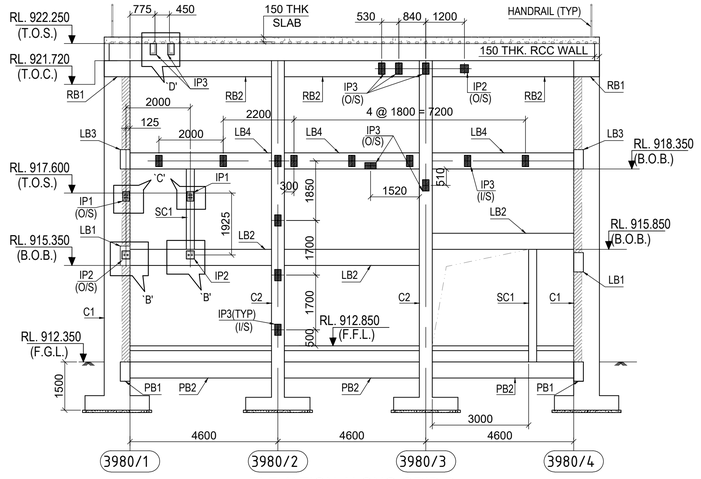


ELEVATION ALONG GRID D
(SCALE 1:100)

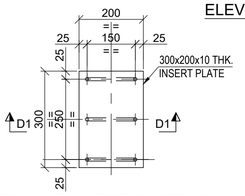


DETAIL OF INSERT PLATE - IP1
(SCALE 1:10)

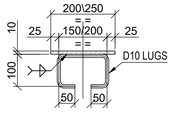


SECTION D1-D1
(SCALE 1:10)

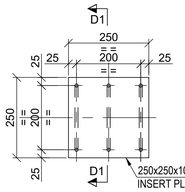


DETAIL OF INSERT PLATE - IP2
(SCALE 1:10)

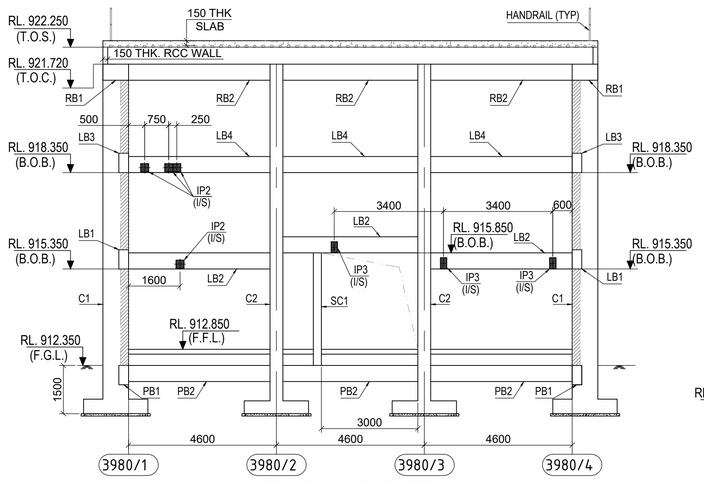


ELEVATION ALONG GRID A
(SCALE 1:100)

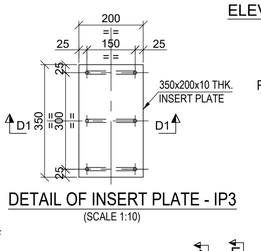


DETAIL OF INSERT PLATE - IP3
(SCALE 1:10)

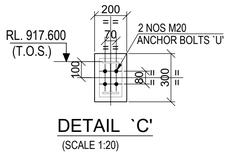

DETAIL `C`
(SCALE 1:20)

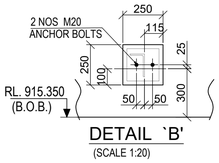


DETAIL `B`
(SCALE 1:20)

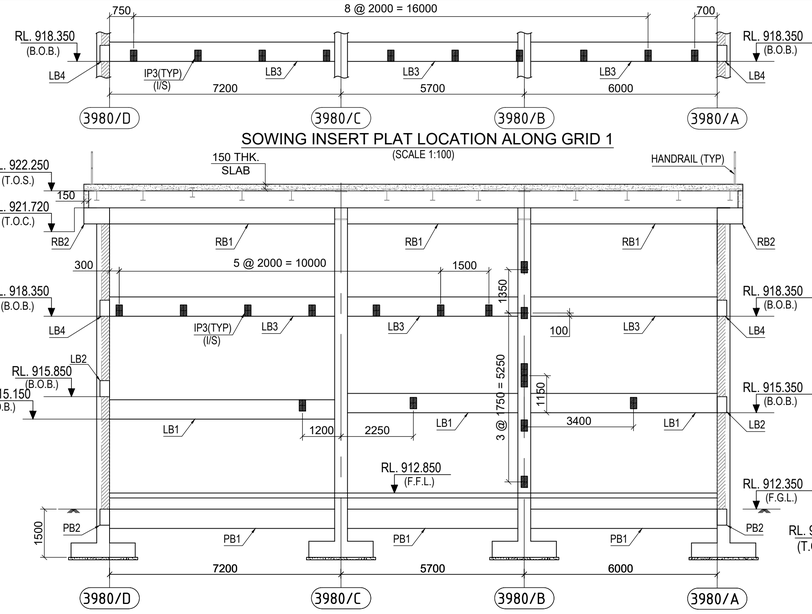


SOWING INSERT PLAT LOCATION ALONG GRID 1
(SCALE 1:100)


ELEVATION ALONG GRID 4
(SCALE 1:100)

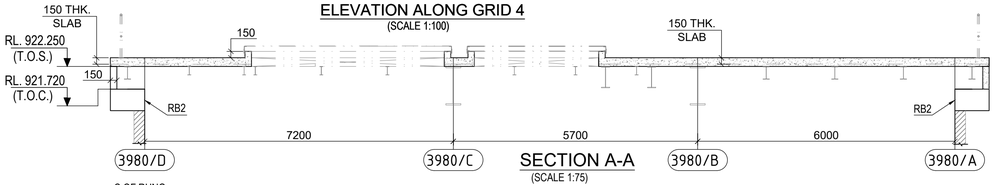


SECTION A-A
(SCALE 1:75)

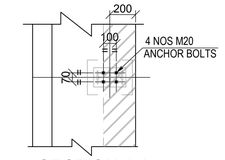


SECTION J-J
(SCALE 1:25)

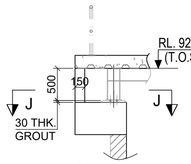


SECTION H-H
(SCALE 1:50)

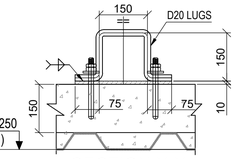


SECTION X-X
(SCALE 1:10)

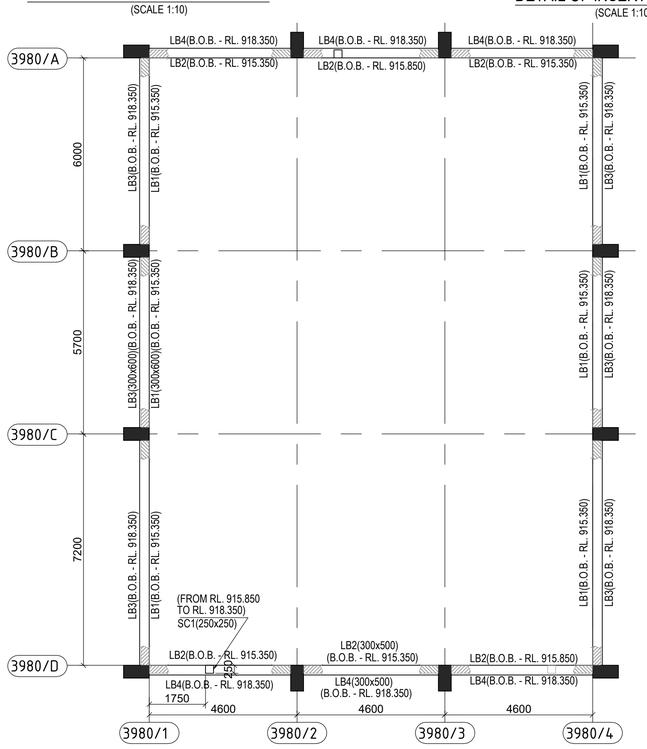


LINTEL BEAM PLAN
(SCALE 1:100)

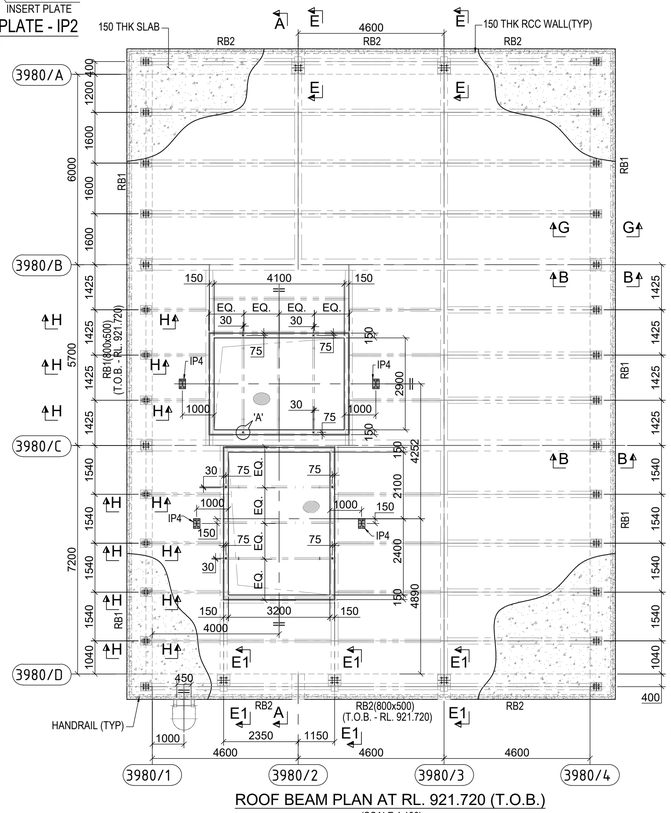


ROOF BEAM PLAN AT RL. 921.720 (T.O.B.)
(SCALE 1:100)

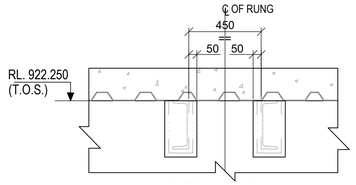


DETAIL `D`
(SCALE 1:20)

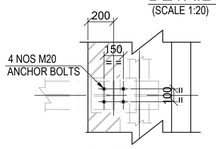


SECTION F-F
(SCALE 1:25)

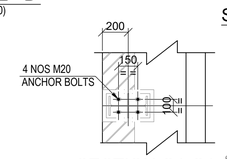


SECTION G1-G1
(SCALE 1:25)

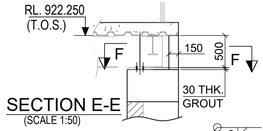


SECTION E-E
(SCALE 1:50)

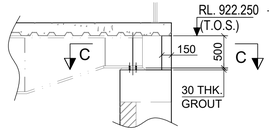

SECTION B-B
(SCALE 1:50)

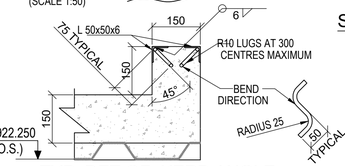

TYP. DET.OF KERB ANGLE (FOR CUTOUT LOCATION)
(SCALE 1:10)

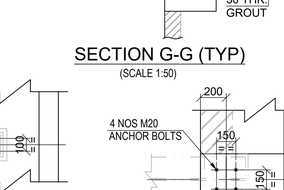


SECTION G-G (TYP)
(SCALE 1:50)

SECTION E1-E1
(SCALE 1:50)




SECTION F1-F1
(SCALE 1:25)

SECTION C-C
(SCALE 1:25)

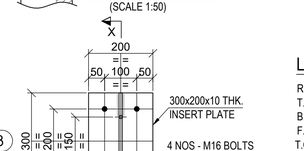

DETAIL OF INSERT PLATE - IP4
(SCALE 1:10)

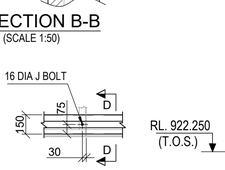

DETAIL `A`
(SCALE 1:25)

SECTION D-D
(SCALE 1:25)

LEGEND :-

R.L. - REDUCED LEVEL
T.O.C. - TOP OF CONCRETE.
B.O.B. - BOTTOM OF BEAM
F.G.L. - FINISHED GROUND LEVEL
T.O.S. - TOP OF STEEL.
P.C.C - PLAIN CEMENT CONCRETE
MKD. - MARKED.
THK. - THICK
Ç - CENTER LINE
PL. - PLATE
TYP. - TYPICAL.
I/S - INNER SIDE
O/S - OUTER SIDE

NOTES :-

1. ALL DIMENSIONS ARE IN MILLIMETRES AND LEVELS AND CO-ORDINATES ARE IN METRES. UNLESS OTHERWISE STATED.
2. GRADE OF CONCRETE SHALL BE C35.
3. GRADE OF REINFORCEMENT SHALL BE DEFORMED BAR ASTM A615 - GRADE 60 (fy = 420 MPa).
4. NET SAFE BEARING CAPACITY OF SOIL AT BOTTOM OF FOUNDATION CONSIDERED 670KN/SQ. M.
5. IF ANY PART OF FOUNDATION COMES ON BACKFILL ZONE OF ADJACENT FOUNDATION OR ANY LOOSE PACKETS ARE ENCOUNTERED BELOW FOUNDATION LEVEL THE SAME SHALL BE REMOVED AND FILLED WITH PCC.
6. THIS DRAWING IS READ IN CONJUNCTION WITH DRG. NO : MD-216-3980-EG-CV-GAD-1468.
7. FOR REINFORCEMENT DETAIL REFER DRG. NO : MD-216-3980-EG-CV-DED-1471.
8. FOR BOLT DETAILS REFER DRG. NO : MD-216-1000-EG-CV-DED-1003.
9. FOR GENERAL NOTE FOR CIVIL WORK REFER DRG. NO : MD-216-1000-EG-CV-DED-1001.

DOCUMENT NUMBER	REFERENCE DOCUMENTS	REV	DATE	REVISION DESCRIPTION	DRN	CHK	ENG	APP	EMP
MD-216-3980-EG-ST-GAD-2389	COMPPESSOR ROOM PLAN ELEVATION & DETAILS	D01	22/02/2023	AS-BUILT	SBH	BDA	SUE	AG	
MD-216-3980-EG-ST-GAD-V551-1489	GUIDE DRAWING COMPPESSOR ROOM (SHT 3 OF 3)	C03	04/03/2021	ISSUED FOR CONSTRUCTION & REVISED AS MKD.	SBH	BDA	SUE	AG	
MD-216-3980-EG-ST-GAD-V551-1488	GUIDE DRAWING COMPPESSOR ROOM (SHT 2 OF 3)	C02	07/01/2021	ISSUED FOR CONSTRUCTION & REVISED AS MKD.	SBH	BDA	SUE	AG	
MD-216-3980-EG-ST-GAD-V551-1477	GUIDE DRAWING COMPPESSOR ROOM (SHT 1 OF 3)	C01	16/07/2020	ISSUED FOR CONSTRUCTION	SBH	BDA	SUE	AG	
MD-216-3980-EG-PI-PPD-V551-1001	OXYGEN PLANT PLOT PLAN	A01	23/06/2020	ISSUED FOR REFERENCE	SBH	BDA	SUE	AG	

RESERVED FOR VENDOR LOGO AND DRAWING NUMBER

LARSEN & TOUBRO DRAWING NUMBER: O19045_080_C_G_24197_002 | REVISION: 4

OUTOTEC DRAWING NUMBER: 900707__GAU01__AG22__MTL01__39836 | DOCUMENT ID: OU100687634 | REVISION: 4

LARSEN & TOUBRO
This drawing is the property of LARSEN & TOUBRO and must not be passed on to any person or body not authorized by us to receive it nor be copied or otherwise made use either in full or in part by such person or body without our prior permission in writing.

Outotec
The content of these documents are the sole property of Outotec Oyj. Any rights not expressly granted herein are reserved. Reproduction, transfer or distribution of part or all of the contents in any form without prior written permission of Outotec is prohibited.

MA'ADEN معادن
Saudi Arabian Mining Company شركة التعدين العربية السعودية
This document and the information contained herein is Ma'aden proprietary know-how. This document or any part thereof should not be reproduced, stored in a retrieval system or transmitted by any means, electronic or otherwise, or divulged without prior written permission of Ma'aden.

DRAWN	SBH	20/06/2020	MANSOURAH - MASSARAH GOLD PROJECT
CHECKED	BDA	22/06/2020	GENERAL ARRANGEMENT DRAWING
ENGINEER	SUE	20/06/2020	OXYGEN PLANT
APPROVED	AG	23/06/2020	COMPRESSOR ROOM PLAN, SECTIONS & DETAILS
EMPLOYER			
SCALE	1:100, 1:75	A1	DRAWING NUMBER: MD - 216 - 3980 - EG - CV - GAD - 1469 | REV: D01